



31 AUG 2011

Bygging  
E.h. Sigurður

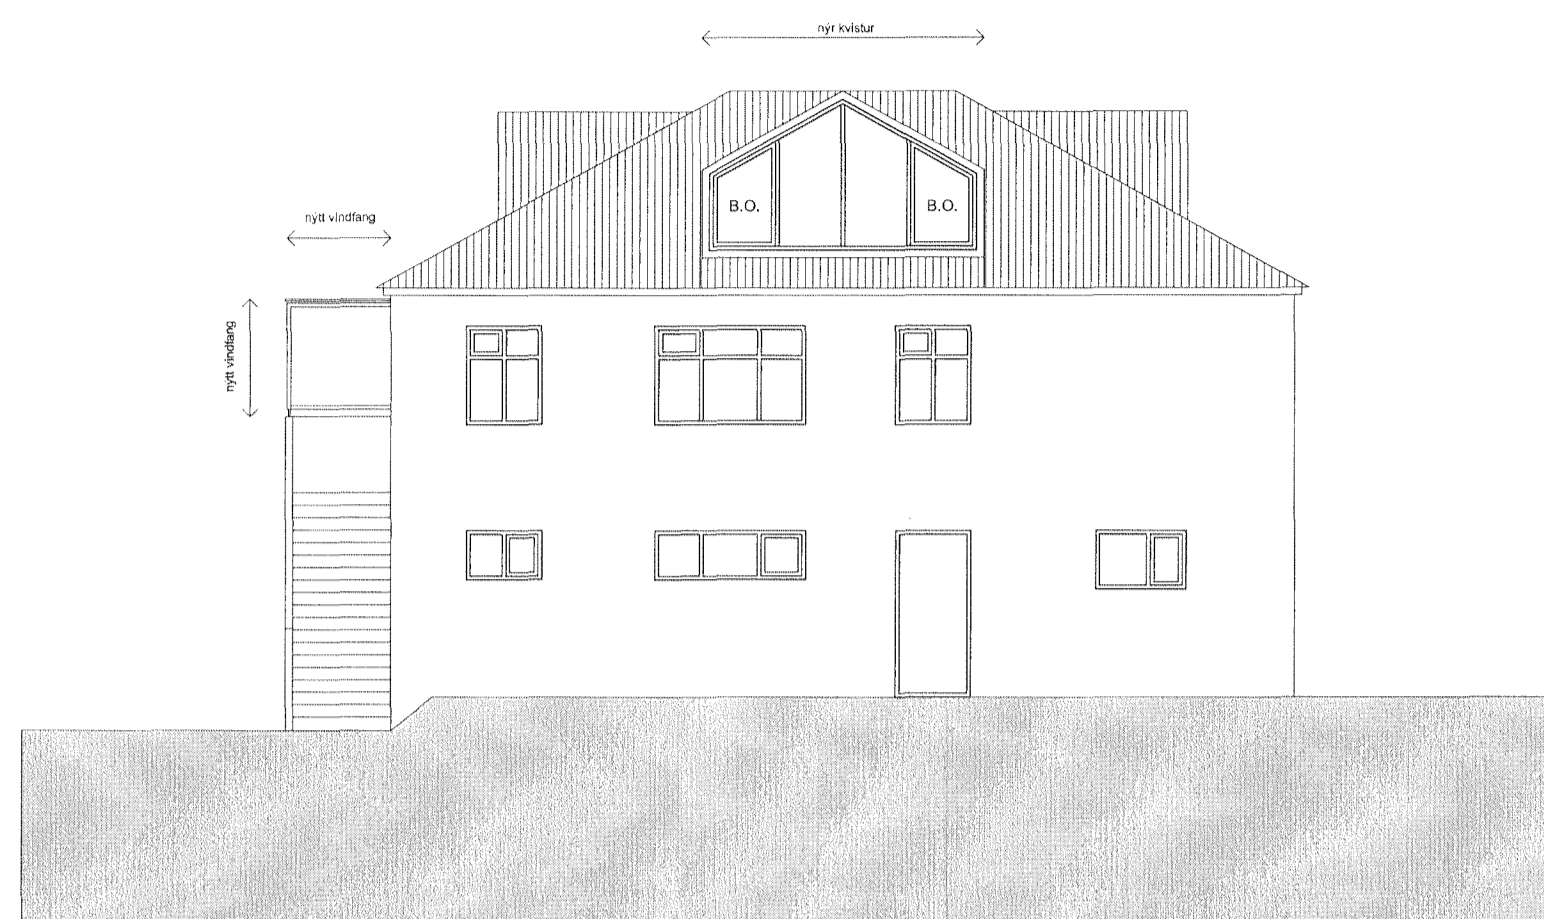


útlit austur

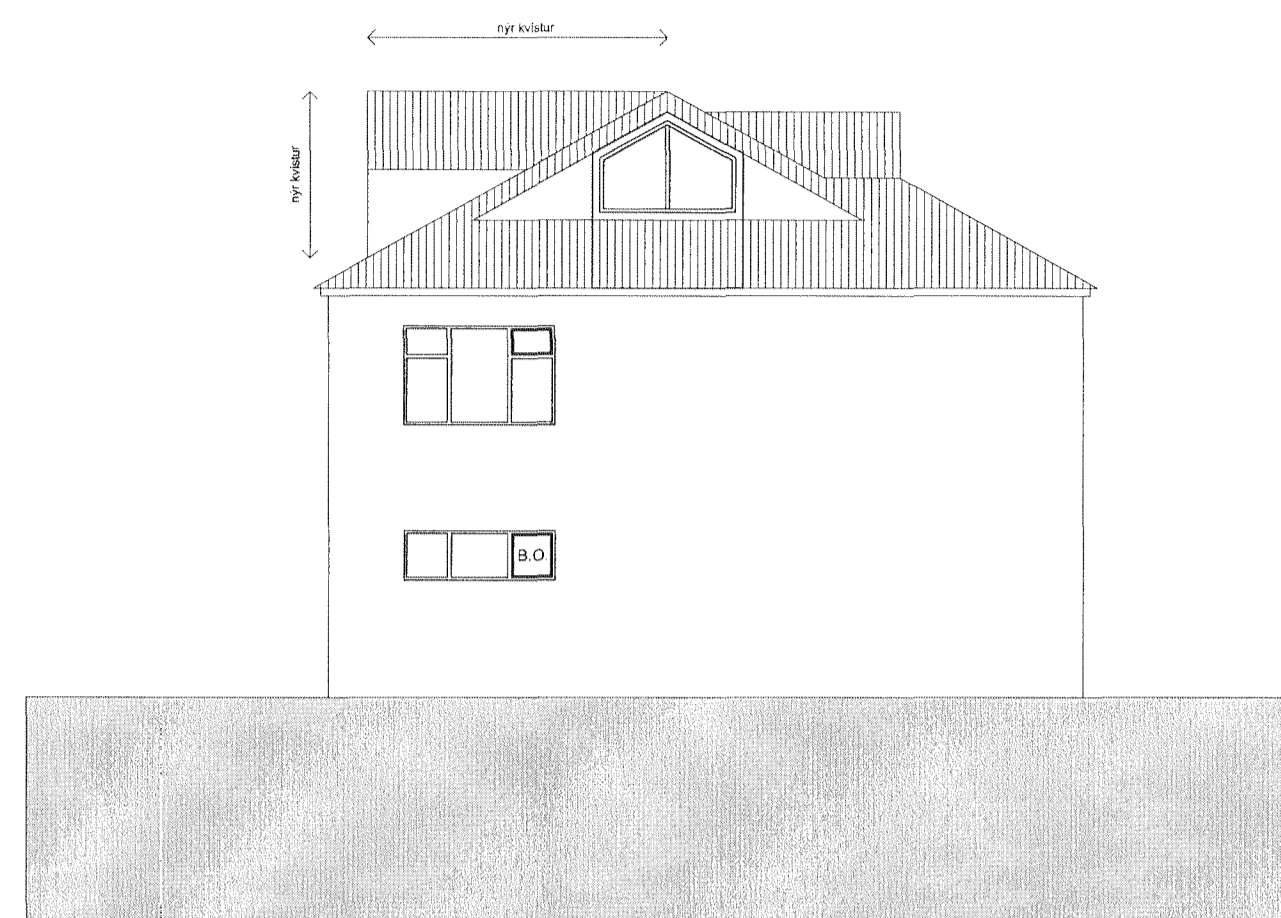

útlit norður



útlit vestur

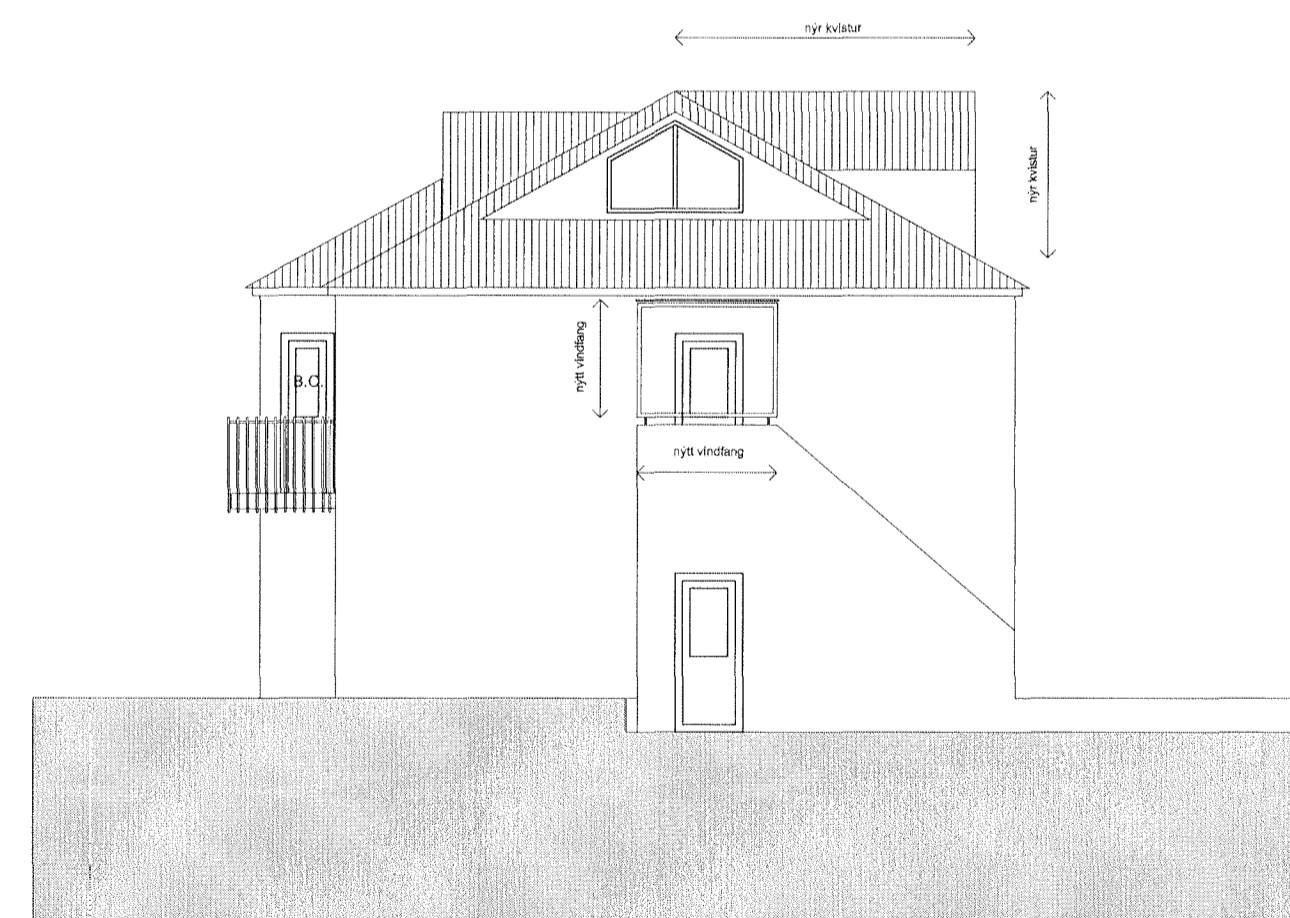

útlit suður

BREYTINGAR.

VERKHEITI

## Hraunkambur 9

VERK  
Útlit

MÁL  
1:100  
HANNAD  
ÁJS  
YFIRFARIÐ:  
ÁJS  
VERKNÓMÉR  
09.11

DAGS.  
03.05.2011  
TEIKNAD  
ÁJS

TEIKNINGANÓMÉR  
1.2

ÁRNI JÓN SIGFÚSSON ARKITEKT

FRIGGJARBRUNNI 35 - 113 REYKJAVÍK  
SÍMI / NETFANG: 5650076 - sigfusson@simnet.is  
Kt. 220169-2949

*Arni Jón Sigfusson*

SAMP.