
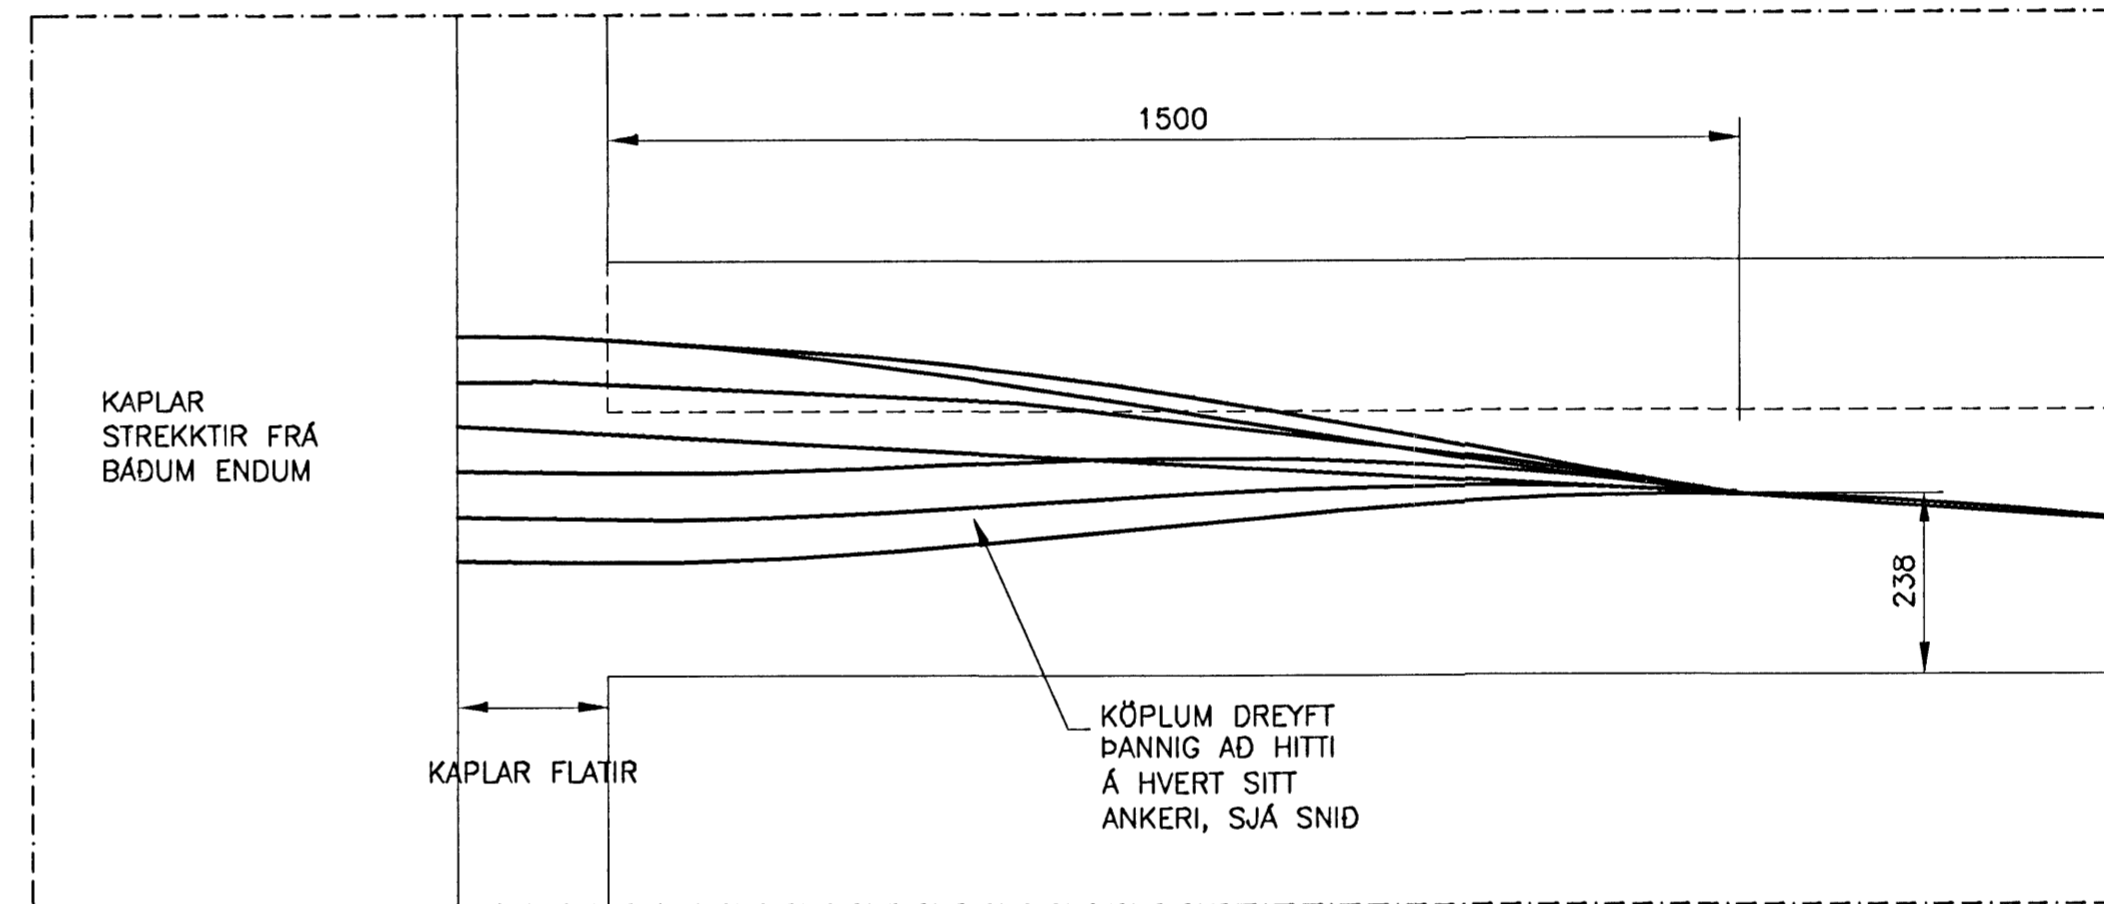


FJARLEGD FRÁ NEDRI BRÓN
PLÖTURIFS AD MIDJU
KAPALBÓNTS


214 172 136 107 84 68 58 55 58 68 84 107 136 172 214

**R1 OG R2- ÁSÝND PLÖTURIFA OG KAPALLEGA
HORFT FRÁ SUDRI TIL NORDURS
MKV. 1**

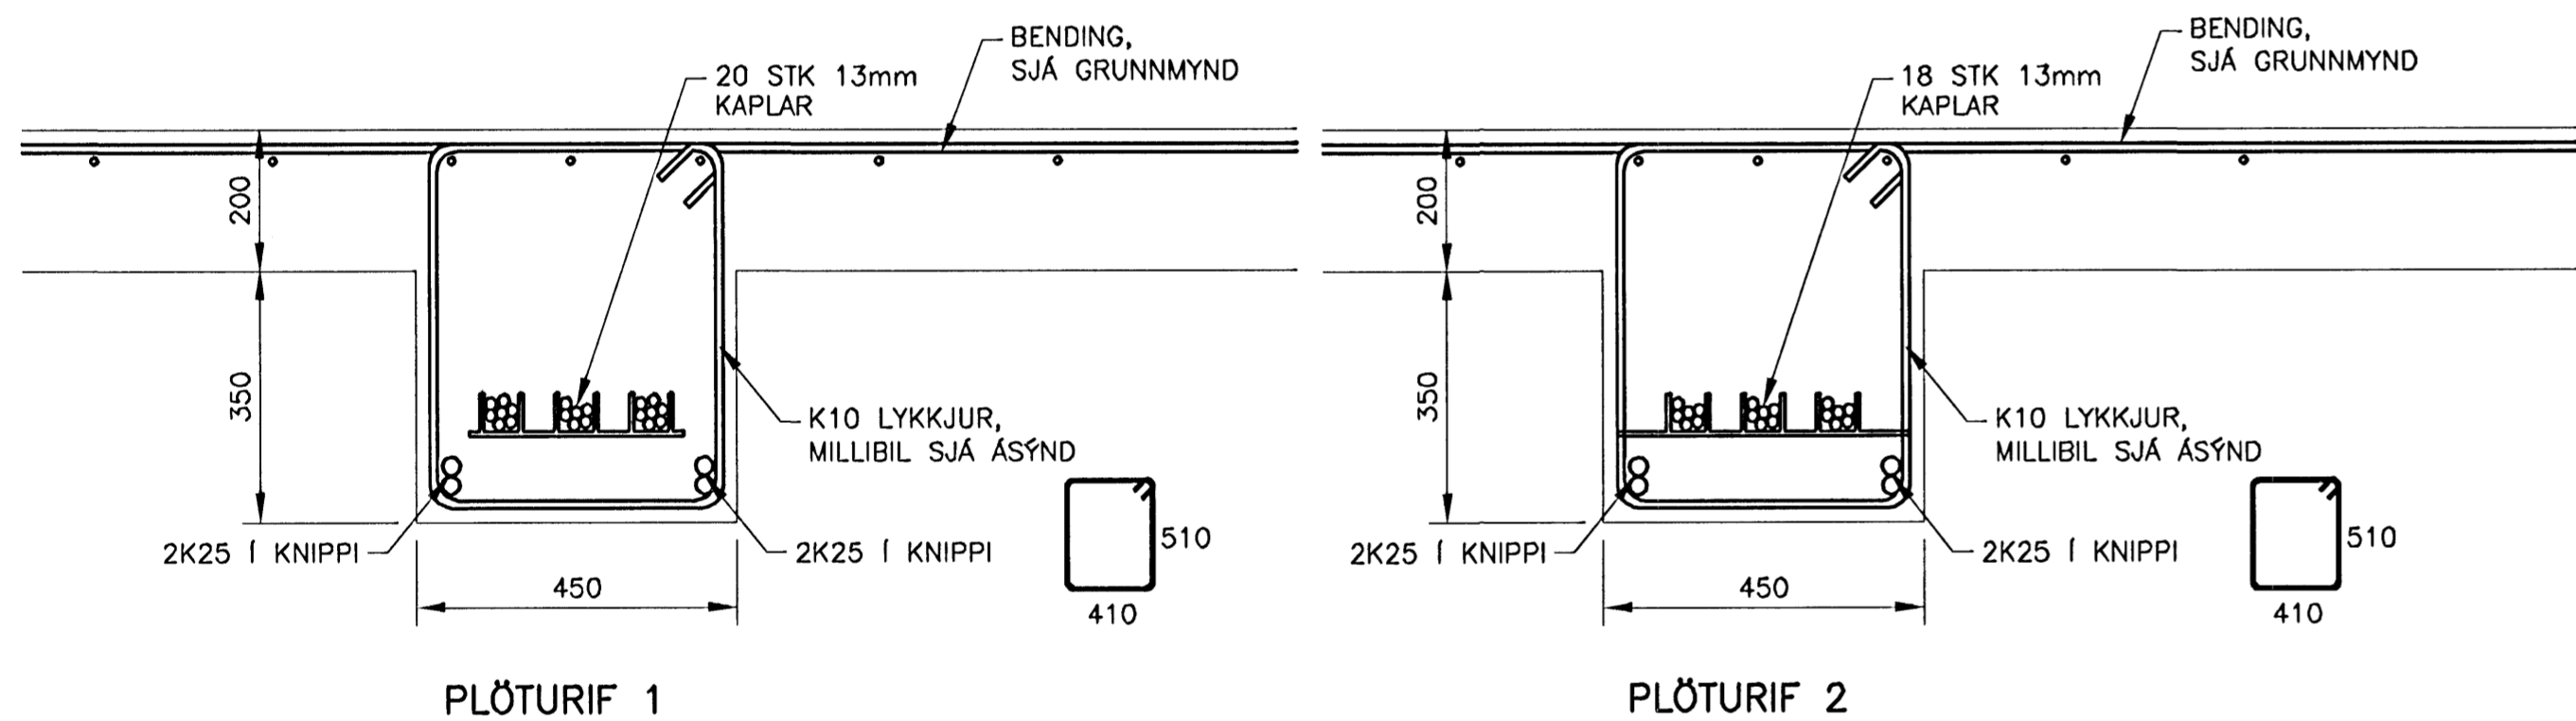

B DEILI
MKV. 2


A SNID
MKV. 2

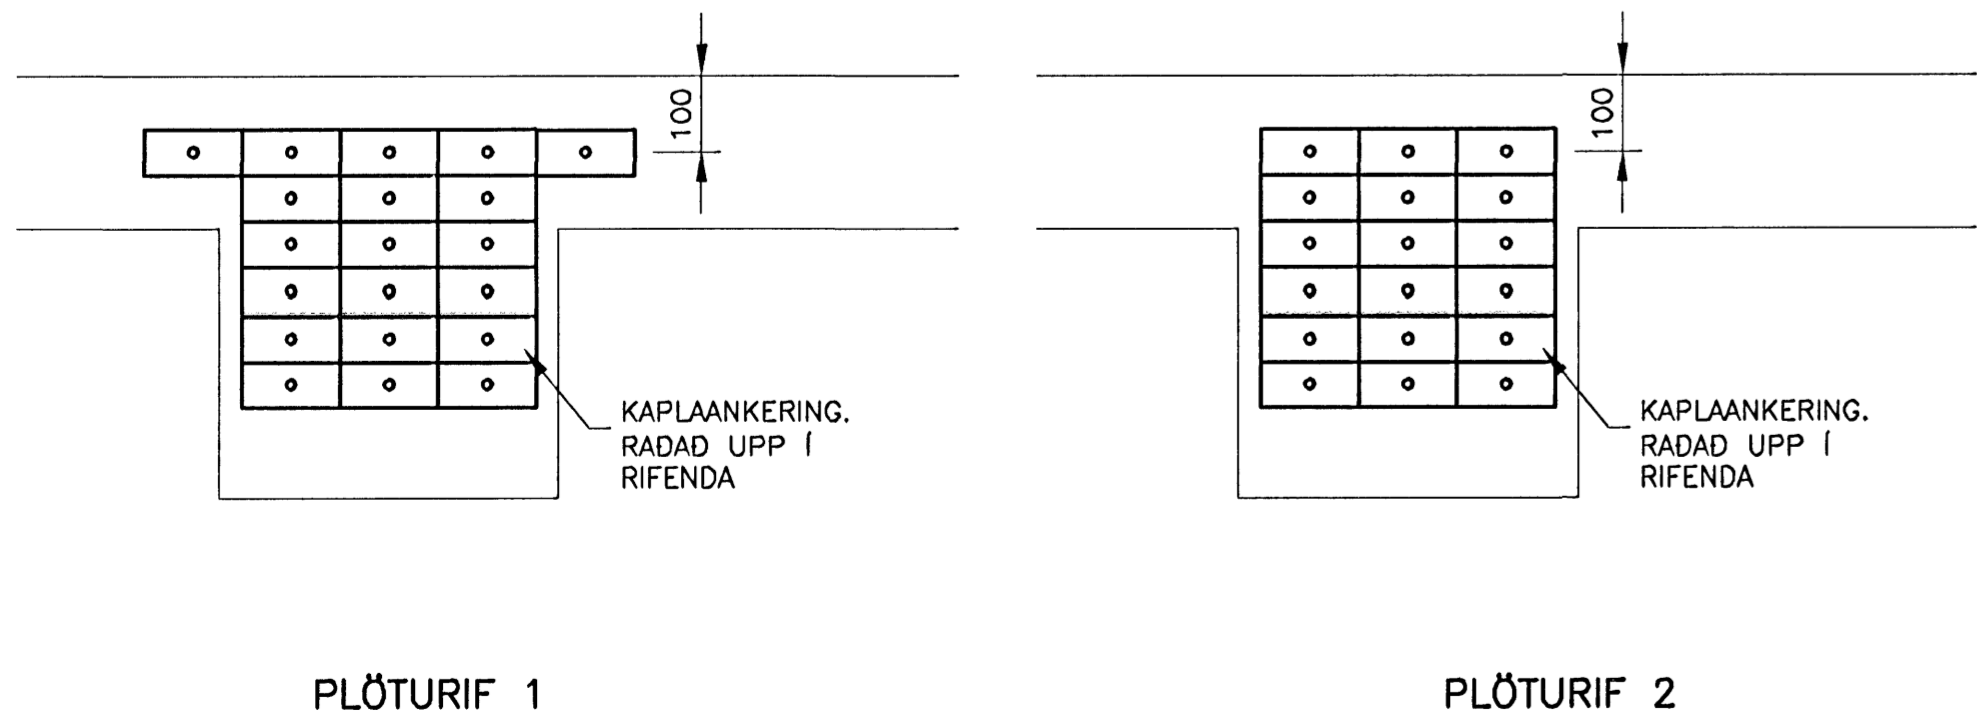


PLÖTURIF 1

PLÖTURIF 2

C SNID
MKV. 2

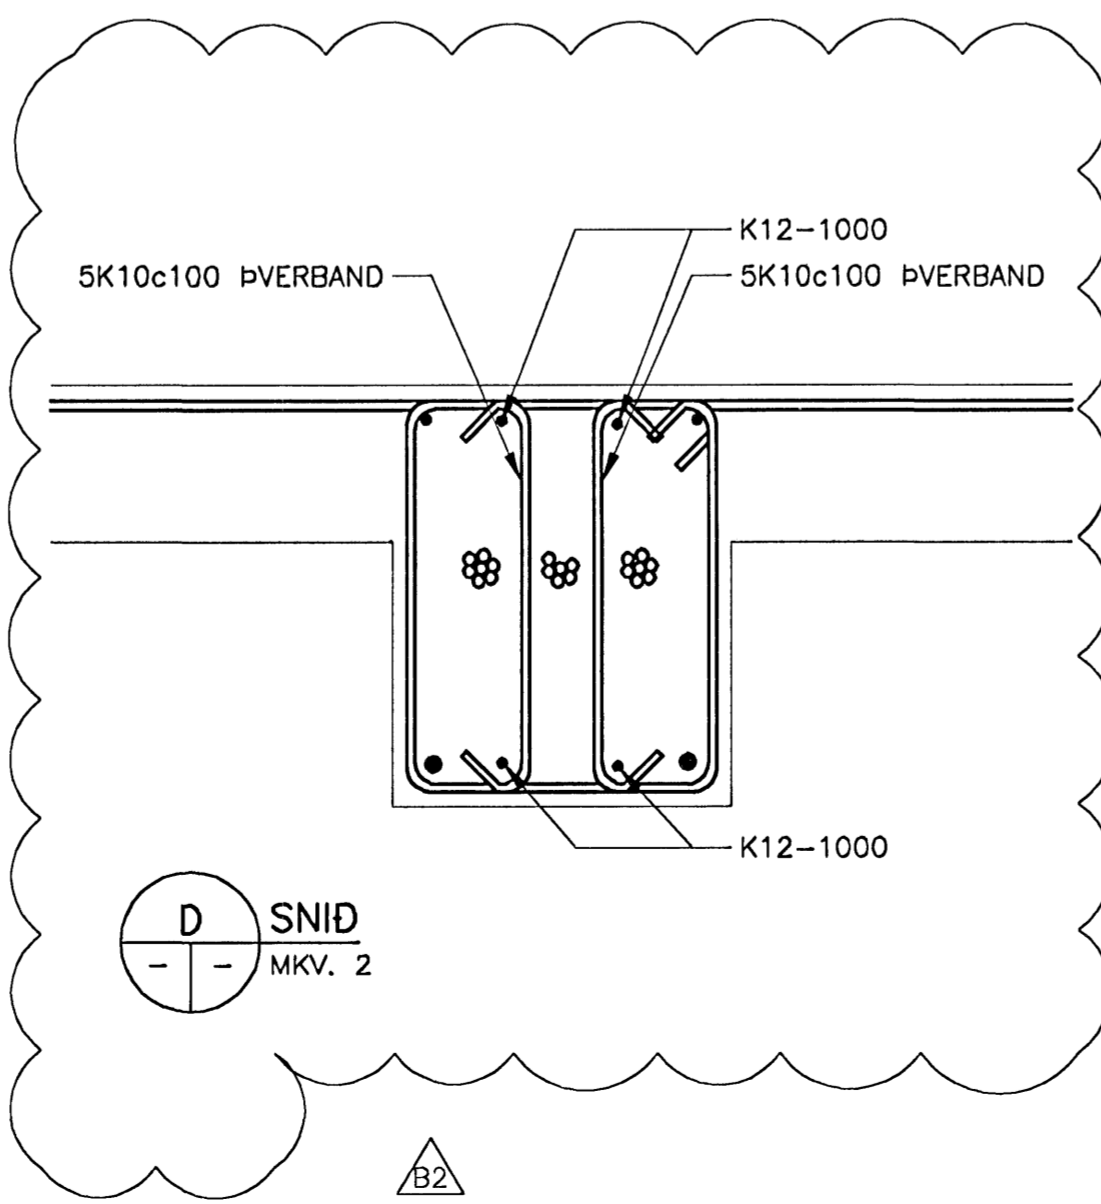

D SNID
MKV. 2


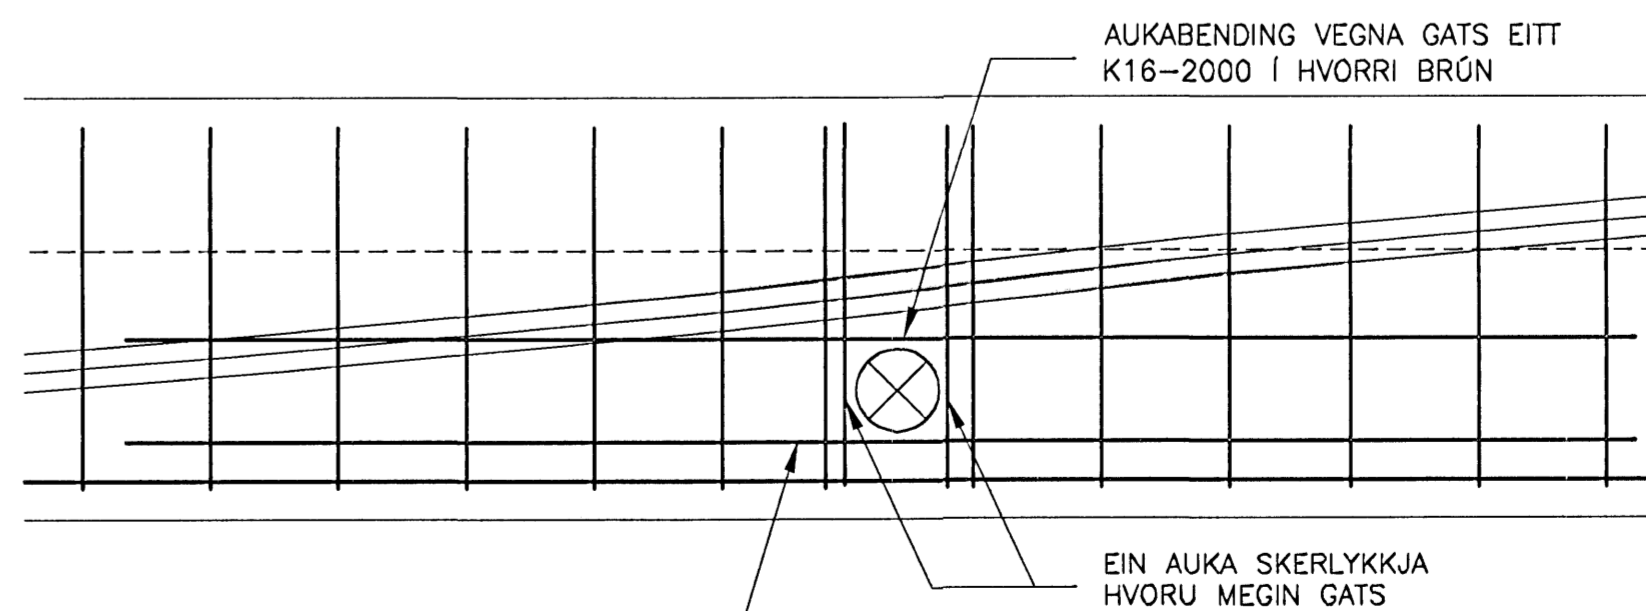


AUKABENDING VEGNA GATS EITT
K16-2000 I HVORRI BRÓN

**DÆMIGERÐUR FRÁGANGUR KRINGUM GÖT
MKV. 2**

ÓTGÁFUFRILL			
NR.	DAGS.	SKYRINGAR	HANNAÐ
B1	03.08.2005	BYGGINGARTEIKNING	PG
B2	04.10.2005	JÄRNUM BETT VID	PG

DAGS. UNDRISKRIFAR: NAFN OG KT. SAMREINGINGARHÖNDUÐAR:
UNDRISKRIF SAMREINGINGARHÖNDUÐAR:

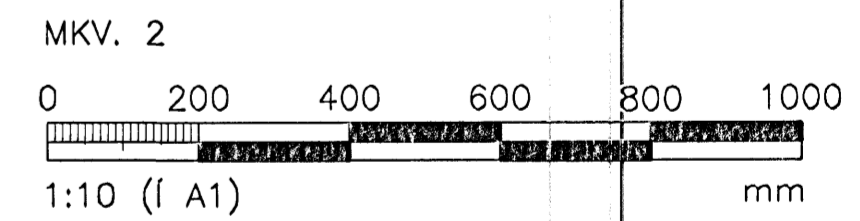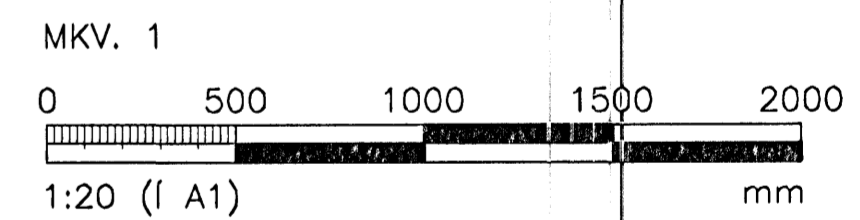

ÖLL AFNOT OG AFRITUN TEIKNINGAR, AD HLUVA EDA HEILD, ER HAÐ SKRIFLEGU LEYFI HÖFNUNDA.

HÖNNUN
GRENSÁSVEGI 1 108 REYKJAVÍK SÍMI: 510 4000 FAX: 510 4001
VEFFANG: www.honnun.is NETFANG: honnun@honnun.is

HRAUNVALLASKÓLI
DREKAVELLIR 9, HAFNARFIRÐI

HEITI TEIKNINGAR: **BURÐARVIRKI**
EFTIRSPENNT PLÖTURIF
R1 OG R2

MELTI:	TEIKNAD:	LS	GEYMSLUNUMER:	VNR:
HANNAÐ:	YFIRFARÐ:	JCC	MKV:	NR. TEIKNINGAR:
DAGS. UNDRISKRIFAR:	NAFN OG KT. HÖNNUÐAR:	4/16 05	430572-0169	B1-525
UNDRISKRIF HÖNDUÐAR:	HÖNNUN hf	430572-0169	ÓTGÁFA:	B2