


ÁRITUN SAMRÆMINGARHÖNDLUNAR

BATTERI
04.05.09

TILVÍSANIR:
ALMENNAR SKÝRINGAR SJÁ BL. NR. R-A-01

B 24.03.2009 REYNDARTÆKING JJ LL
A 11.01.2008 TÝSAR BREVINGAR JJ VOG
BR. DAGS BREVING REIKN TEIKN

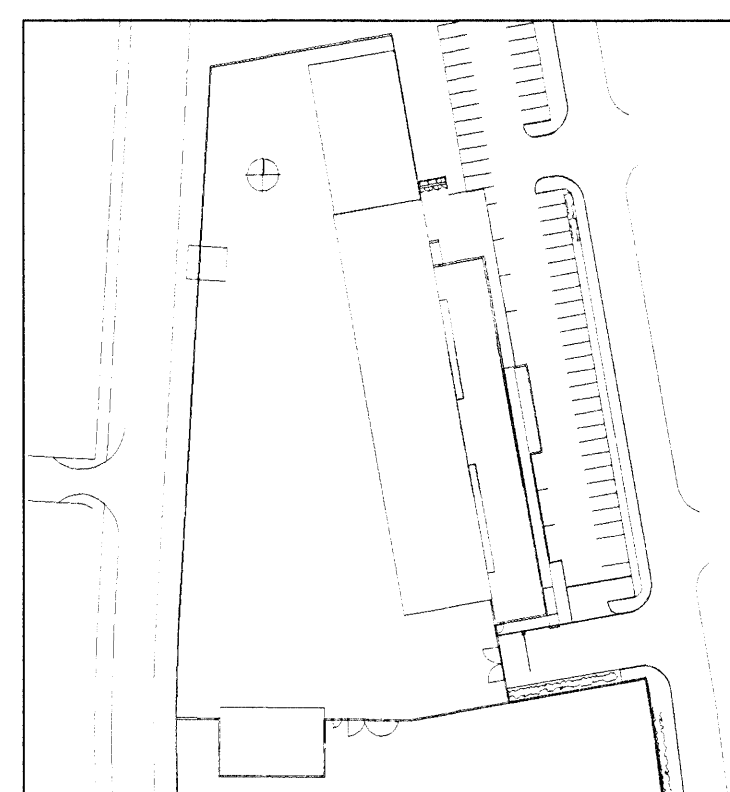

VSÓ
BORGARTUN 20, 108 REYKJAVÍK, SMÍ 585-9000, SMARPEF 585-9010, NETFANG 585-9010

FRAMKV/EMDASVIÐ HAFNARFJARÐAR

RAKFERFI LÁSGPENNNA GRUNNMYND 1. HÆÐ	HANNA/TEIKN VFRABÍÐ SANDÞYKKT AT	EA/SG-MOG EA Síman Umráðgjafi 1103867789
KLIAÐ: 1:50 / A1	TEIKN NR	REIKNVAKI
VERUR: 07102	TEIKN NR R1-G1-02	BR B