


ARITUN SAMRÆMINGARHÖNDUÐAR

3.11.2008
0651
SÁM
04.05.08

TILVÍSANIR:
ALMENNAR SKÝRINGAR SJÁ BL. NR. R-A-01

B	26.03.2009	REYNDARTEIKNING	LL
A	11.01.2009	YMBÆAR BREYTINGAR	MOG
BR	DAGS	BREYTING	REIKN. TEIKN.

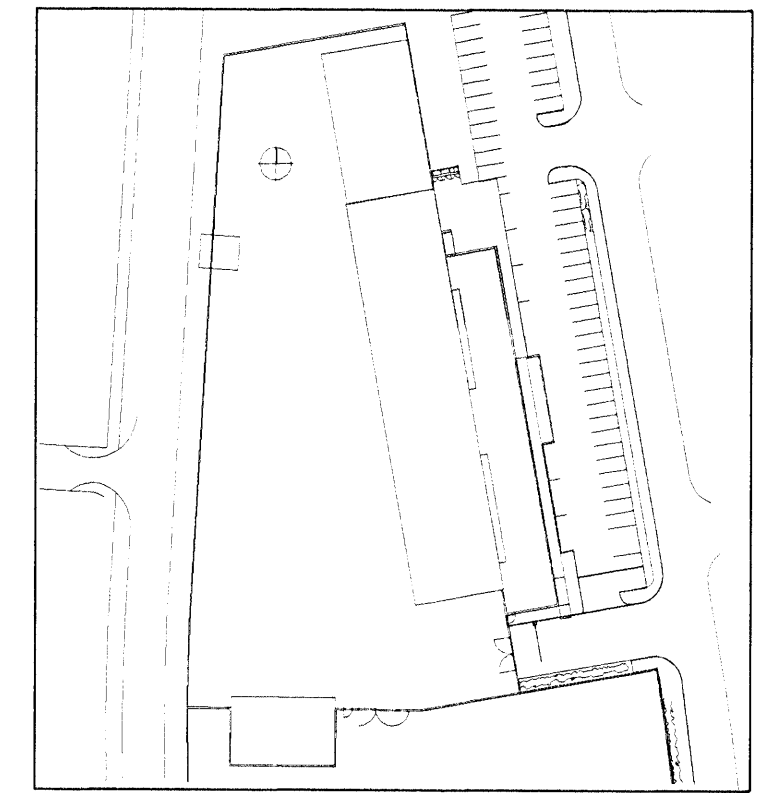

VSÓ
BORGARTÚN 20, 108 REYKJAVÍK, Sími 585 9000, Símanúmer 585 9010, netfang vs@vs.is

FRAMKVÆMDASVIÐ HAFNARFJARÐAR

RAFKERFI LÁGSPENNA GRUNNMYND 1. HÆÐ	HANUÐTEIKN YRFARID SAMVYKKA KT	ERKJ.MOG E Símanúmer 585 9010 110356-7769 11.12.2007
KVARD: 1.50/A1 VERKUR	TEIKN N/R REYKJAVÍK	BR
07102	R1-G1-03	B