

2/3/03


ÁRTUN SAMRÆMINGARHÖNDUNAR

SAFERIHL
 ROST
 01.05.03

TILVÍSANIR:

ALMENNAR SKÝRINGAR SJÁ BL. NR. R-A-01

A.	BR.	DAÐS	BREYTING	REIKN.	TEIKN.
A.	28.03.2009	REYNDARTEIKNING		JJ	LL

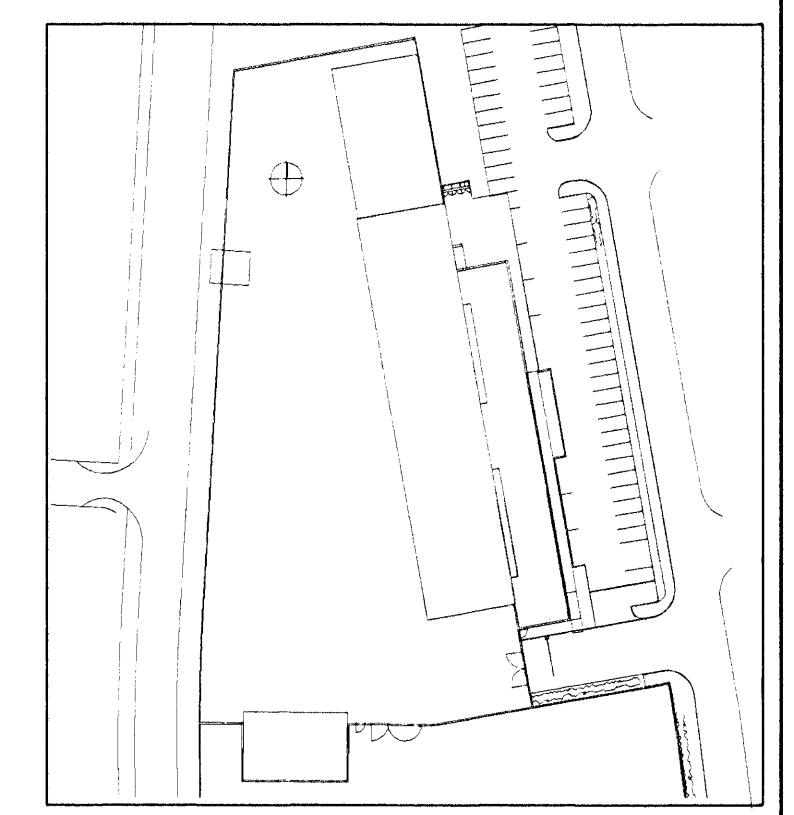

VSÓ RÁÐGJAFI

BRIGGARTUN 20, 105 REYKJAVÍK, Sími 585 9000, Símaheim 585 9010, Netfang vs@vs.is

FRAMKVÆMDASVIÐ HAFNARFJARÐAR

RAFKERFI	HANVAÐTEIKN	EAKG-MOG
INSTABUS	YFRARÁÐ	EA
GRUNNMYND 1. HÆÐ	SAMRYKKT	Símpr. Umh. 01/03/09
	KT	110556-7789

KVARDI: 1:50 / A1
 VERNUR: 07102
 TEIKN. NR.: R4-G1-01
 REYKJAVÍK: 11.10.2007
 BR: A