


ÁRITUN SAURMENGINGARHÖNDLUNAR

SAITERIIE  
Ólafur  
Sveinsson

TILVÍSANIR:  
ALMENNAR SKÝRINGAR ..... SJÁ BL. NR. R-A-01

A 28.03.2009 REYNDARTEKNING JJ LL  
BR DAGS BREYTING REKNI TEKNI

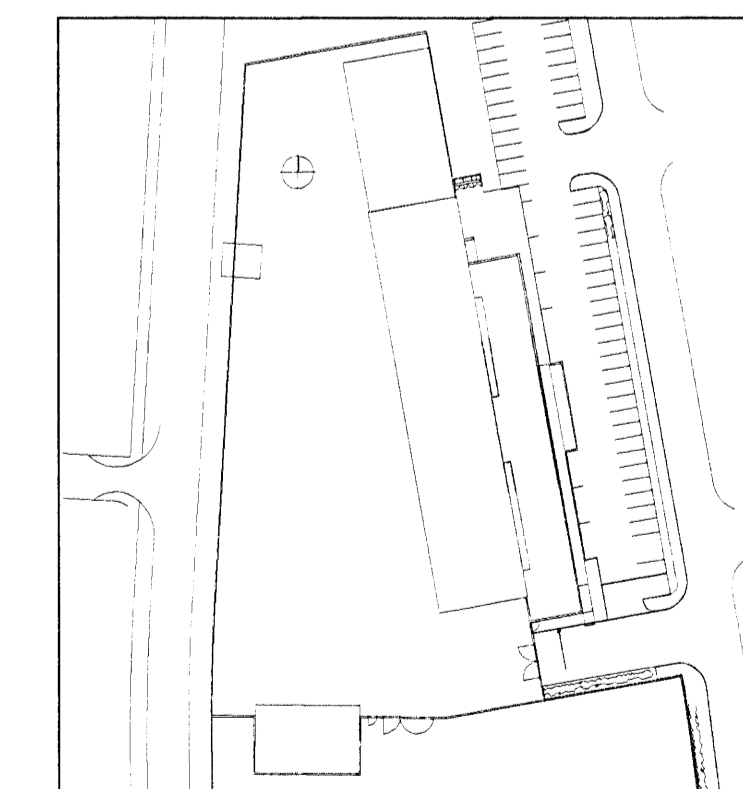

**VSÓ RÁÐGJÖF**  
BORGARTÚNI 20, 105 REYKJAVÍK, Sími 585 9000, SímaKEP 585 9010, netfang: vs@vs.is

FRAMKVÆMDASVIÐ HAFNARFJARÐAR

RAFKERFI  
INSTABUS  
GRUNNMYND 1. HÆÐ

HÁNNÓTEKNI  
EAKD-WOO  
VFIRKARE  
EA  
SAMSÝKKI  
Simon Unnþórunn  
KT. *Su* 110886-7769

SKVÆÐ: 1.50 / A1  
TEKNI NR.  
07102 R4-G1-02 A