


18/5/0

ARTUN SAMRÆMINGARHÖNDUÐAR

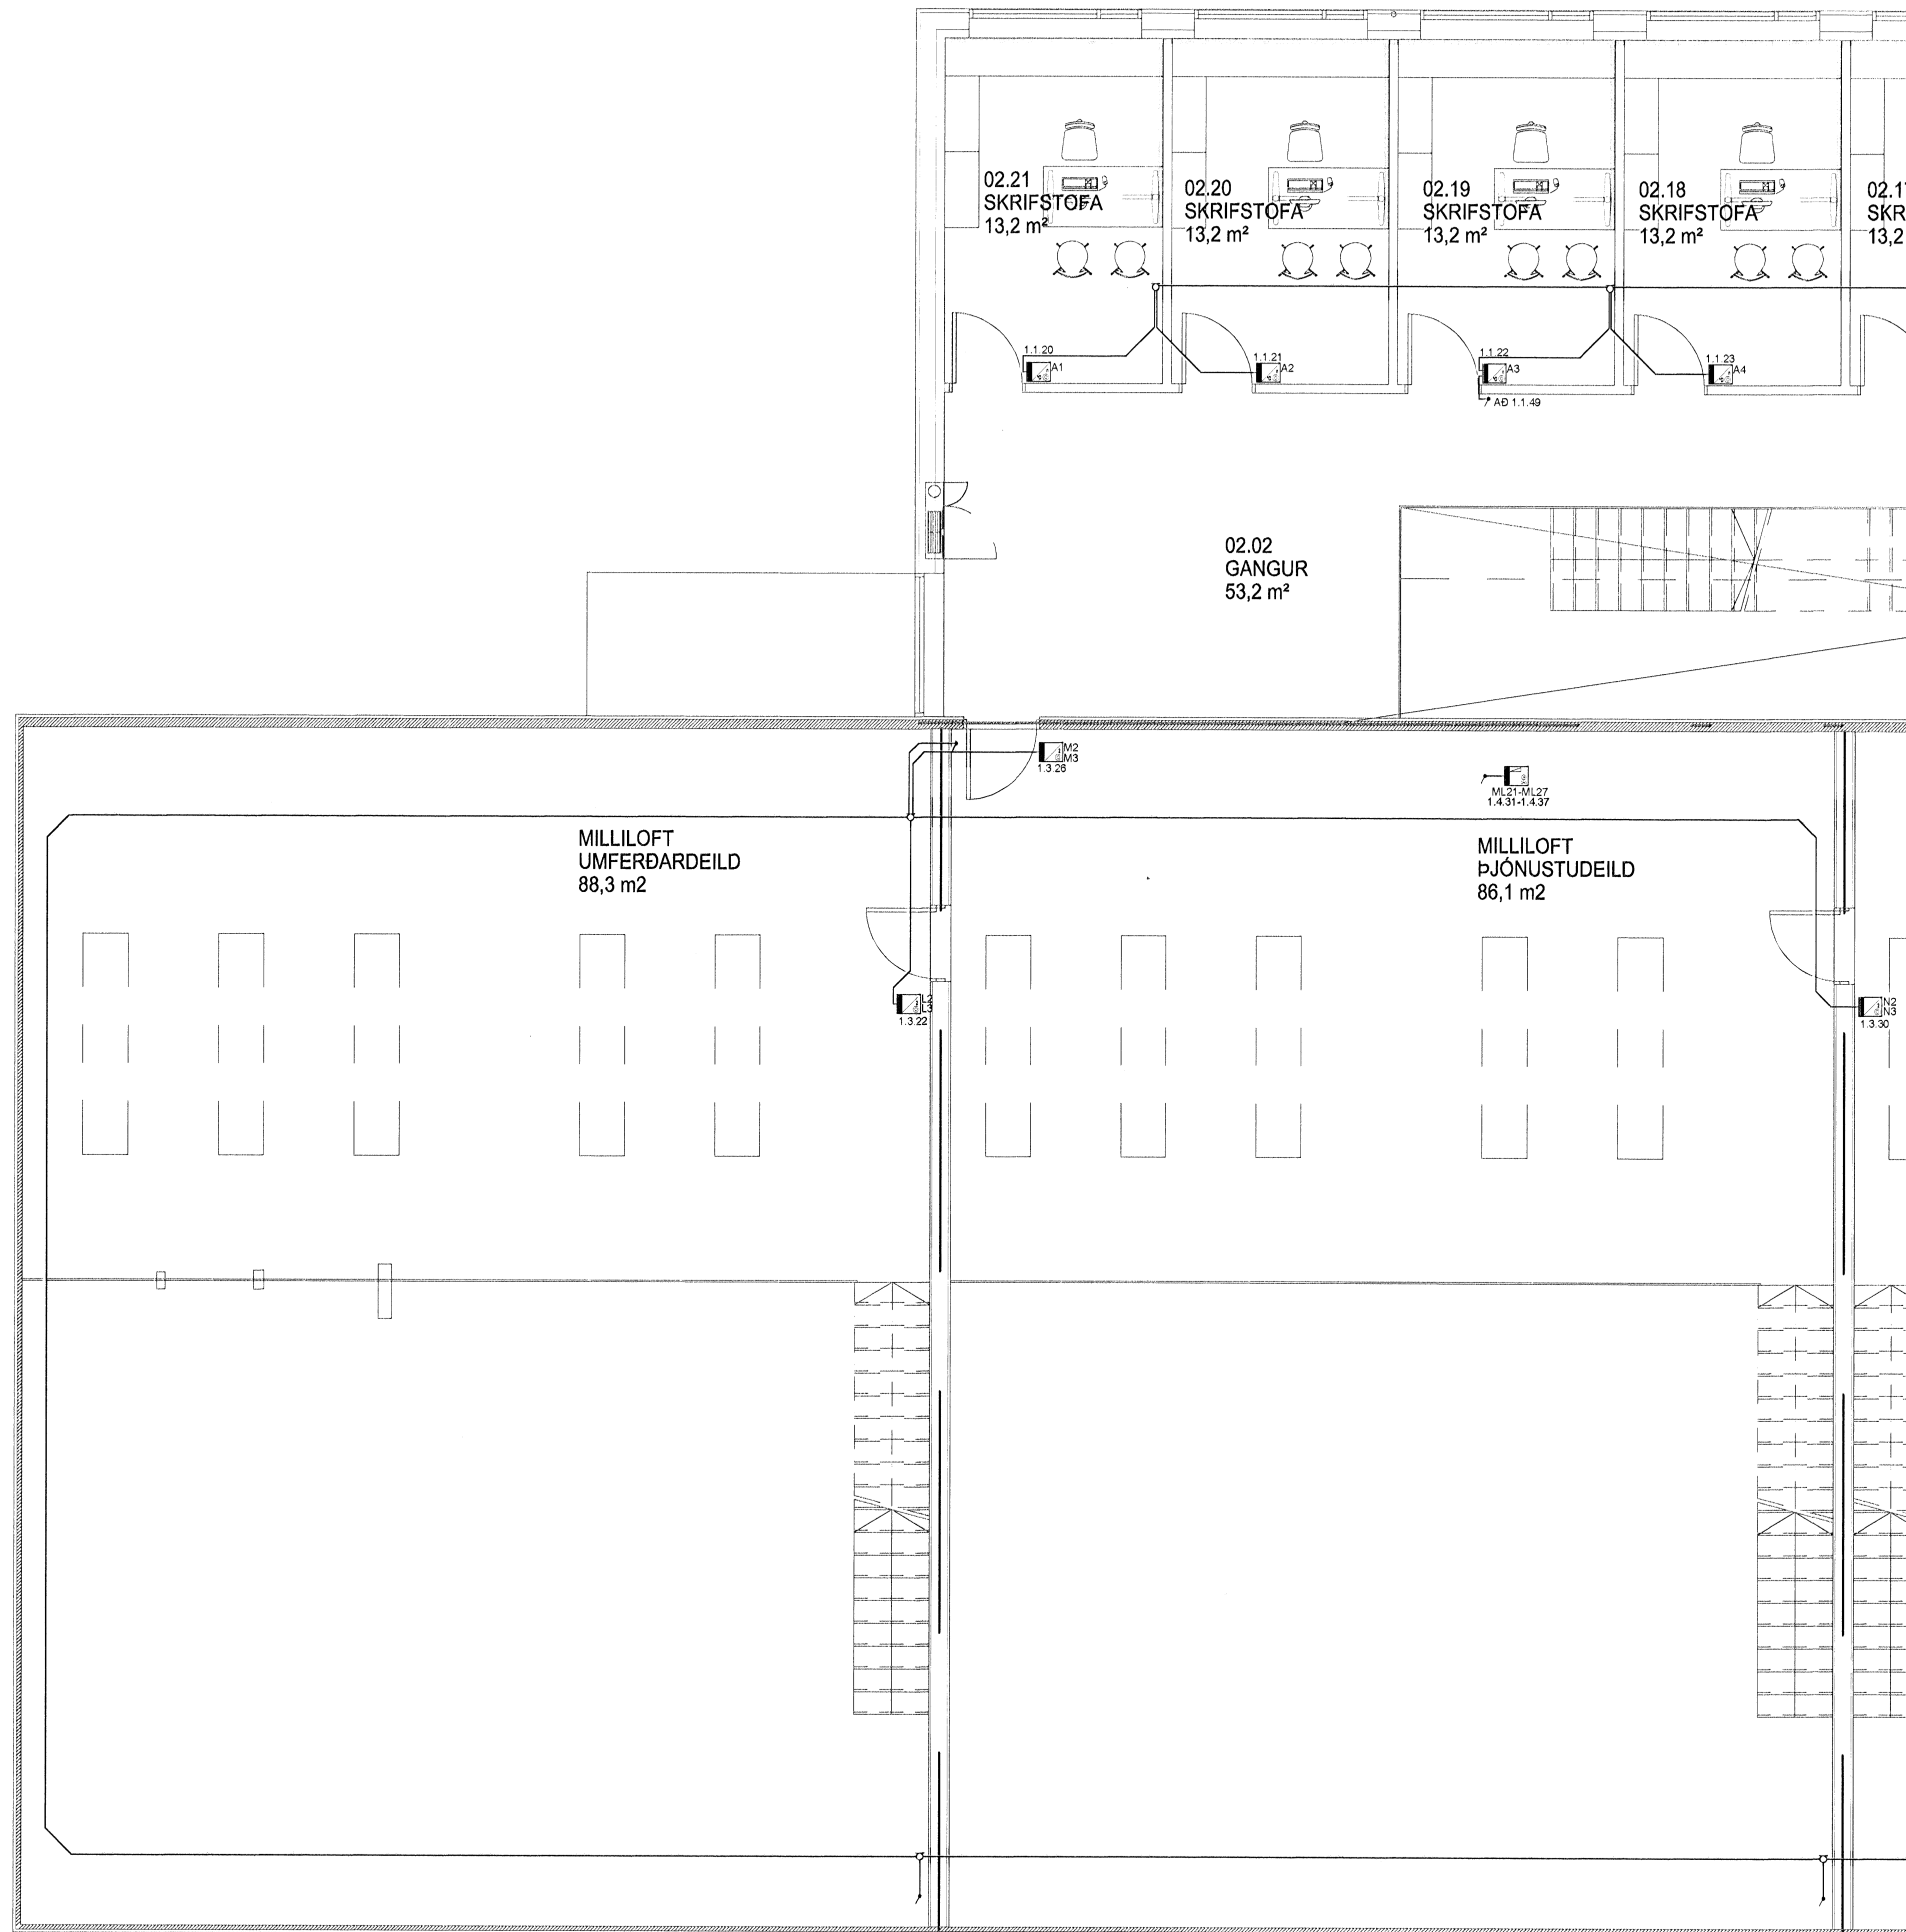


SAITERIIL  
06.07  
04.05.09

SIÁ TEKINGU R4-G2-02

TILVÍSANIR:

ALMENNAR SKÝRINGAR ..... SJÁ BL. NR. R-A-01

A	28.03.2009	REYNDARTEKING	JJ	LL
BR	CAD3	BREYTING	REKN	TEKN

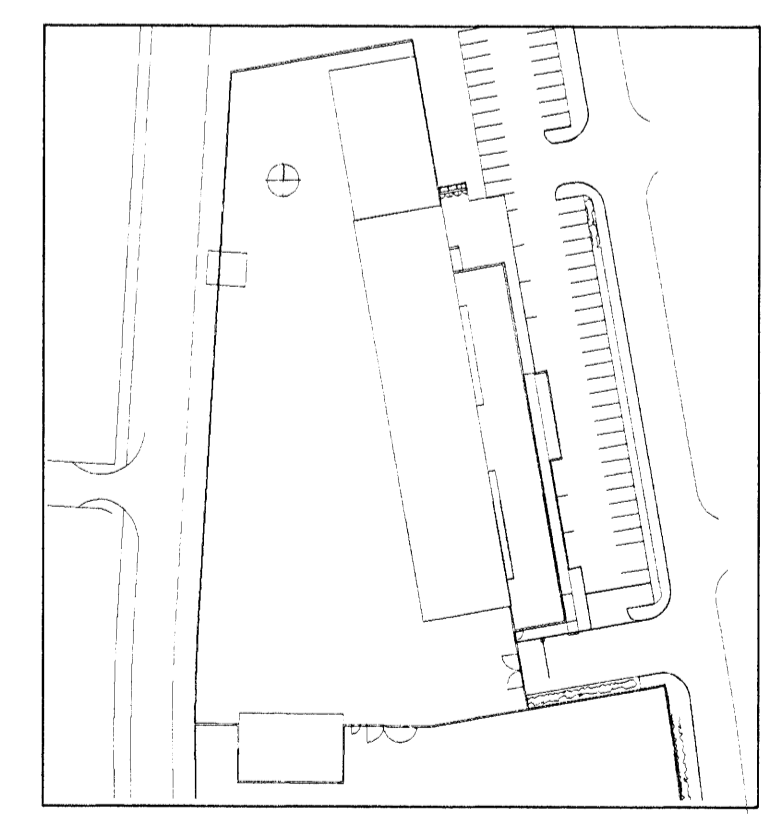

**VSÓ** RAÐGJÖF

BRAGARTUN 20, 105 REYKJAVÍK, Sími 585 9000, Símanúmer 585 9010, Netfang: ra@vsó.is

**FRAMKVÆMDASVIÐ HAFNARFJARÐAR**

RAFKERFI	HANUABYTEIN	SAKAD.MOÐ
INSTABUS	YRFARFAR	EA
GRUNNMYND 2. HÆÐ	SAMÞYKKT	Simon Unnthósson
	KT	110856-7789
KVARNUM: 1.50 / A1	REYKJAVÍK	11.12.2007
VERKNA	TEKNI. LIA	
07102	R4-G2-01	A