


ARITUN SAMRÆMINGAR-HÖNNUNAR

BATTERIÞ
 SKYGGI
 SKYGGI
 SKYGGI
 SKYGGI

B	28.03.2009	REYNDARTEKNIÐ	JJ	LL
A	11.01.2008	YMSAR BREVITAGAR	JJ	MOG
BR	2AGS	BREYTING	REKN	TEKN

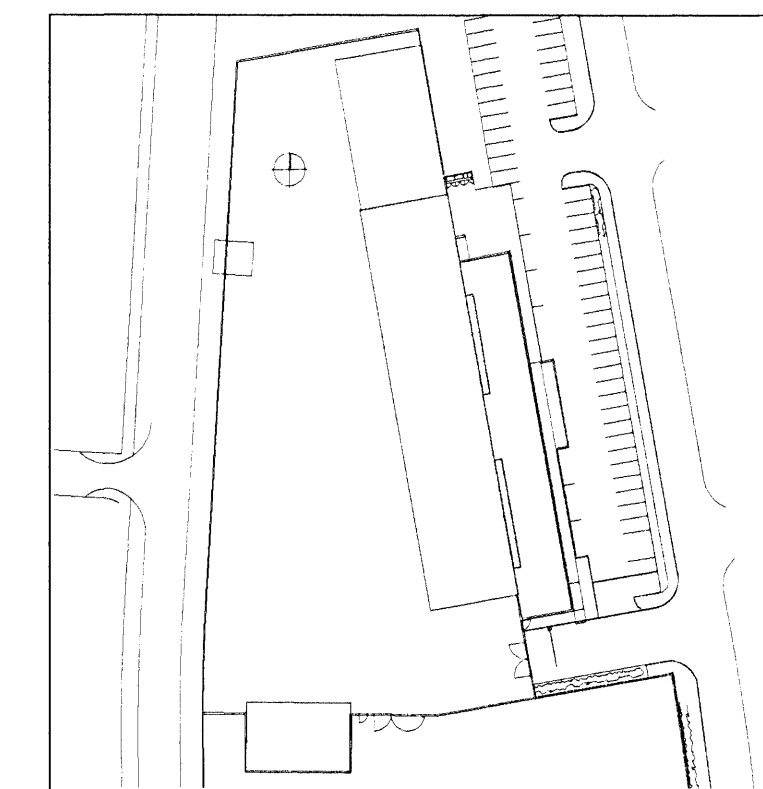

VSÓ RÁÐGJÖF
 BORGARTUN 25, 108 REYKJAVÍK, SM 248-9000, BSRÉF 565-6010, NETTANGI 440-9000

RAFKERFI	HANNAÐTEKN	JJAG-MOG
EINLÍNUNMYND	VEFARÁÐ	EA
ADALTAFLA T1.1	SKYGGI	SKYGGI
KLÍÐI: A1 / -	REYKJAVÍK	11.10.2007
VERUR	TEKN NR	BR
07102	R1-EA-02	B