




GREINATAFLA T1.3

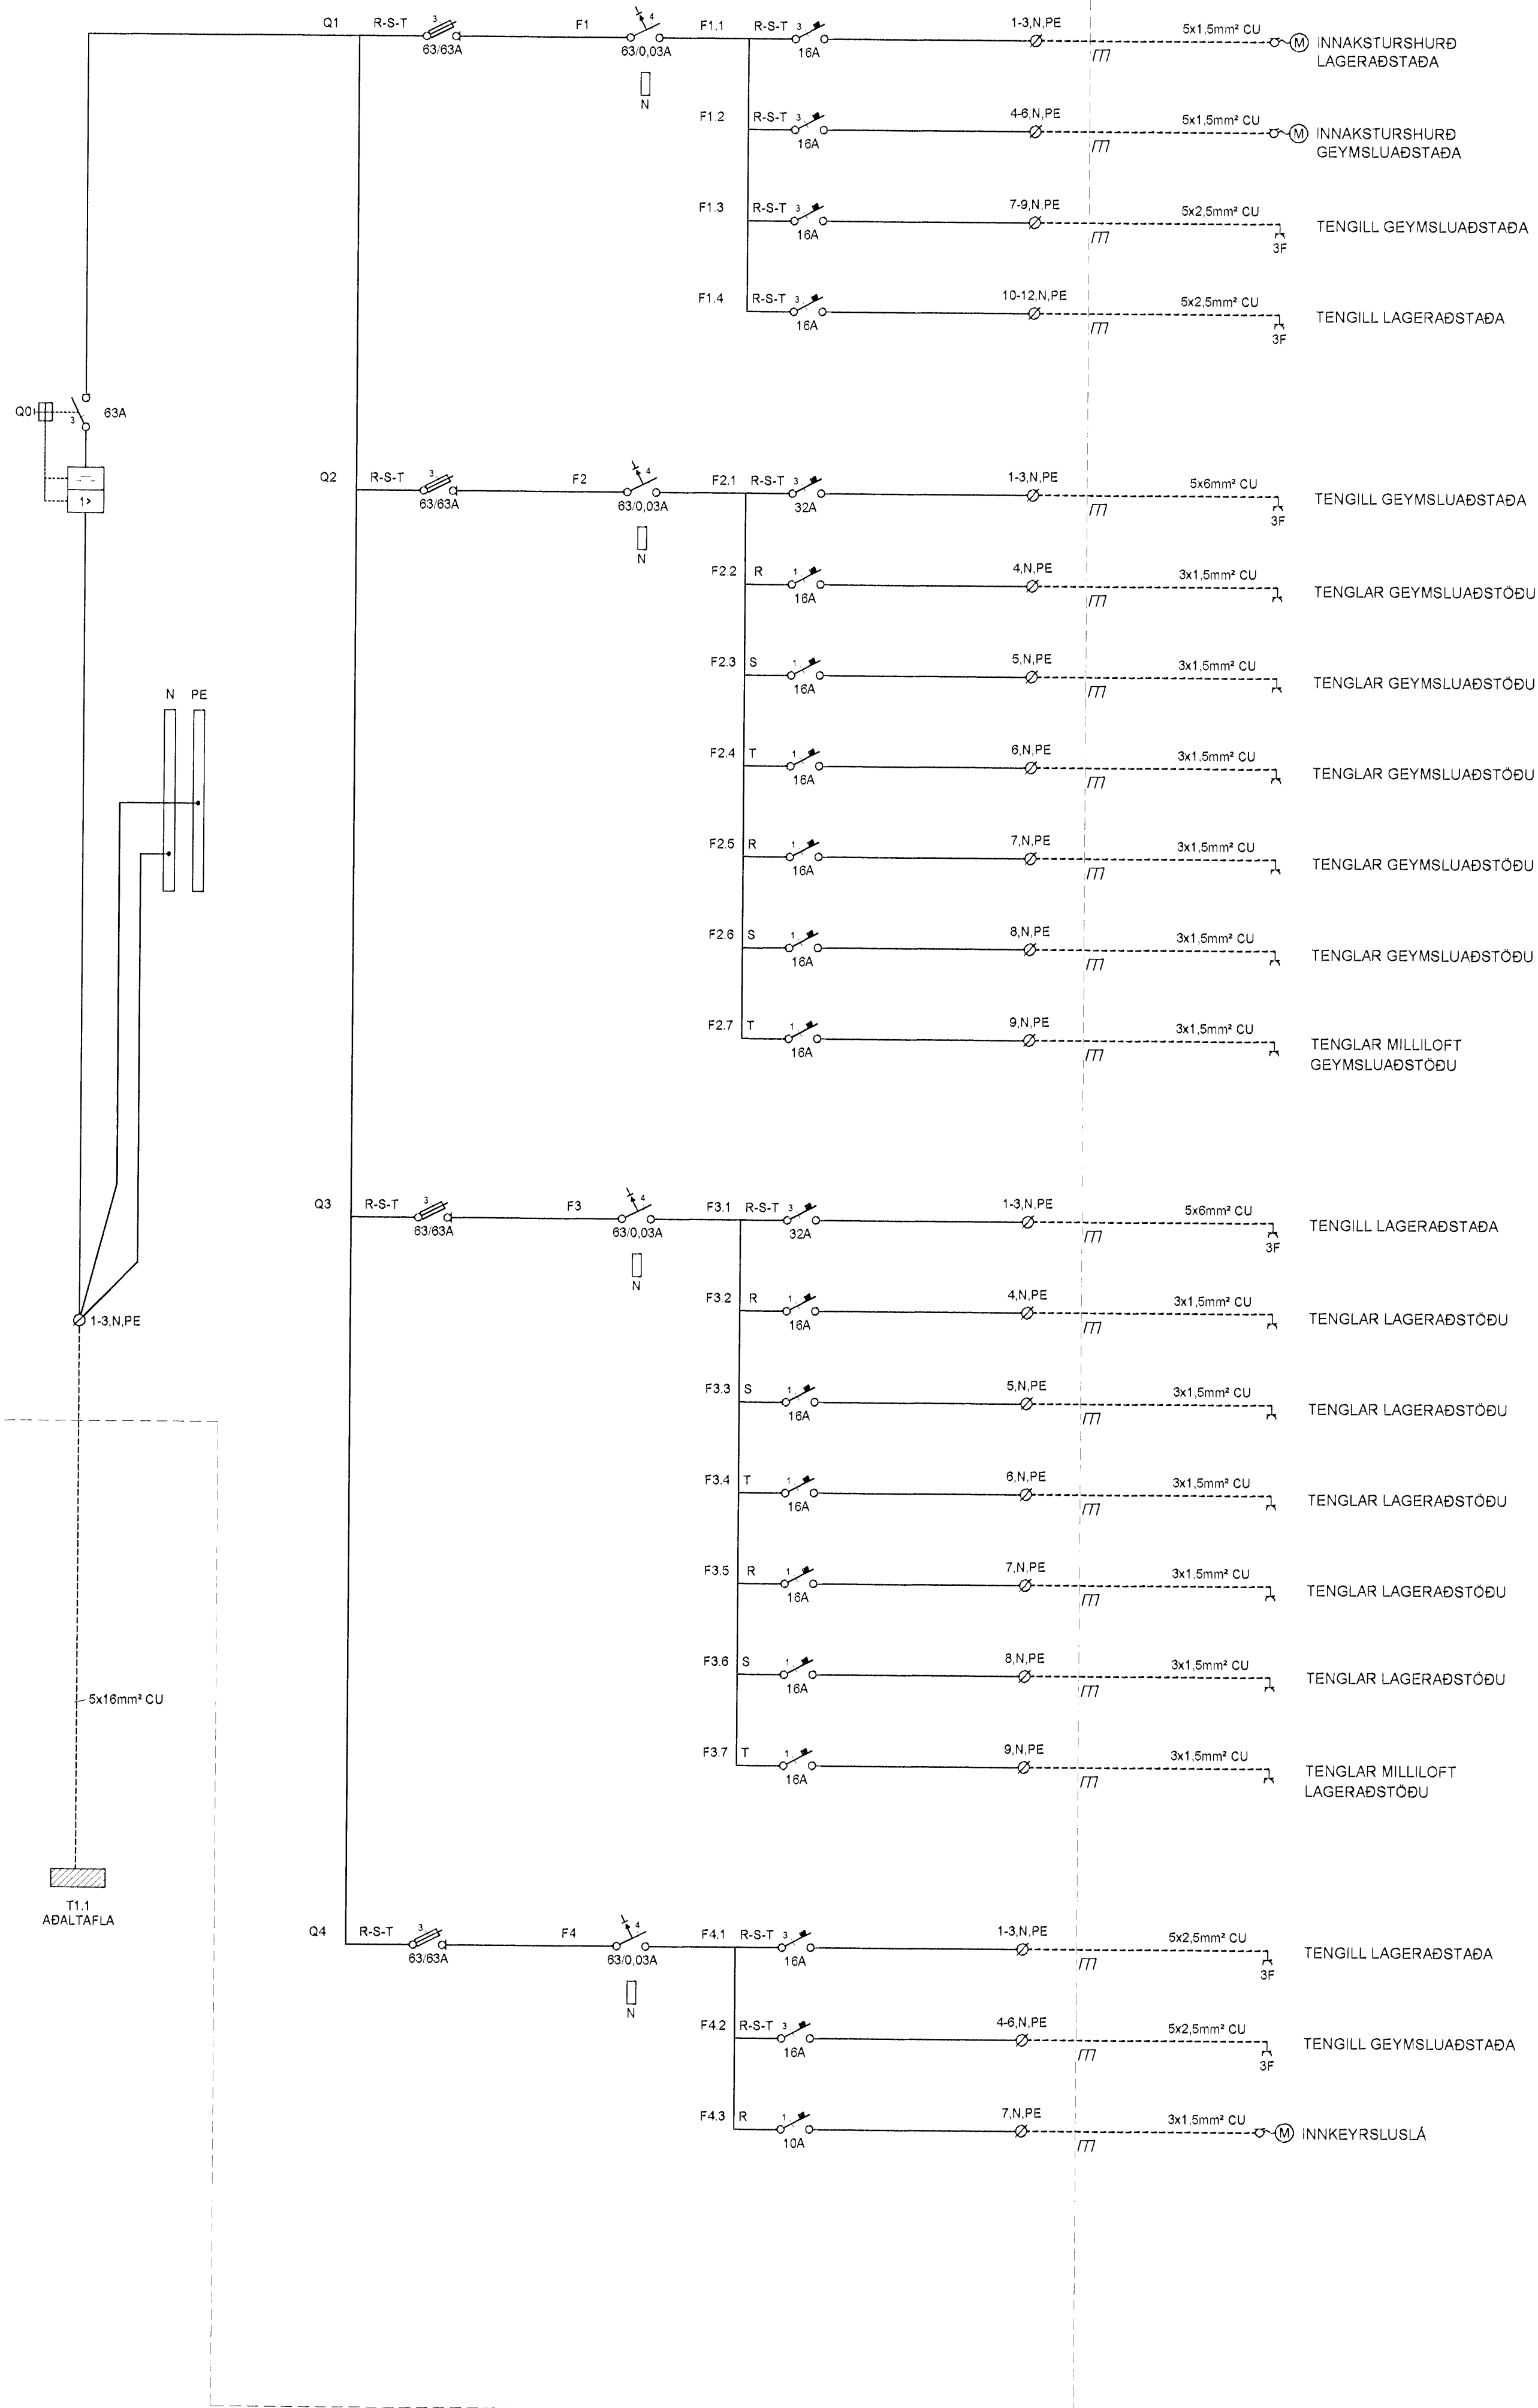

ARTUN SAMRÆMINGARHOUDAR

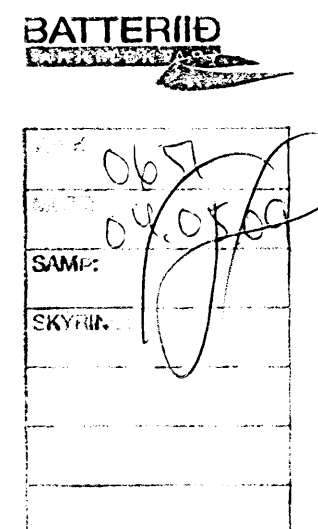

B	28.03.2009	REYNDARTEKNIÐ	JJ	LL
A	11.01.2008	YMSAR BRÉYTINGAR	JJ	MOG
BR	DAGS	BRÉYTING	REKN	TEKN

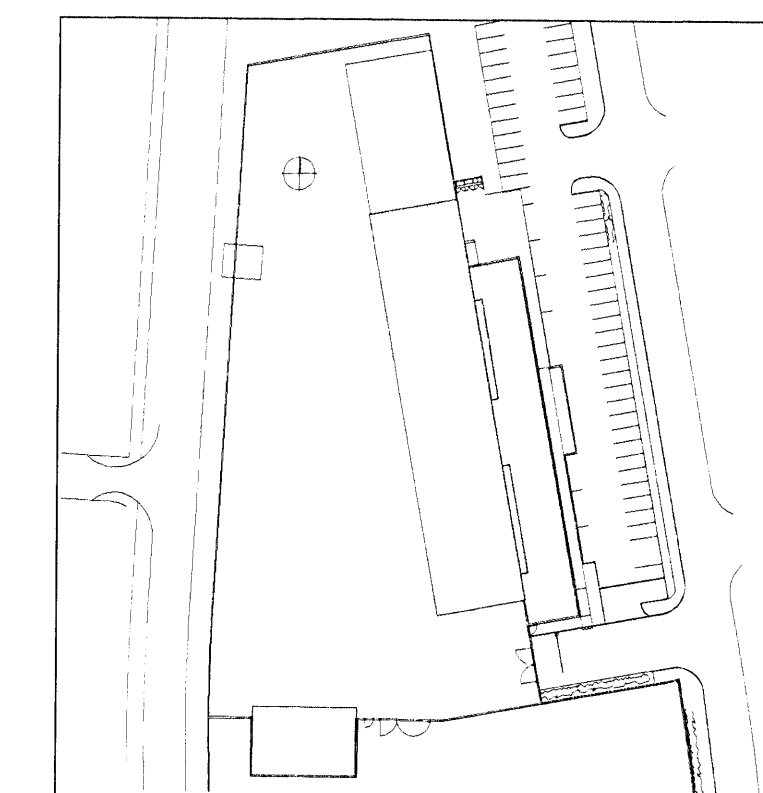

VSÓ FRAMKVÆMDASVIÐ HAFNARFJARÐAR
 BORGARTUN 26, 108 REYKJAVÍK, Sími 565-8000, Símbreyt 565-8010, NETFANG vs@vs.is

RAFKERFI	HANNADEKNI	JUAG/MOG
EINLUNUMYND	YFIRFARID	EA
GREINATAFLA T1.3	SAMÞYKKT	Símpr Umráðgjafi
	KT	110366-7769
XVARÐI A1 / -	REYKJAVÍK	11.10.2007
VEROUR	TEKN NR	BR

S:\2007\07102\rafk\linea\afm\un\g\rafk\rafk05_R1-E3-01.dwg