
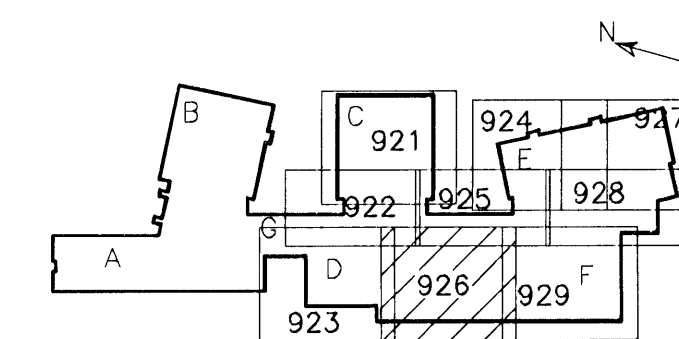


ÓTGÁFUFERILL


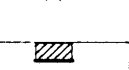

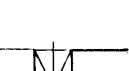
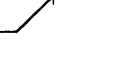
NUMER	DAGS	SKYRINGAR	HANNAÐ
B1	10.10.2006	BYGGINGARTEIKNING	HÖG
B2	10.01.2007	MÁLSETNINGUM BETT VID OG LAGADAR	HÖG
R1	19.08.2008	REYNDARTEIKNING	HÖG


DAGS. UNDIRSKRIFTAR: NAFN OG KT. SAMRÆMINGARHÖNNUNAR:
UNDIRSKRIFT SAMRÆMINGARHÖNNUNAR: 



LYKILMYND

SKÝRINGAR:

- A x B  B MERKIR GAT Í PLÖTU STÆRD Amm x Bmm
 -  RAUF Í SÖKKUL EDA VEGG Amm DJÚPA OG Bmm BREIDA NEDRI BRÚN Í KÓTA 10,00m OG HÆÐ 1000mm
 - A x B  K=10,00 H=1000
 - A x B  K=10,00 GAT Í SÖKKUL EDA VEGG, Amm BREITT OG Bmm Á HÆÐ NEDRI BRÚN Í KÓTA 10,00m
 - VL  AD GAT SÉ FAST VID LOFT
- ÖLL ÓNEFND MÁL ERU í mm

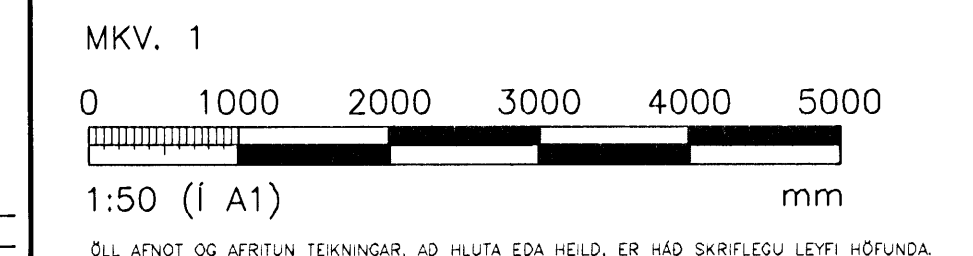


ÖRENSÁSVÆGI 1 - 108 REYKJAVÍK - Sími: 422 3000 - Fax: 422 3001
VEFFANG: www.vgkhonnun.is - NETFANG: vgkhonnun@vgkhonnun.is

HERI VERKS:
HRAUNVALLASKÓLI 2. AF.
DREKAPELLIR 9, HAFNARFIRÐI

HERI TEIKNINGAR:
GATAPLAN:
1. HÆÐ, GRUNNMYND
VEGGIR OG LOFTPLATA

MELT:	TEIKNAD:	ÖFTUNSLUNUMER:	VNR:
	LS		3.151.218
HANNAÐ:	YFIRFAR:	JKG	MKV: 1:50
DAGS. UNDIRSKRIFTAR: 31.12.2008	NAFN OG KT. HÖNNUNAR: VGK - HÖNNUN	430572-0169	B2-926
UNDIRSKRIFT HÖNNUNAR: LÁRUS ÁRSÆLSSON		200862-5119	ÓTGÁFA R1

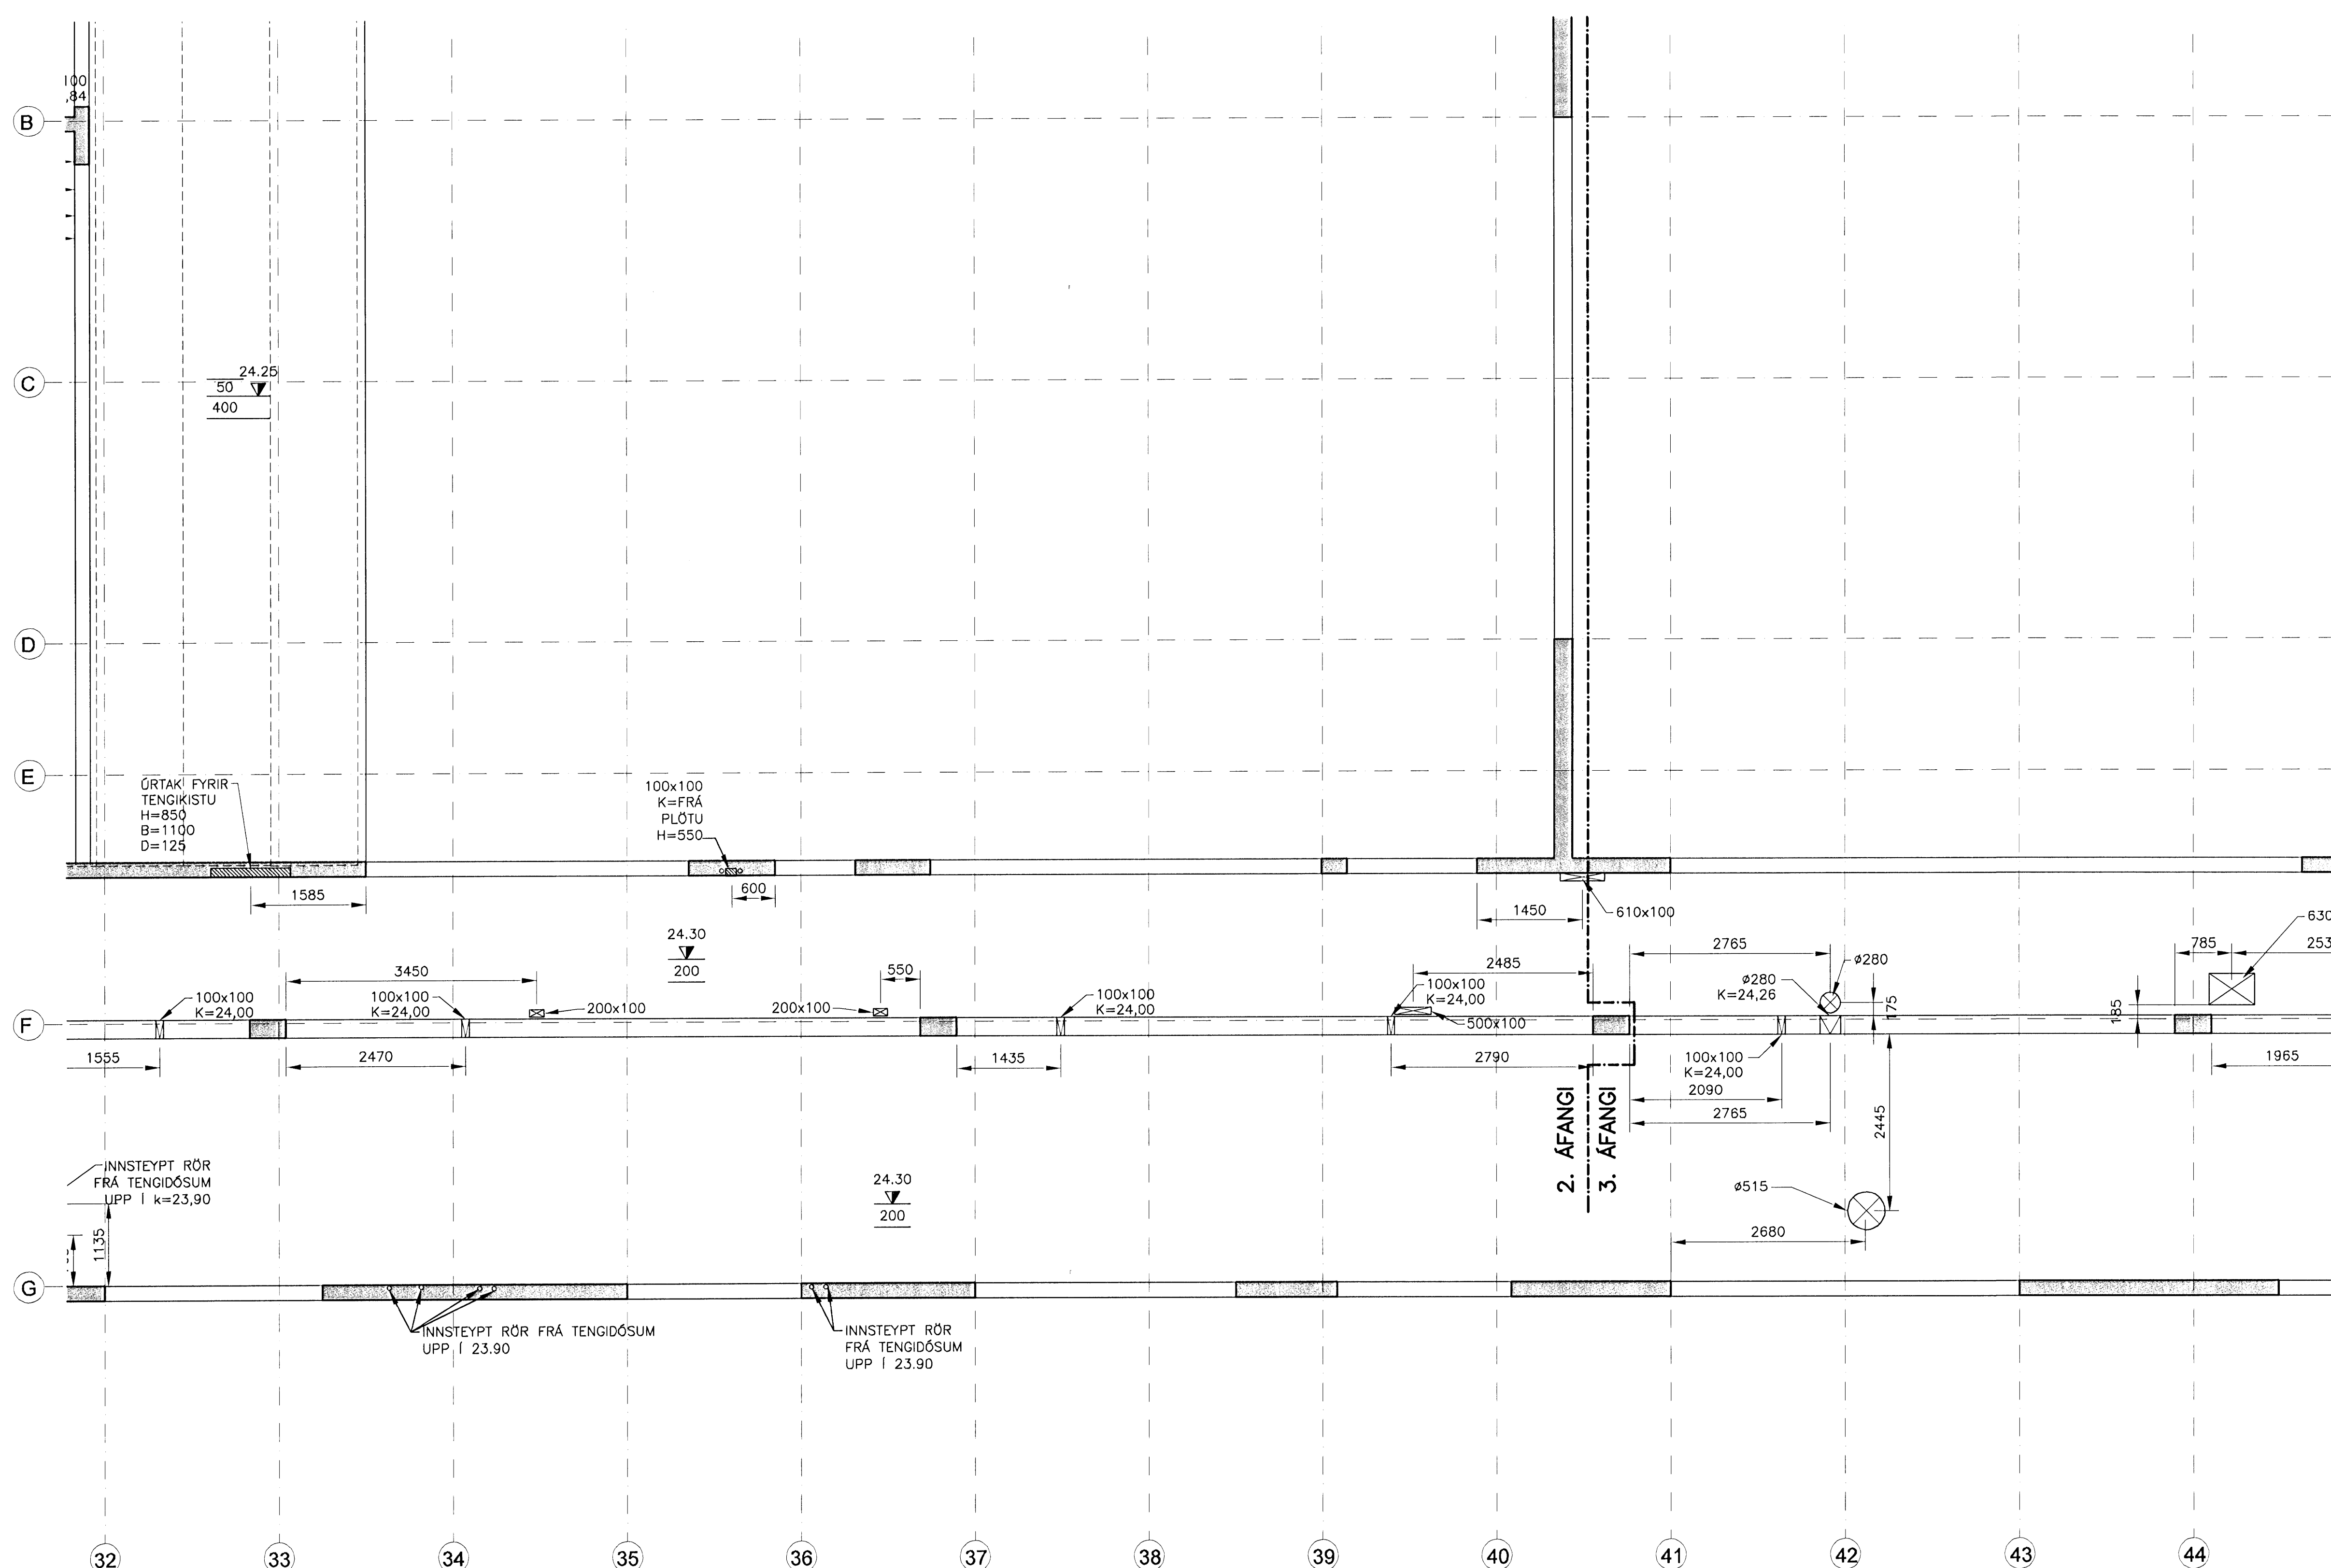

GRUNNMYND
MKV. 1