
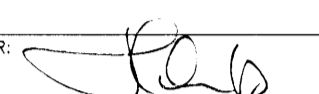
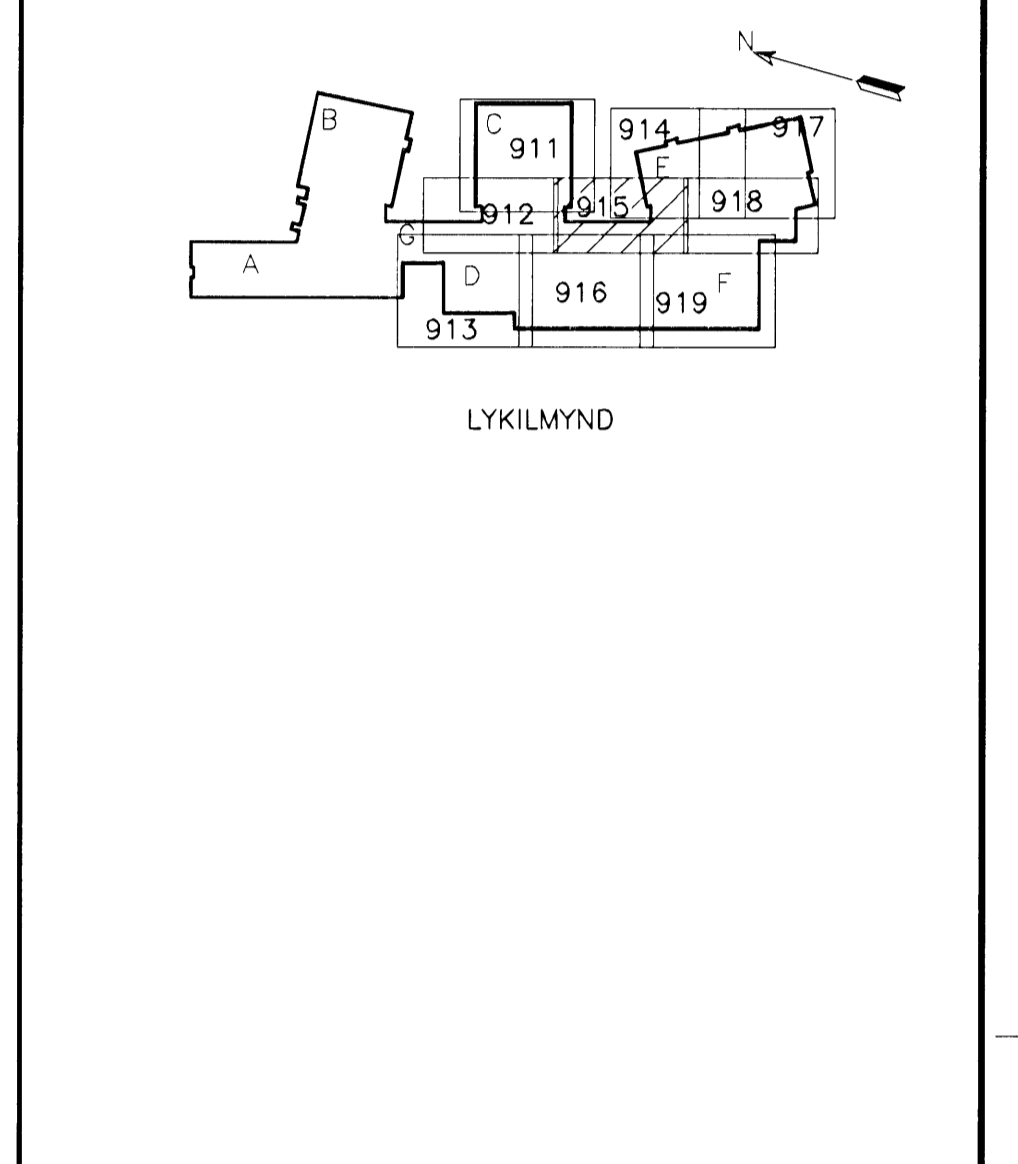



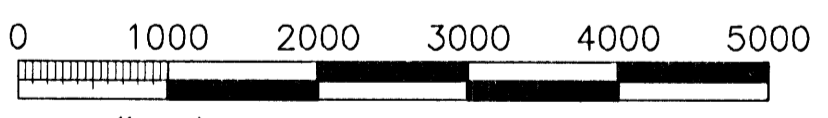

**Samþykkt þann**  
**18 AUG 2009**  
 Byggingafráttir í Hafnarfirði  
 E.h. Hrólfur S. Gunnlaugsson

ÚTGÁFUFRILL			
NÚMÉR:	DAGS:	SKYRINGAR:	HANNAÐ:
B1	25.10.2006	BYGGINGARTEIKNING	HÖÖ
B2	24.08.2007	MÁLSETT GÖT	LÁ
R1	19.08.2008	REYNDARTEIKNING	LÁ

DAGS. UNDRISKRIFAR: NAFN OG KT. SAMRÆMINGARHÖNNUNAR:

UNDRISKRIF SAMRÆMINGARHÖNNUNAR: 

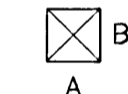

- SKÝRINGAR:**
- A x B  MERKIR GAT Í PLÖTU STÆRD Amm x Bmm
  -  RAUF Í SÖKKUL EDA VEGG Amm DJÚPA OG Bmm BREIDA NEDRI BRÚN Í KÓTA 10,00m OG HÆÐ 1000mm
  - A x B  K=10,00 H=1000 GAT Í SÖKKUL EDA VEGG, Amm BREITT OG Bmm Á HÆÐ NEDRI BRÚN Í KÓTA 10,00m
  - A x B  K=10,00 VL AD GAT SÉ FAST VID LOFT ÖLL ÖNEFND MÁL ERU í mm
- MKV. 1
- 
- 1:50 (I A1) mm
- ÖLL AFNOT OG AFRITUN TEIKNINGAR, AD HLUTA EDA HEILD, ER HÁÐ SKRIFLEGU LEYFI HÖFUNDA.


  
 GRÉNSÁSVEGI 1 · 108 REYKJAVÍK · Sími: 422 3000 · Faxi: 422 3001  
 VEFfang: www.vgkhonnun.is · Netfang: vgkhonnun@vgkhonnun.is

**HRAUNVALLASKÓLI 2. ÁF.**  
**DREKAVELLIR 9, HAFNARFIRDI**

HEITI TEIKNINGAR:

GATAPLAN;  
UNDIRSTÖÐUR  
GRUNNMYND

MÆLI:	TEIKNAD:	GEYMSLUNGUMER:	VNR:
HANNAÐ: HÖÖ/BIO/PB	YFIRFARID: JGG	MKV: 1:50	NR. TEIKNINGAR: 3.151.218
DAGS. UNDRISKRIFAR: 31.12.2008	NAFN OG KT. HÖNNUNAR: VGK-HÖNNUN	430572-0189	<b>B2-915</b>
UNDRISKRIF HÖNNUNAR: LÁRUS ARSÆLSSON	200862-5119	ÓTAFAR: R1	

GRUNNMYND  
MKV. 1