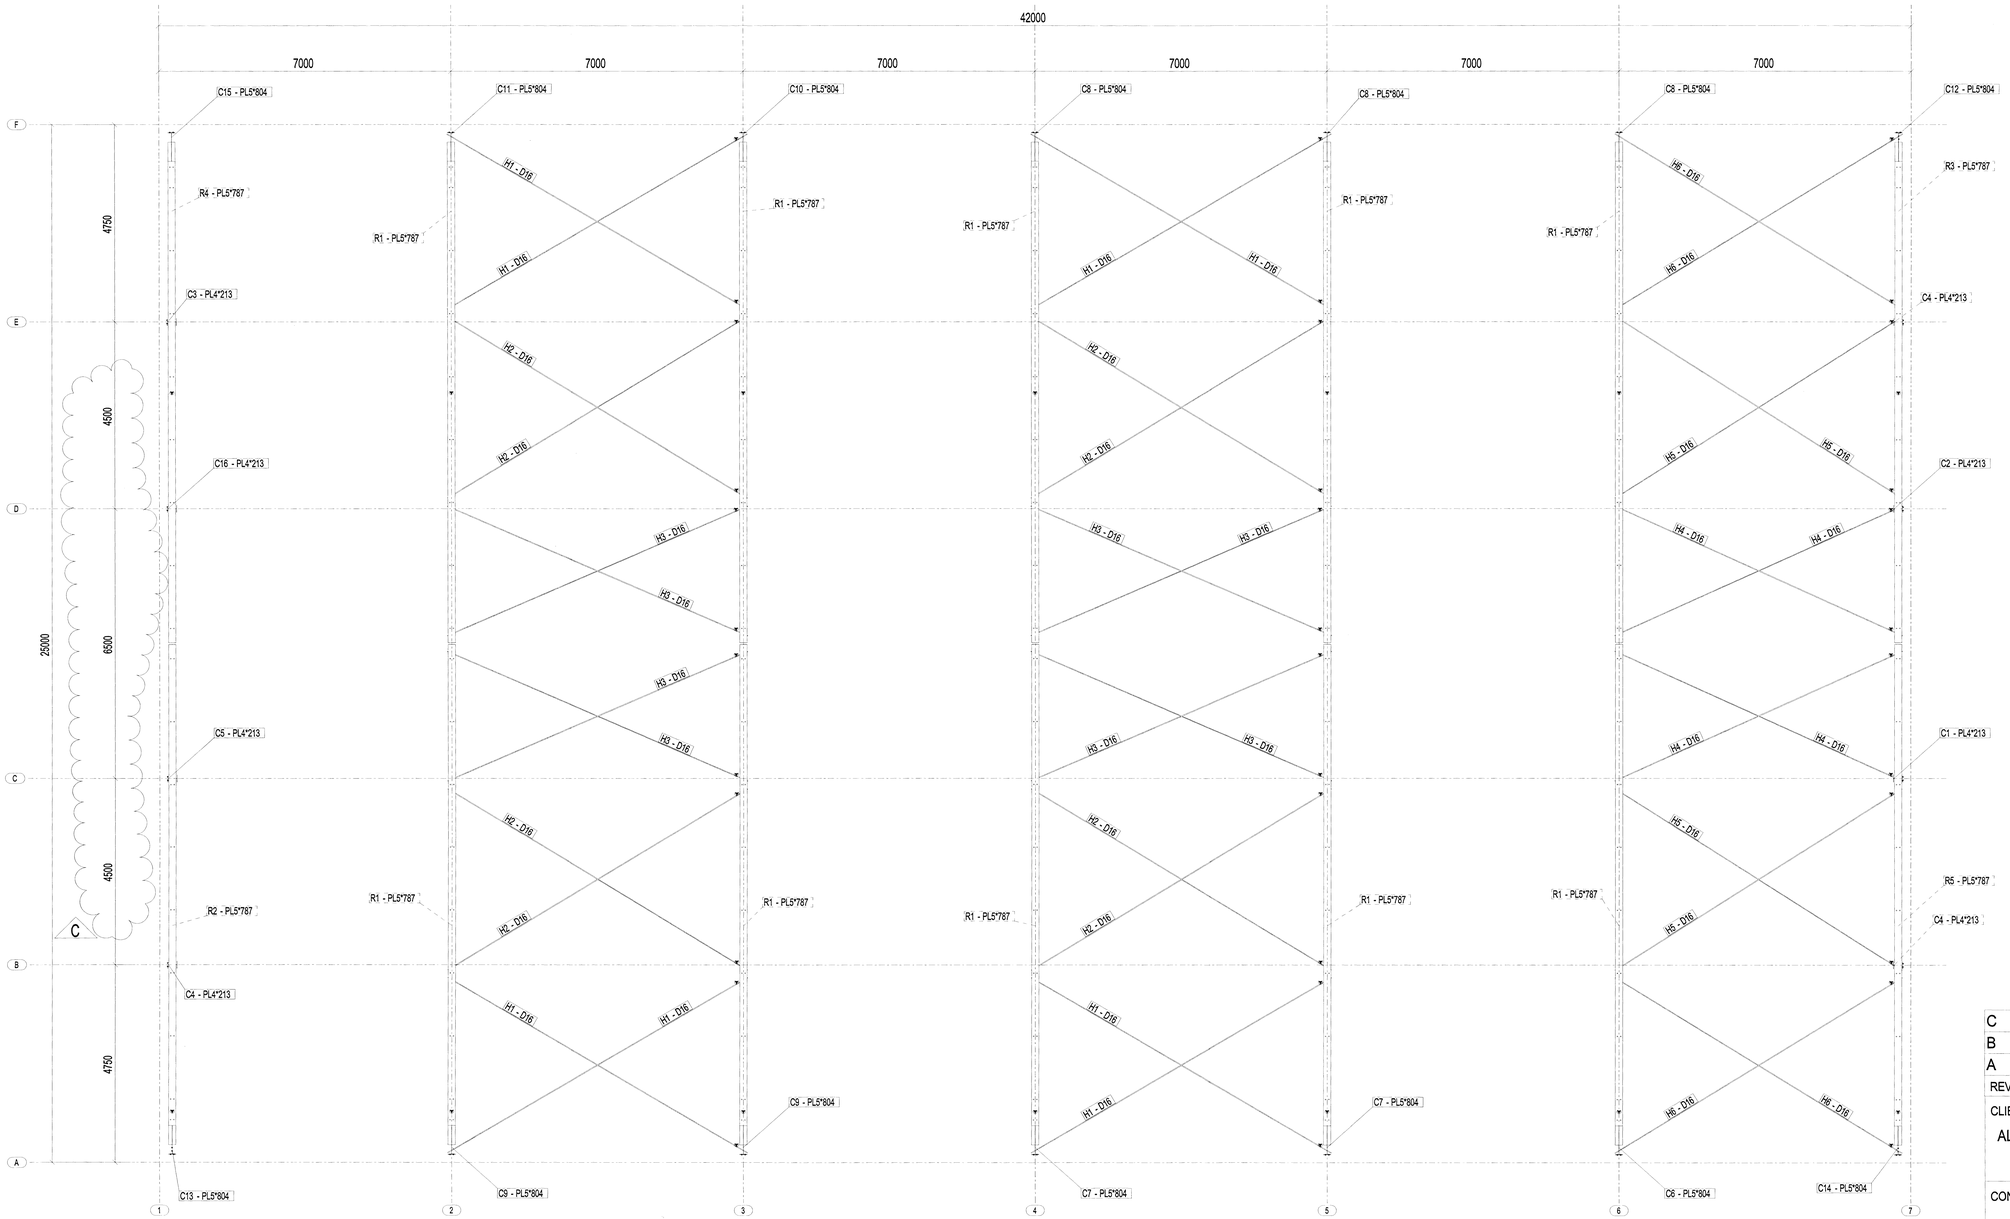

ROOF PLAN SHOWN COLUMNS,RAFTERS & ROOF BRACING

GENERAL NOTES:-

1. ▼ BEAM MARK DESGNATION.
2. DIRECTION OF VIEW NORTH OR EAST.
3. ALL DIMENSIONS ARE IN MM (UON).

REFERENCE DWG:

Samþykkt þann
[dags]
04 MAY 2009
Byggingafulltrúinn í Hafnarfirði
f.h. Hrólfur S. Gunnlaugsson

REV.	DATE	DESCRIPTION	DRN.	CHK.
C	06-10-2007	ISSUED FOR APPROVAL	MONA ODEH	MUNA BTOSH
B	02-10-2007	ISSUED FOR APPROVAL	MONA ODEH	MUNA BTOSH
A	29-09-2007	ISSUED FOR APPROVAL	MONA ODEH	MUNA BTOSH

CLIENT:

AL JIZA FOR IMPORT & EXPORT CO.

CONSULTANTS:

NEGEM CO.
ENGINEERING & CONSULTING
HEAD OFFICE: TEL:(06) 5823860 ; 5823960
P.O. Box : 475 Amman-11953-Jordan
FACTORY : TEL:(06) 4460204 ; 4460207 FAX: (06)4460236
E- MAIL : <negemco1 @ wanadoo.jo> / <negemco @ go.com.jo>

TEKLA® Structures

Yfirfarið og samþykkt : Dagsetning: 15 nóvember 2007
Breyting og útprentun : Dagsetning: 15 maí 2009

Geymslusvæðið ehf Hafnarfirði landsnr 122106	
Álhella 4 Hafnarfirði	
Stálgrindarteikning Skástífur í þak	1:100
Stefán Jónsson byggingartæknifræðingur Kt 230145-7099 GSM 821 5301 jonsson@gmail.com	Amman : 170

CREATE DATE: 28.09.2007 /MODIFY DATE: 05.10.2007 /PRINT DATE: 05.10.2007 / PRINTTIME: 14:45:11