
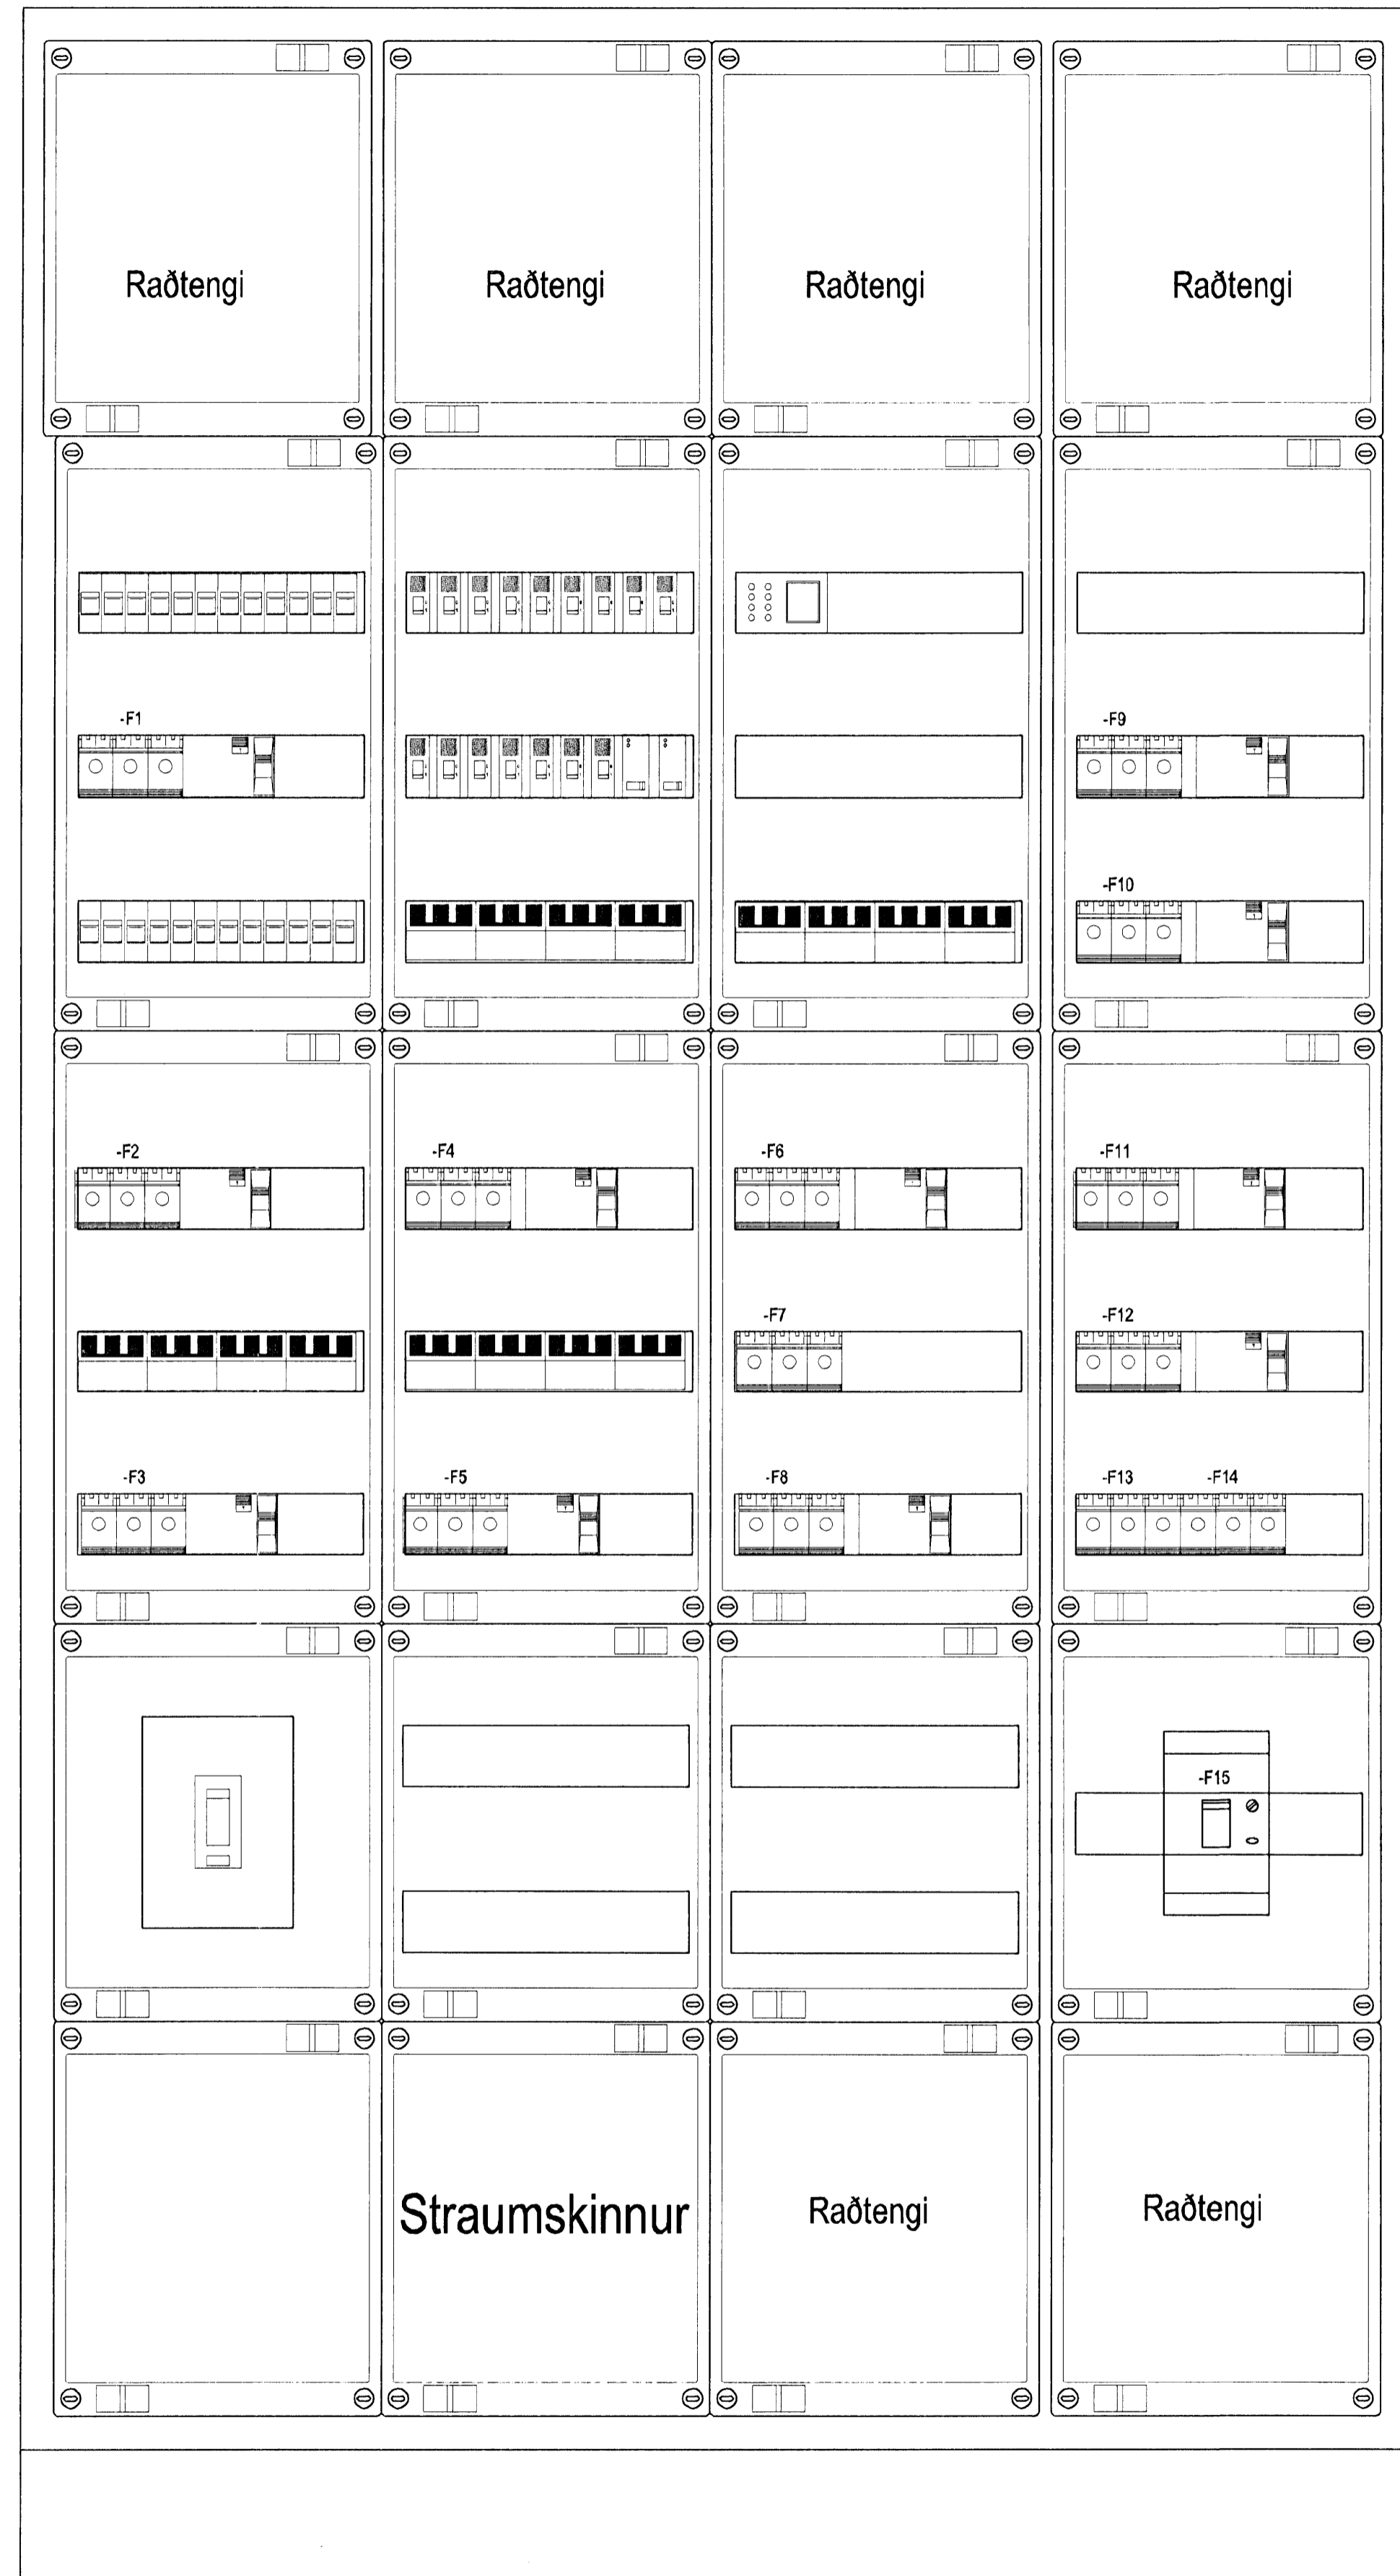


T1.2.1

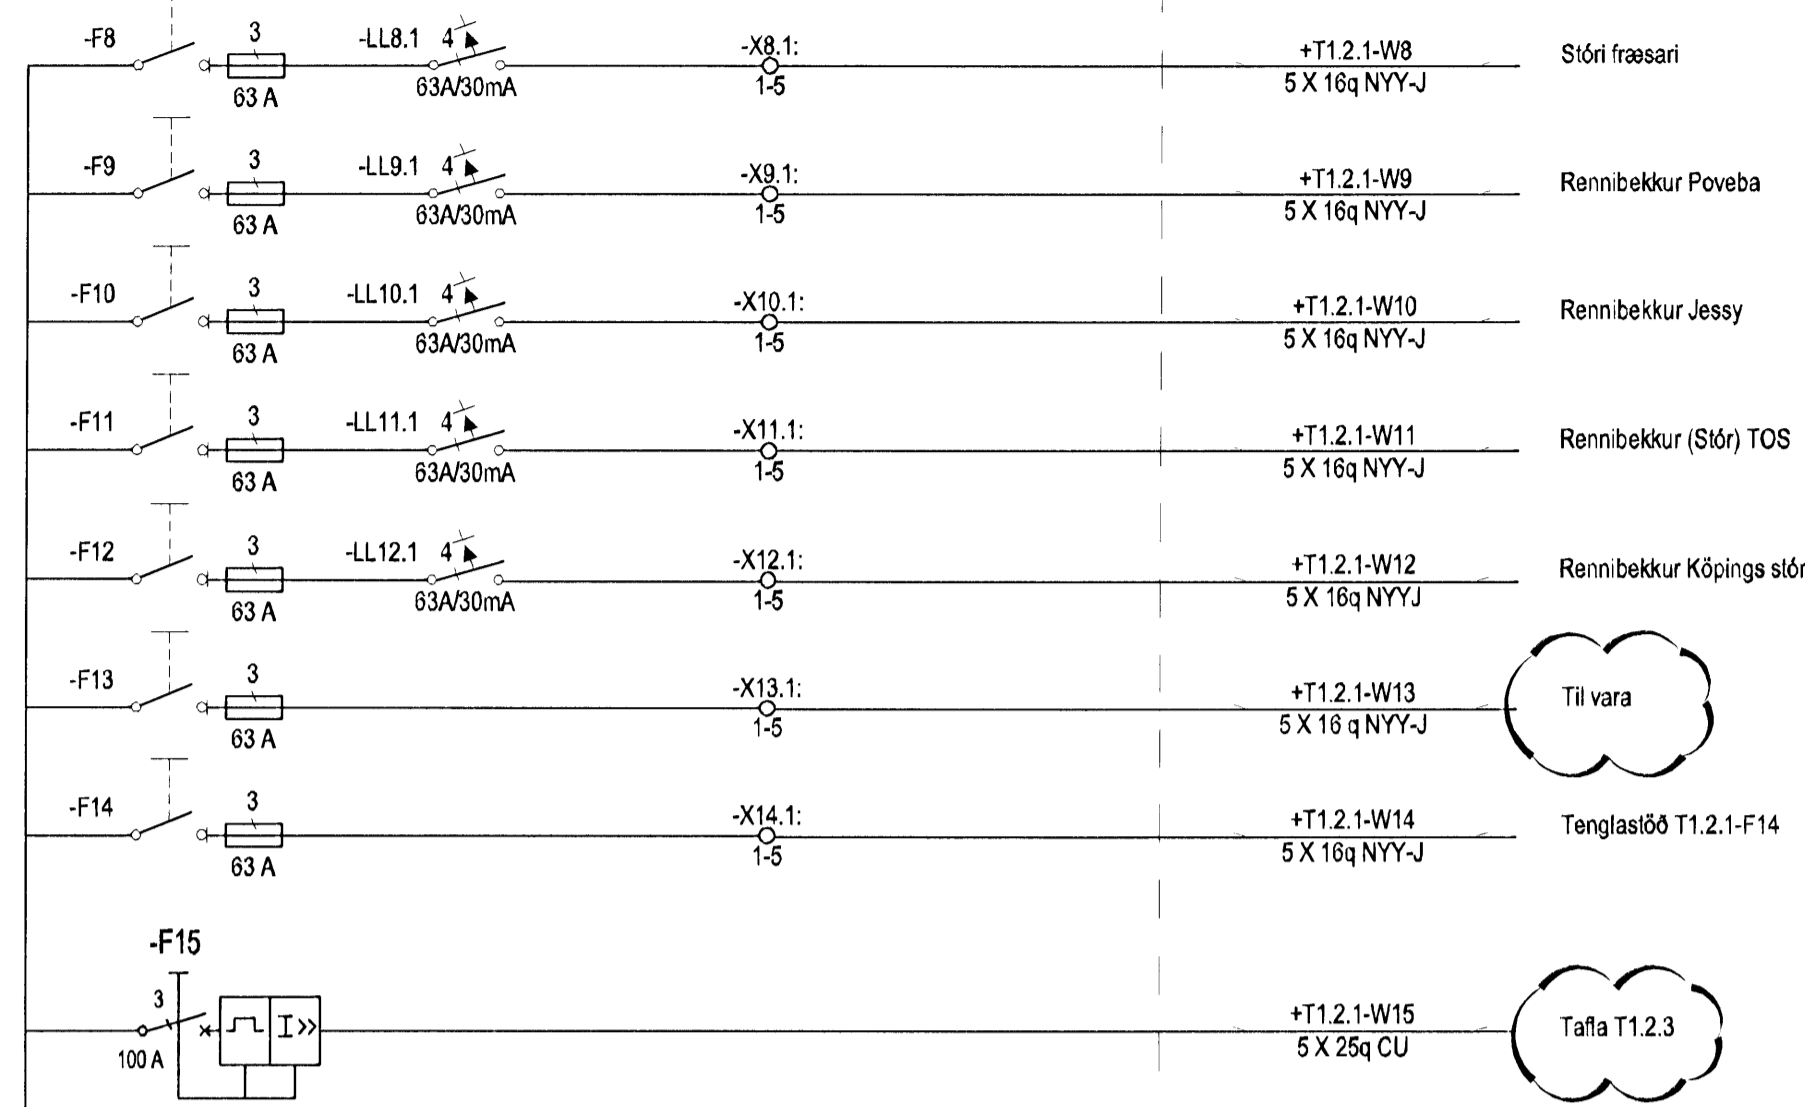

14/3/08

Hönnuður:
ARI, HAS
Yfirfarir:
Sambykkt: Davíð Sólvaðsson
kt: 100356-3339

Breytingar:
B1 12.02.2009 Reyndartekning

Aðalhönnuður:
ASK
04.02.2009
-HA
Hönnuður: Hóstiður Árnason

Héðinn
Gjáhella 4
221 Hafnarfjörður

Einlínunmynd
T1.2.1
Mkv: Enginn

RTS
VERKFRÆÐISTOFA
Grensásvegur 3
108 Reykjavík
Sími 520 9900
Fax 520 9901
www.rts.is

Attek gæðvottun sv
BS EN ISO 9001:2000
FRV
FS 88744

32-2166-1-
03.04.2008
011105
B1

