
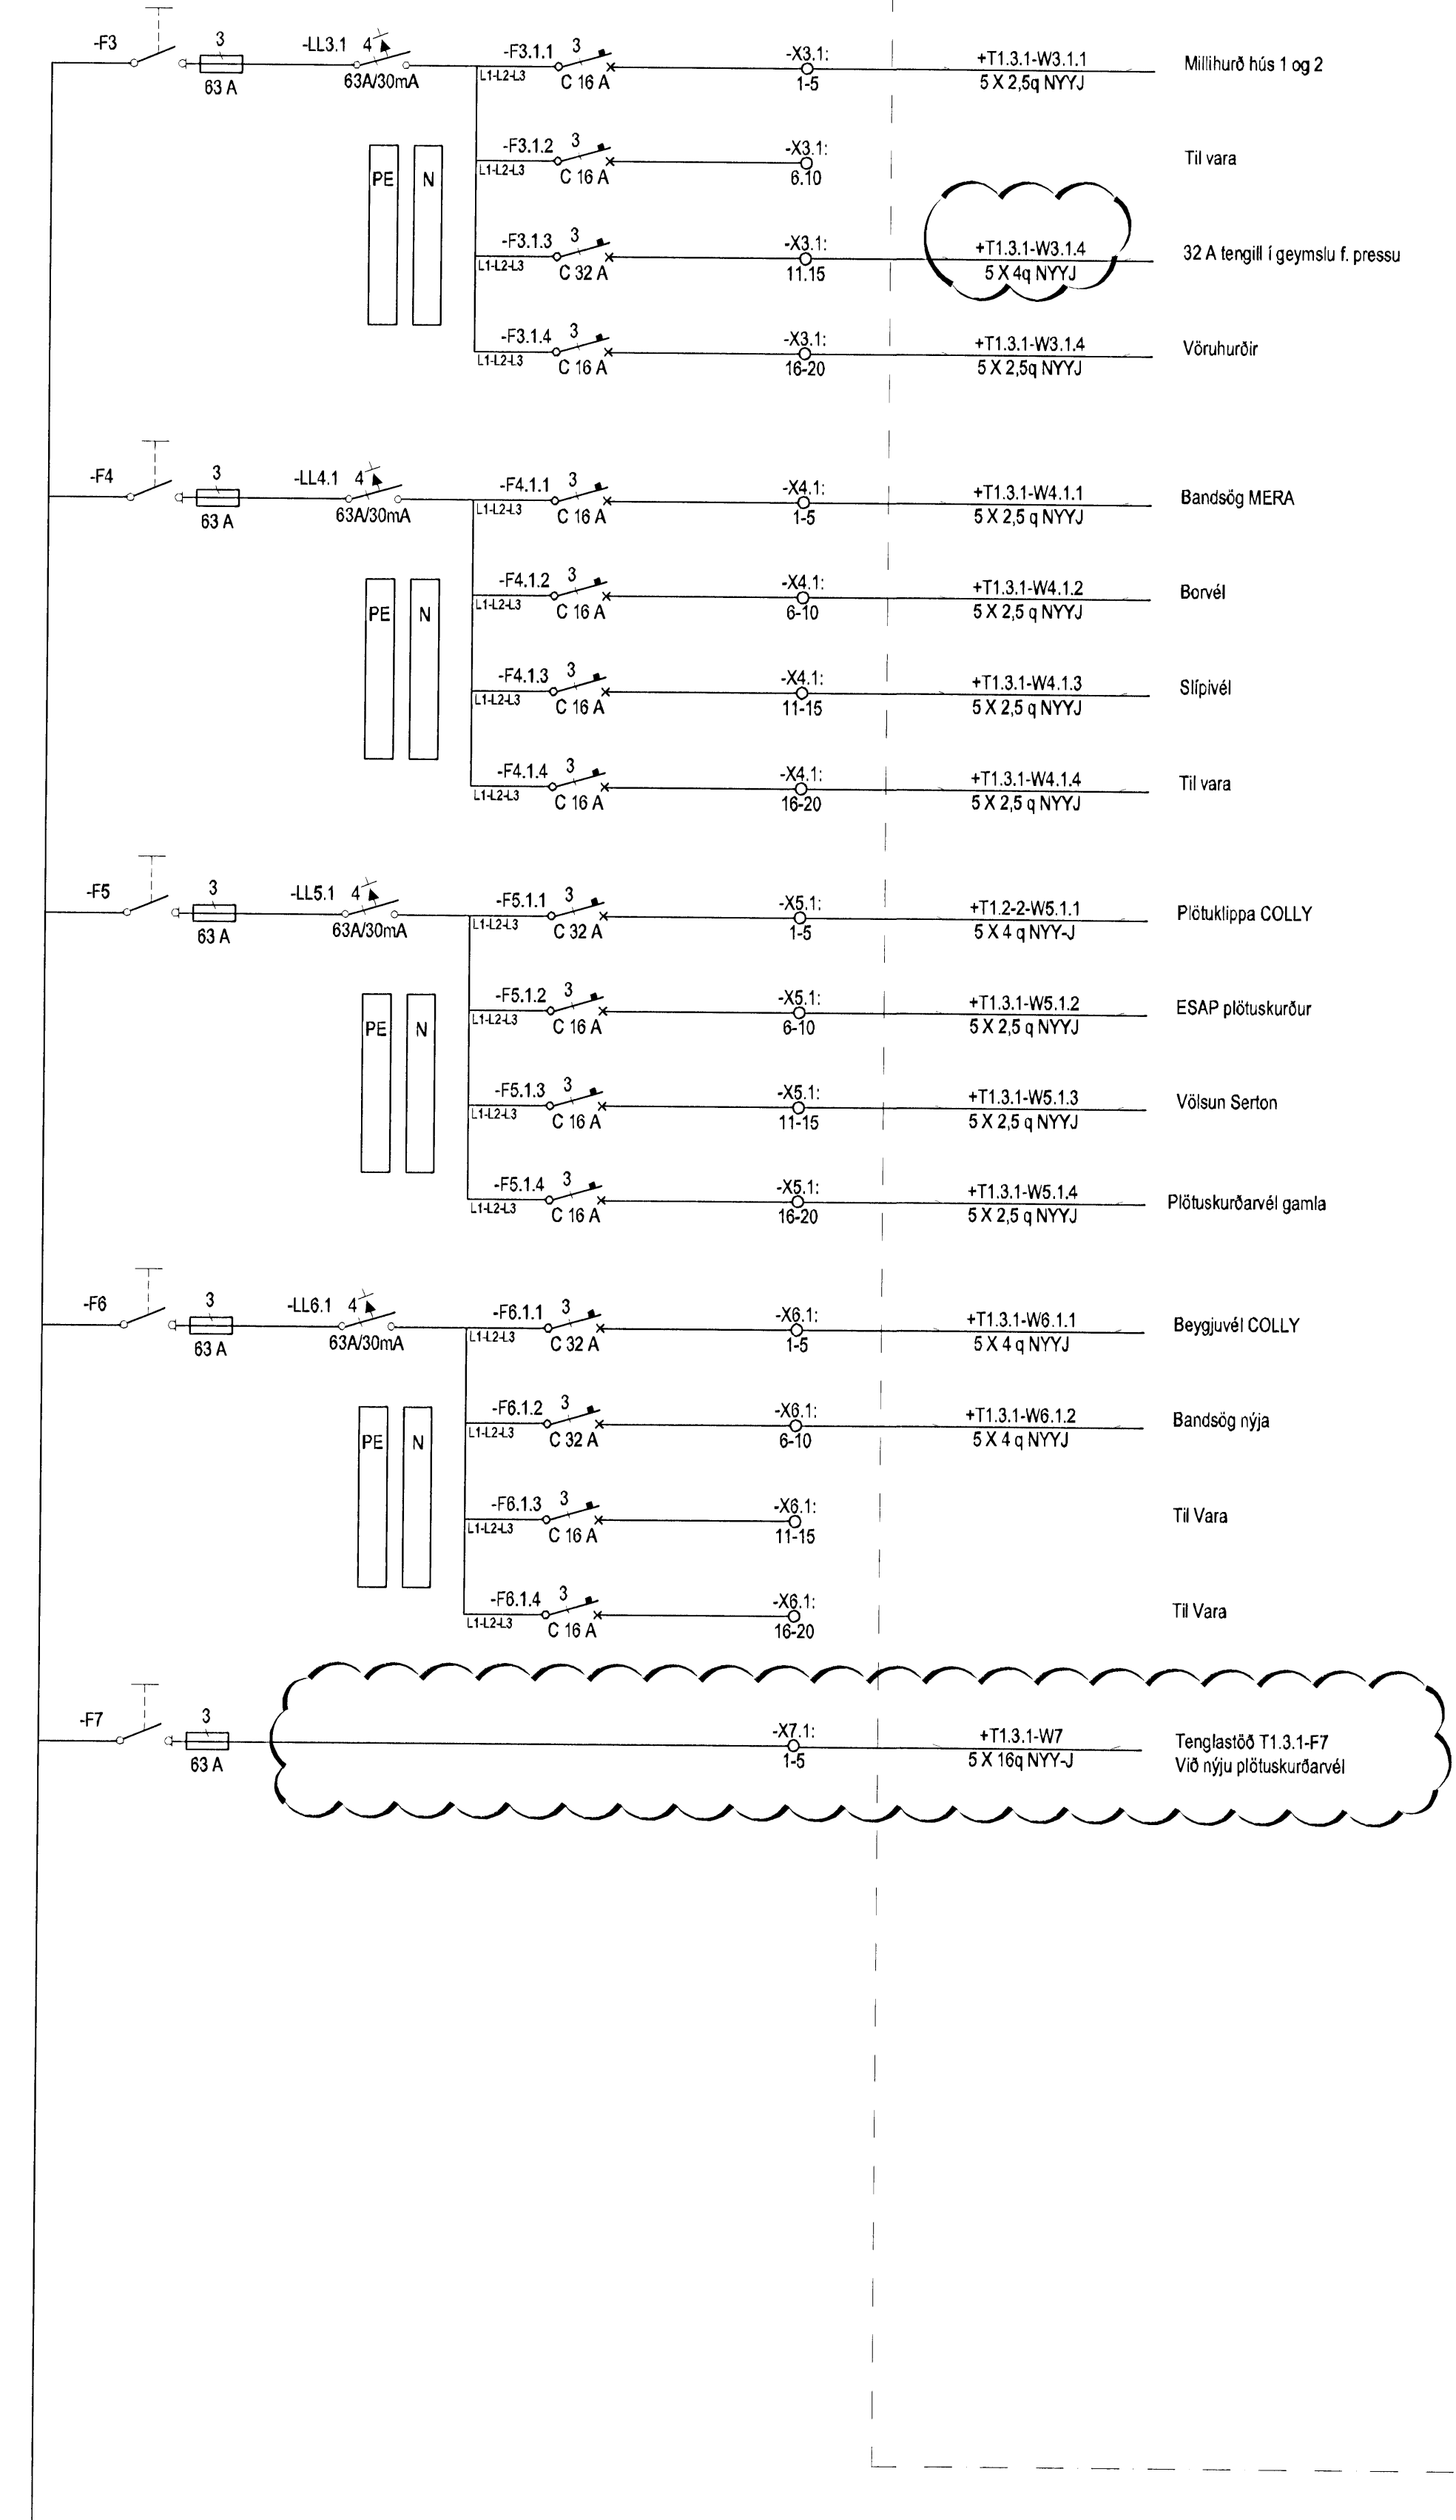


DREIFITAFLA
T1.3.1

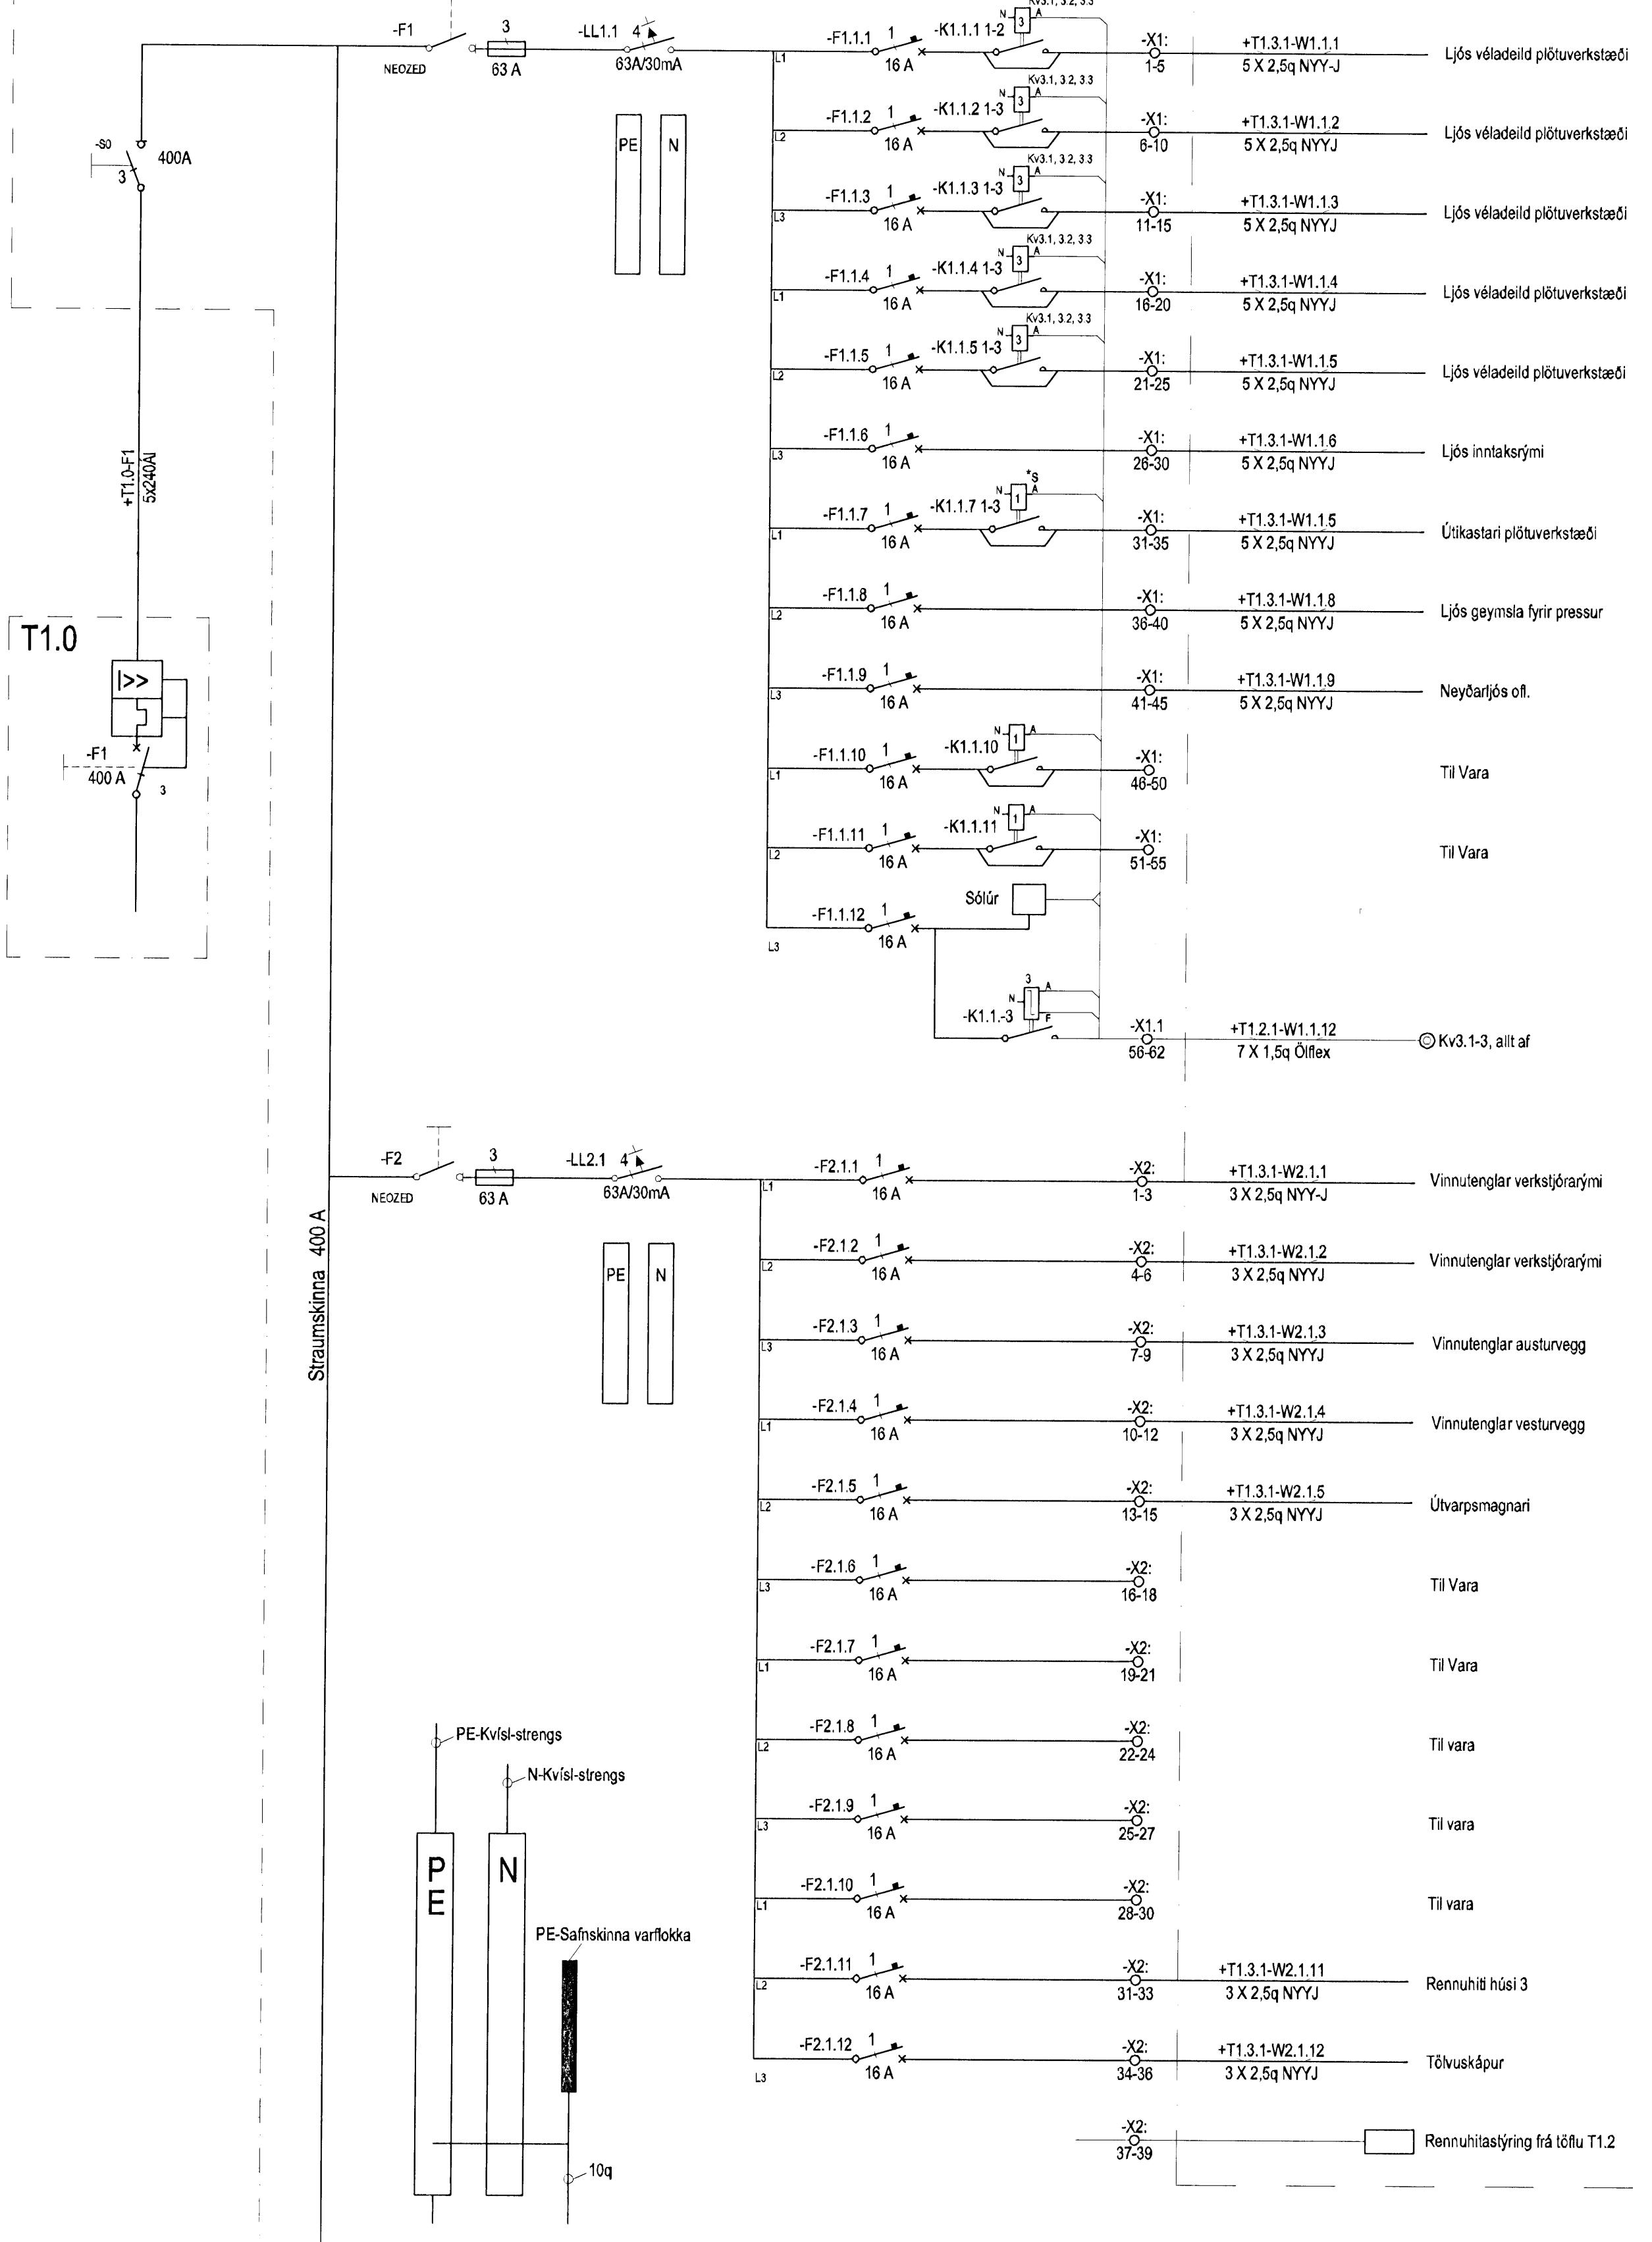

Hönnuður:
ARI, HAS

Yfirfarið:
Sambýkkt: Davíð Solvason kt: 100356-3339

Breytingar:
B1: 02.09.2008
B2: 12.12.2008 Rennuhiti
B3 12.02.2009 Reyndartekning

Aðalhönnuður:
6.4. mars 2009
-M-

Héðinn
Gjáhella 4
221 Hafnarfjörður

Einlínunmynd
T1.3.1
Mkv: Enginn

VERKFRÆÐISTOFA
Grensasvegur 3
108 Reykjavík
Sími 520 9900
Fax 520 9901
www.rts.is

Alþýðugæðvottinn sív
BS EN ISO 9001:2000
FRV
FS 8874

32-2166-1-
03.04.2008

011109
B3

