


T1.3.1

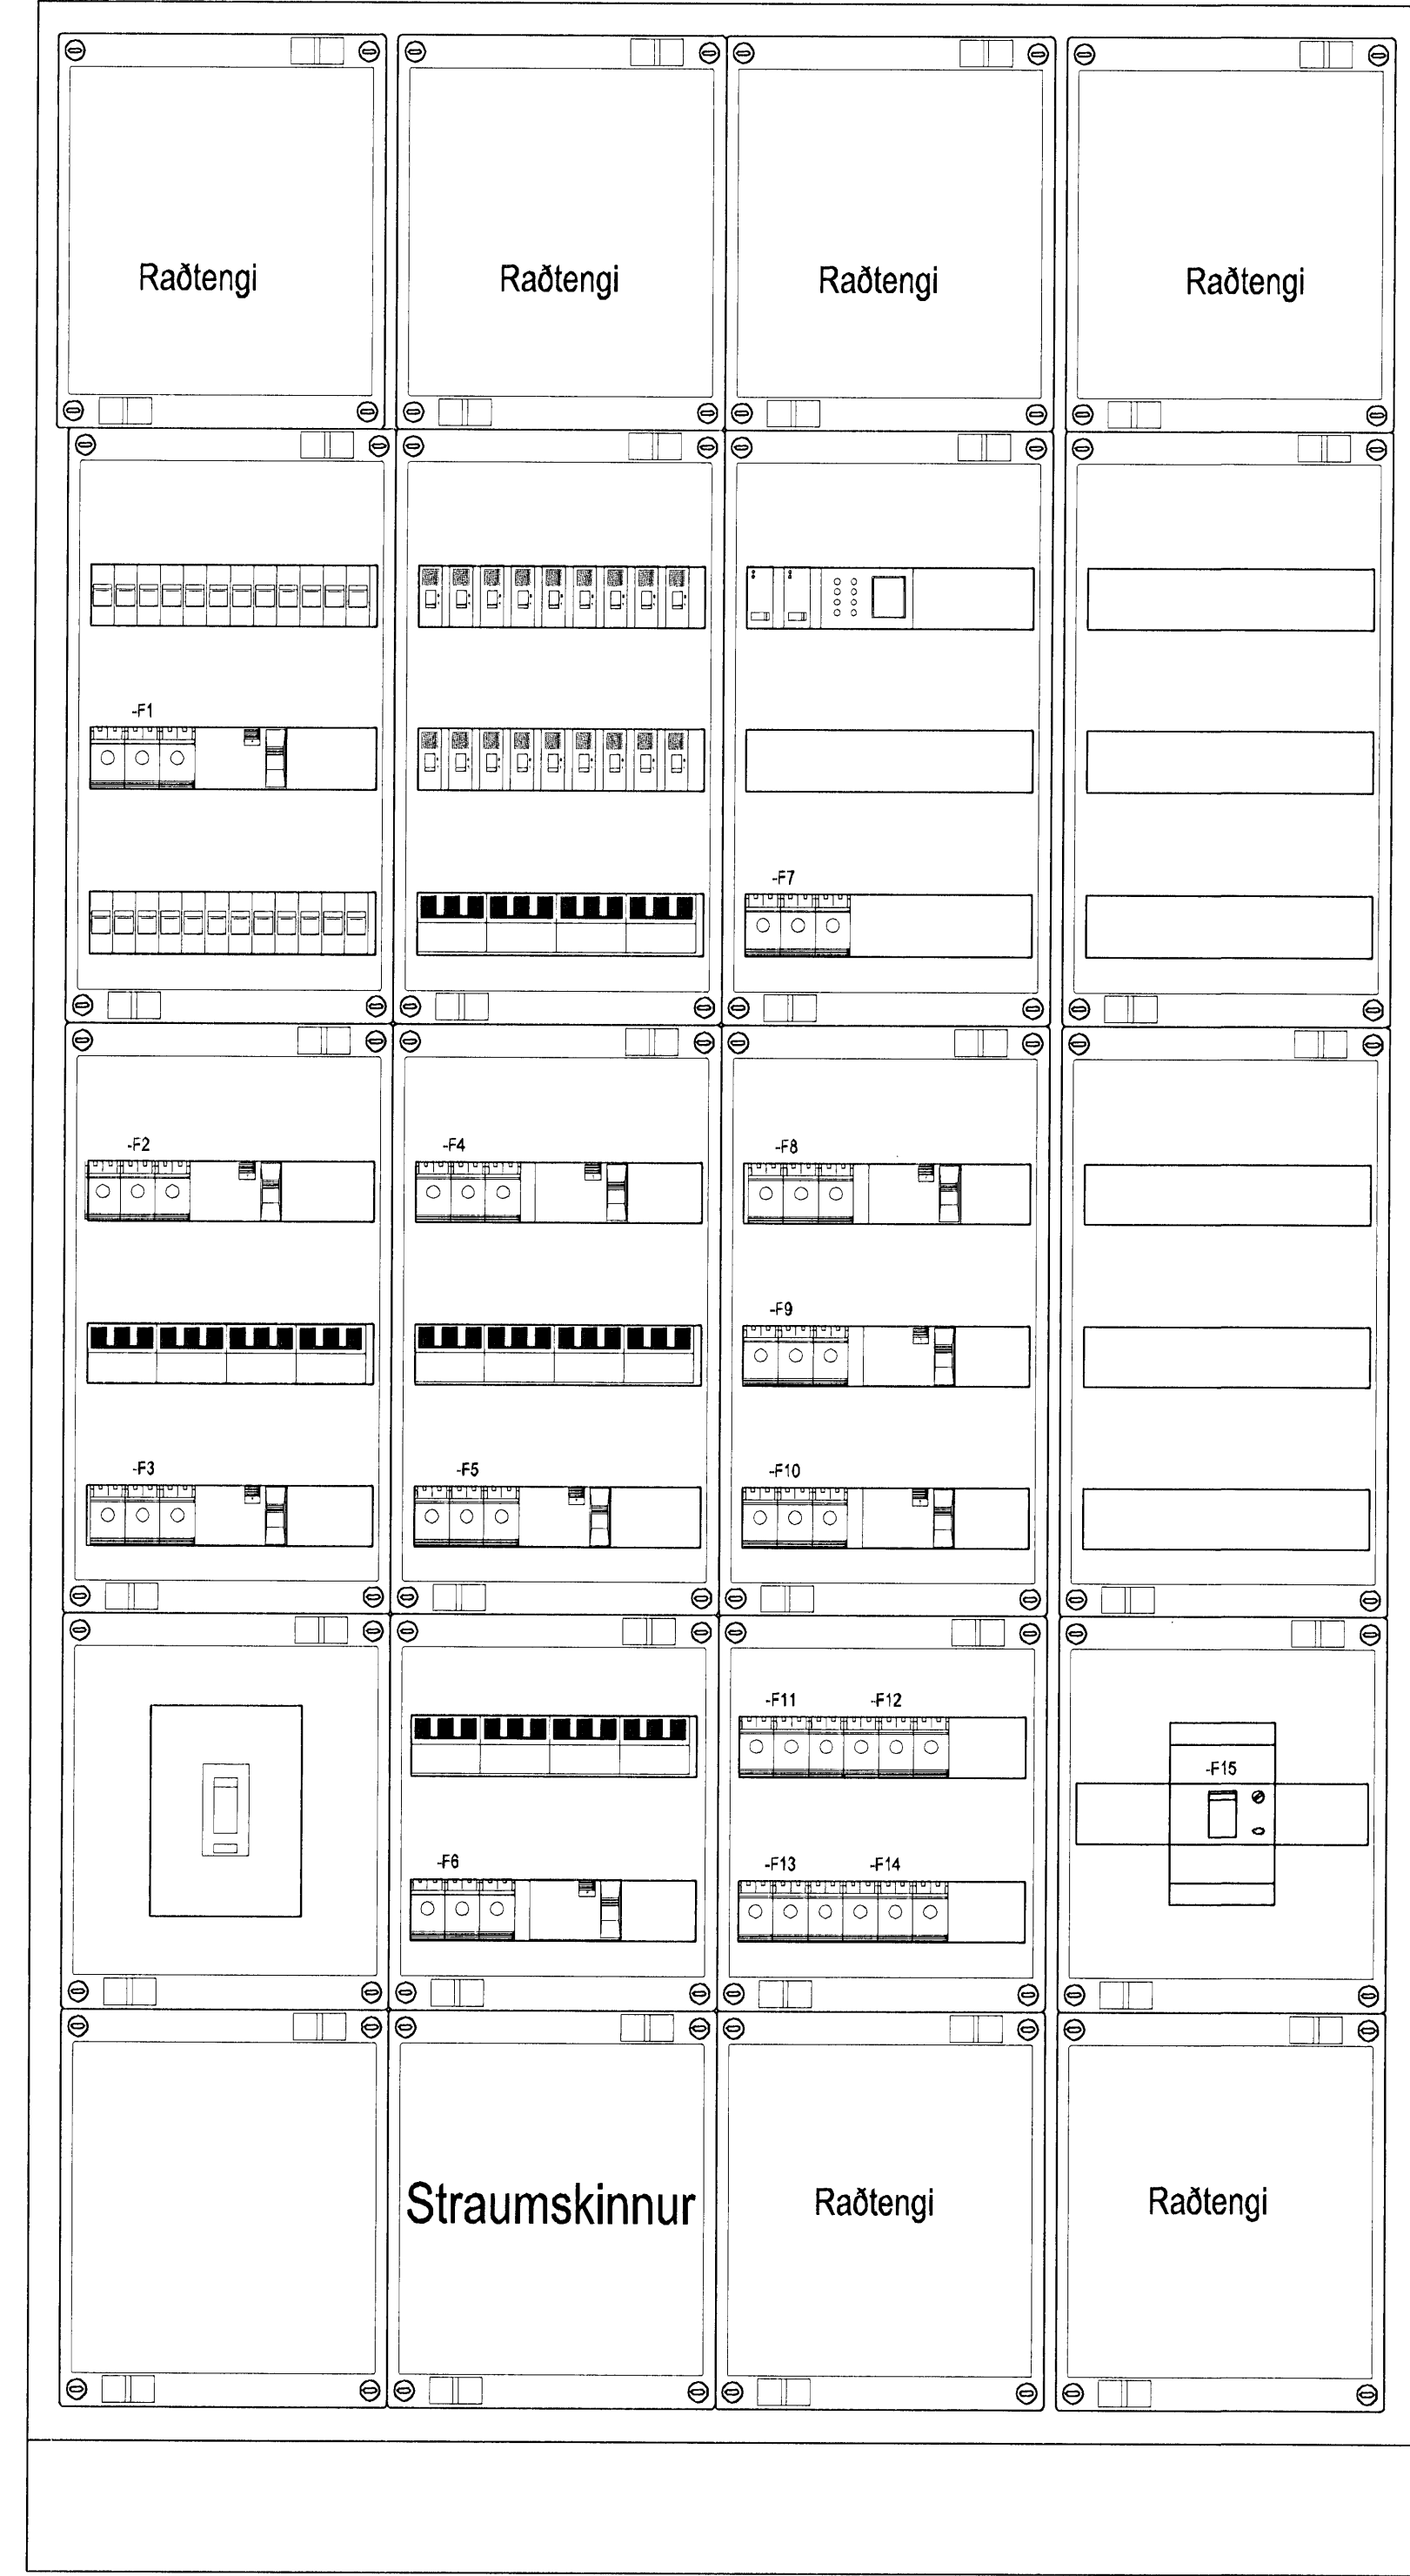

Hönnuður:
ARI, HAS
Yfirfarir:
Sambýkkt: Davíð Svansson kt: 100356-3339

Breytingar:
B1 12.02.2009 Reyndartekning

Aðalhönnuður:
ASK
04.03.2009

Héðinn
Gjáhella 4
221 Hafnarfjörður

Einlínummynd
T1.3.1
Mkv: Enginn

VERKFR/ÆDISTOFA
Grensásvegur 3
108 Reykjavík
Sími 520 9900
Fax 520 9901
www.ris.is

Attek gæðvottun skv
BS EN ISO 9001:2000
FRV
FS 88744

32-2166-1-
03.04.2008

011110 B1