


T1.4.1

16/3/20

Hönnuður:
ARI, HAS
Yfirfarir:
Sambýkt: Davíð Svavarskiöld kt: 100356-3339

Breytingar:
B1 12.02.2009 Reyndartekning

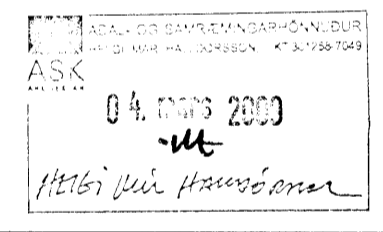

Héðinn
Gjáhella 4
221 Hafnarfjörður

Einlínamynd
T1.4.1
Mkv: Enginn

RTS
VERKFRÆDISTOFA
Grensásvegur 3
108 Reykjavík
Sími 520 9900
Fax 520 9901
www.rts.is

Attek gæðvottun skv
ISO EN ISO 9001:2000

FRV
Fyrir
Væðing

FR 88744