



DREIFITAFLA  
T1.5.1

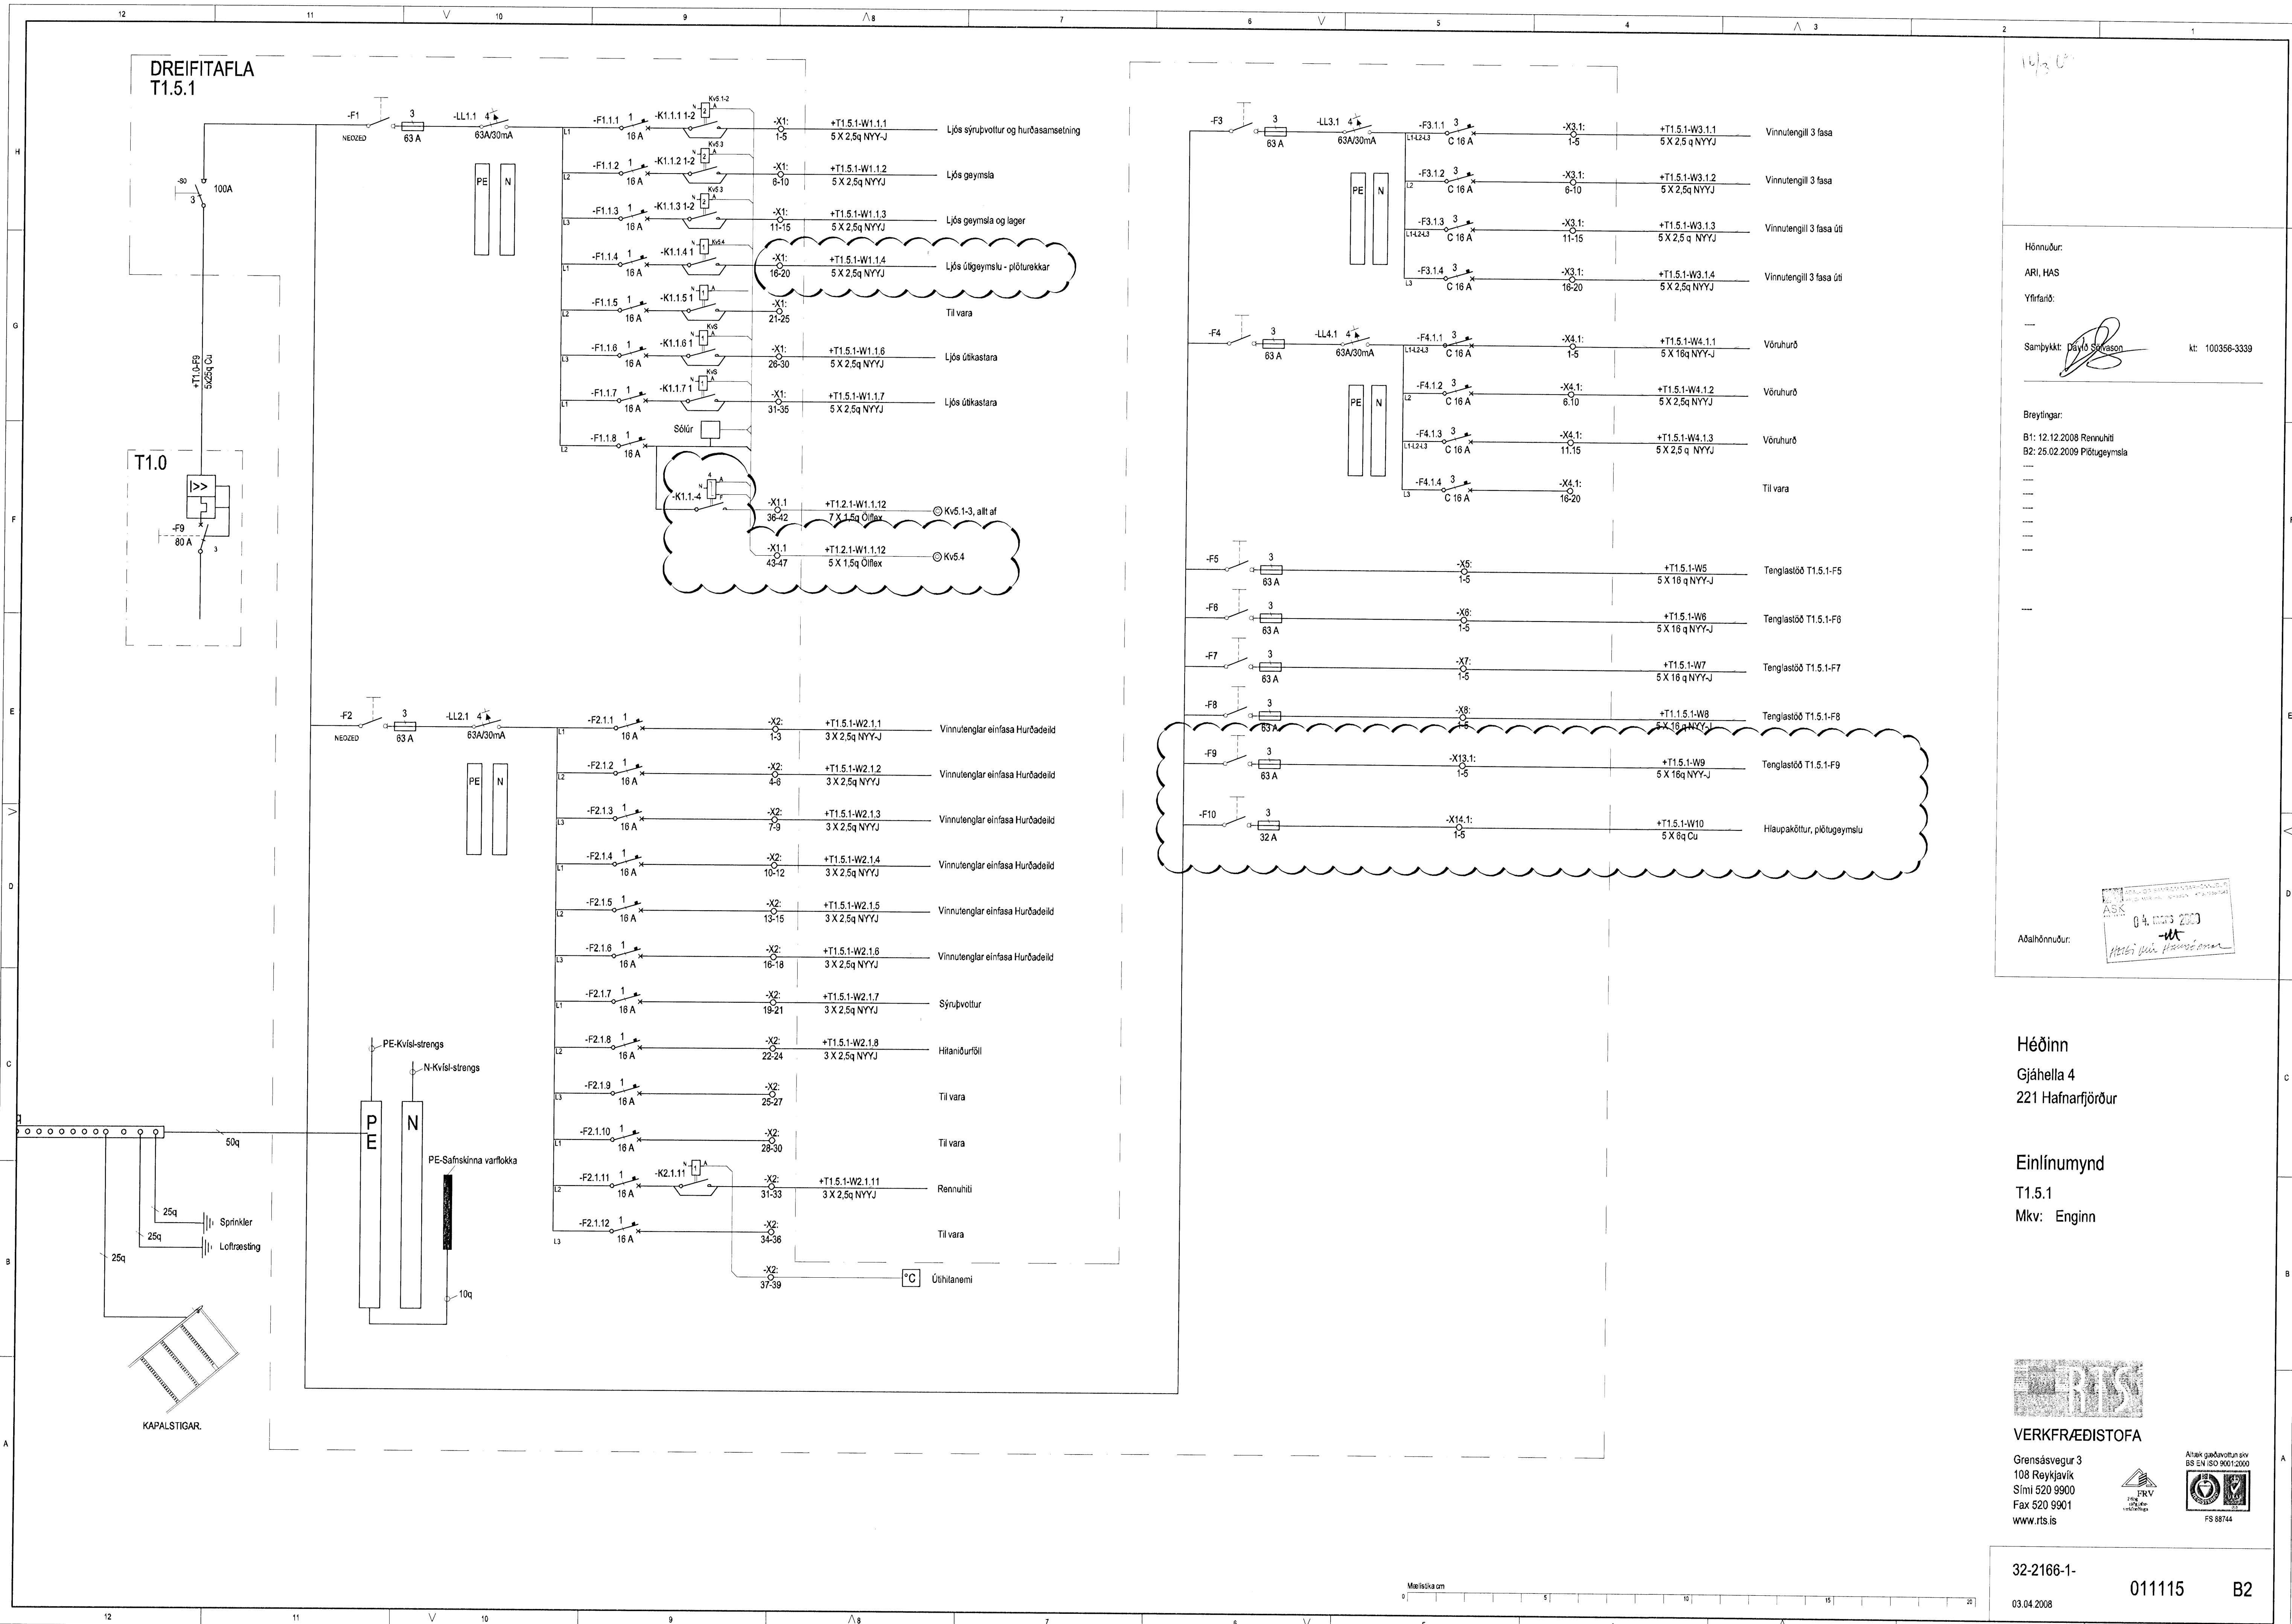

T1.0

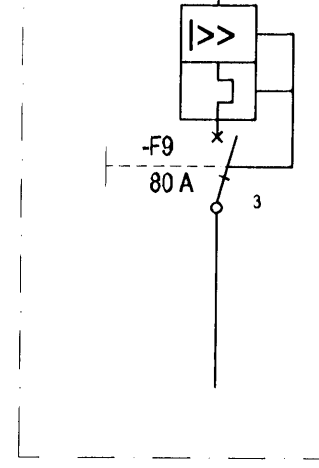

Höfnuður:  
ARI, HAS  
Yfirfarir:  
Sambýkkir: *Dáyo Sigrason* kt: 100356-3339

Breytingar:  
B1: 12.12.2008 Rennuhiti  
B2: 25.02.2009 Plötugeymsla

Aðalhönnuður:  
G 4. MAR 2009  
*Atli Þór Þorsteinsson*

Héðinn  
Gjáhella 4  
221 Hafnarfjörður

Einlínnumynd  
T1.5.1  
Mkv: Enginn

**RTS**  
VERKFRÆÐISTOFA  
Grensásvegur 3  
108 Reykjavík  
Sími 520 9900  
Fax 520 9901  
www.rts.is

Attek gæðvottun örv  
BS EN ISO 9001:2000  
FS 8874

32-2166-1-  
011115 B2  
03.04.2008