


DREIFITAFLA  
T1.3.2

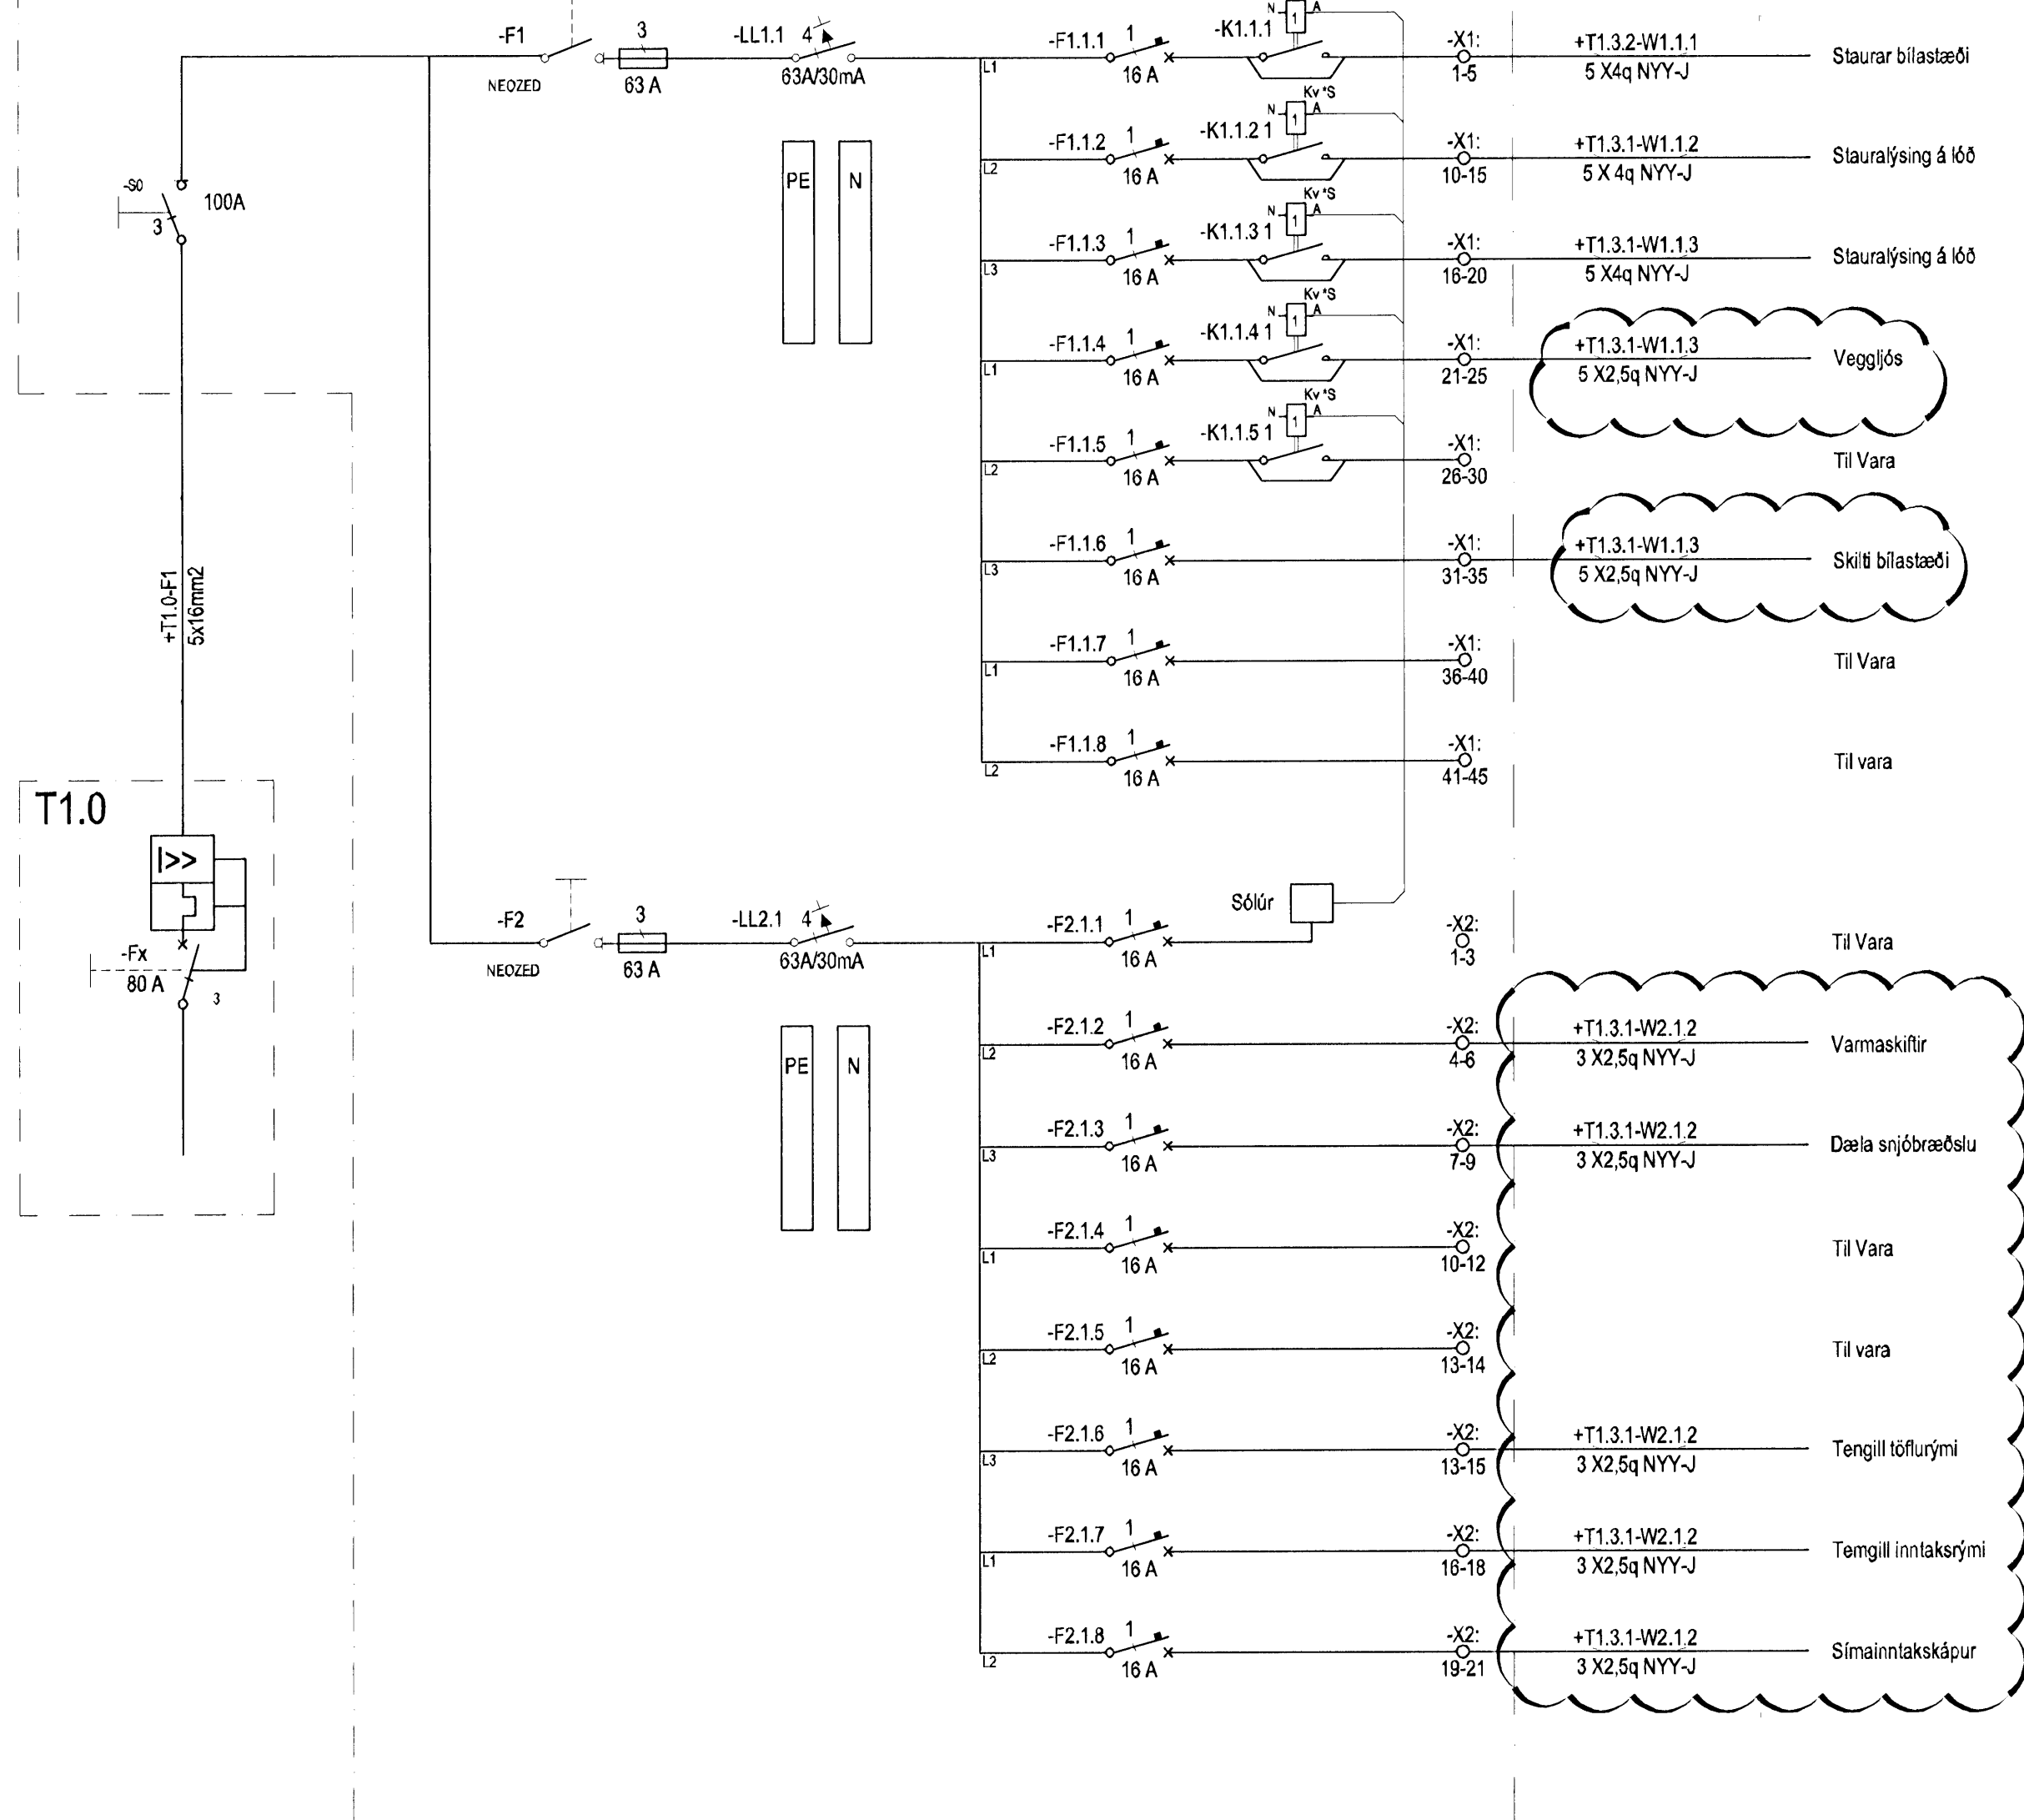

Hönnuður:  
ARI, HAS  
Yfirfarið:  
Sambýkt: David Sólvas  
kt: 100356-3339

Breytingar:  
B1 12.02.2009 Reyndartekning

ASR  
04. mars 2009  
Aðalhönnuður: *[Signature]*

Héðinn  
Gjáhella 4  
221 Hafnarfjörður

Einlínnumynd  
T1.3.2  
Mkv: Enginn



VERKFRÆDISTOFA  
Grensásvegur 3  
108 Reykjavík  
Sími 520 9900  
Fax 520 9901  
www.rts.is



32-2166-1-  
03.04.2008  
011116  
B1

