


Hönnuður:
ARI, HAS
Yfirfarð:
Sambýkkt: Davíð Sökason kt: 100356-3339

Breytingar:
B1: 25.02.2009 Reyndarteikningar

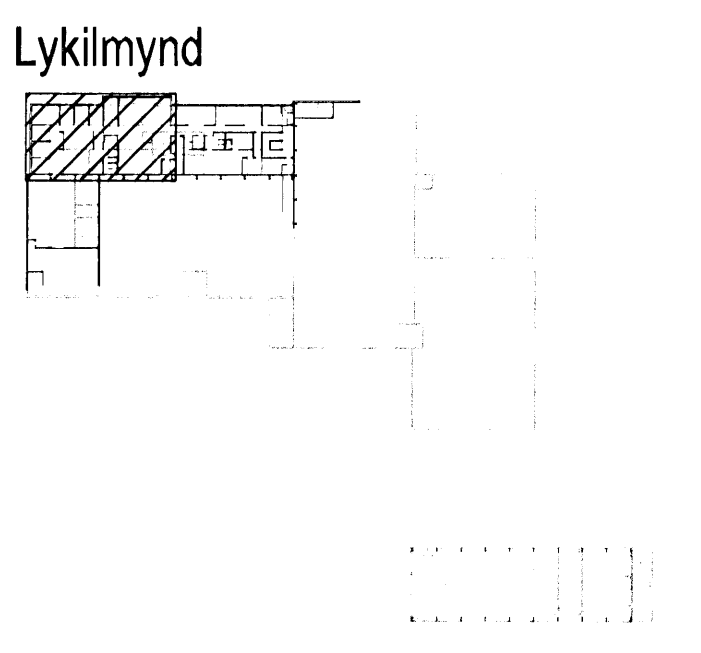

Aðalhönnuður:

Héðinn
Gjáhella 4
221 Hafnarfjörður

Öryggiskerfi
2. hæð
Mkv: 1:50

VERKFRÆDISTOFA

Grensásvegur 3
108 Reykjavík
Sími 520 9900
Fax 520 9901
www.rts.is

Attek gæðvottun skv BS EN ISO 9001:2000
FRV
FS 88744

32-2166-1-
03.04.2008

023201 B1

