


PLG

Höfnuður:
ARI, HAS
Yfirfarð:
Samþykkt: Davíð S. Magnússon kt: 100356-3339


Breytingar:
B1: 25.02.2009 Reyndartekningar

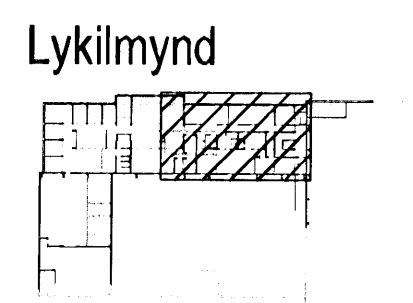

Aðalhöfnuður:
[Signature]


Héðinn
Gjáhella 4
221 Hafnarfjörður

Öryggiskerfi
2. hæð
Mkv: 1:50

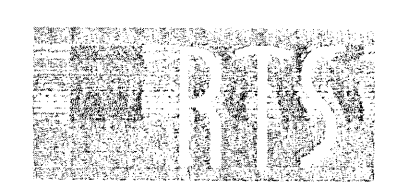

VERKFRÆÐISTOFA
Grensásvegur 3
108 Reykjavík
Sími 520 9900
Fax 520 9901
www.ris.is

Altak gæðvottun skv
BS EN ISO 9001:2000
FRV
FS 8874

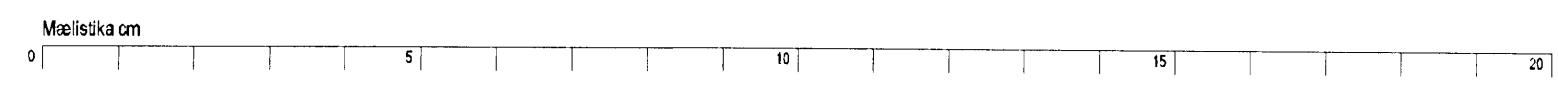

32-2166-1-
03.04.2008 023202 B1