


R.50


Hönnuður:
ARI, HAS
Yfirfarir:
Sambýkkt: Davíð Sölvgeðn kt: 100366-3339

Breytingar:
B1 12.02.2009 Reyndartekning

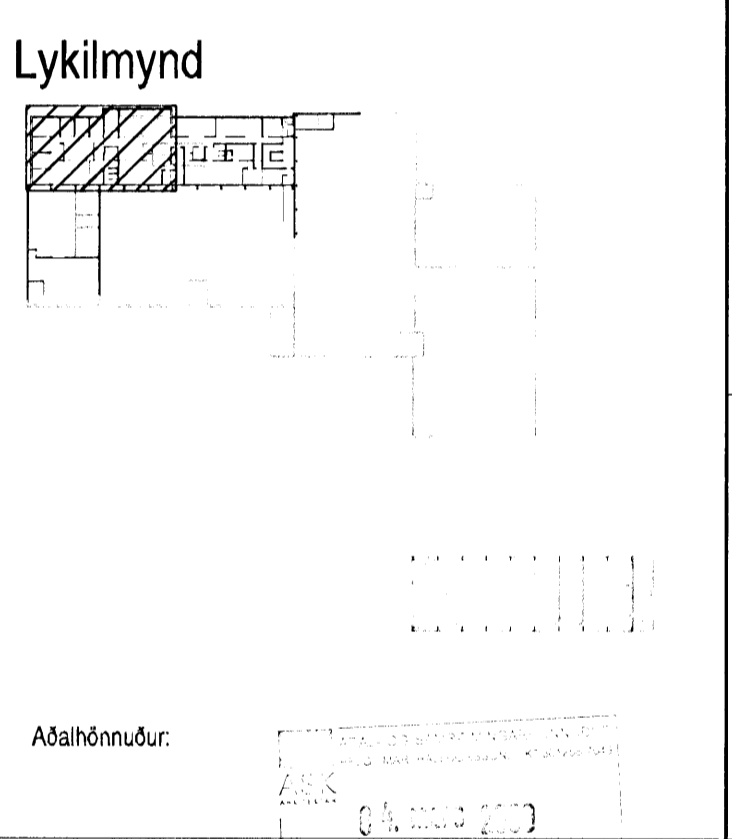

Héðinn
Gjáhella 4
221 Hafnarfjörður

Raflagnir í rafrennur, rafstiga og gólf
2. hæð
Mkv: 1:50

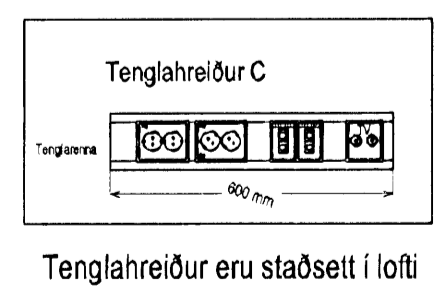

VERKFRÆDISTOFA

Grensásvegur 3
108 Reykjavík
Sími 520 9900
Fax 520 9901
www.rts.is

Atvik gæðvottur úr BS EN ISO 9001:2000

32-2166-1-
03.04.2008

021701 B1