


17/3

Hönnuður:
ARI, HAS
Yfirfarir:

Samþykkt: Davíð Sviggason *[Signature]* kt: 100356-3339

Breytingar:
B1: 25.02.2009 Reyndartekningar

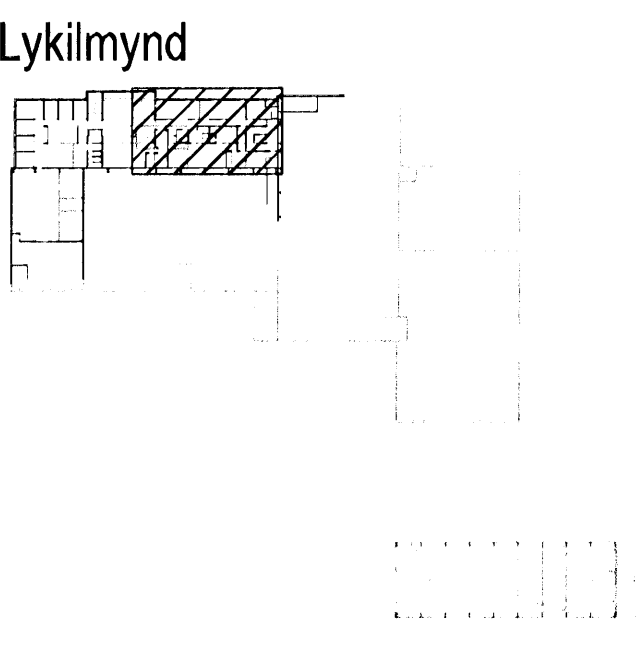

Aðalhönnuður:
[Signature]

Héðinn
Gjáhella 4
221 Hafnarfjörður

Öryggiskerfi
2. hæð
Mkv: 1:50

VERKFRÆDISTOFA
Grensasvegur 3
108 Reykjavík
Sími 520 9900
Fax 520 9901
www.rts.is

Atvarkvæðing
SS-EN ISO 9001:2000
[Logo]
FRV
2004
FS 88744

32-2166-1-
03.04.2008

023203 B1