

ARI

Hönnuður:

ARI, HAS

Yfirfaró:


Sambýkkir: Davíð Spivason

kt: 100356-3339

Breytingar:

- 
- 
- 
- 
- 
- 
- 
- 

Aðalhönnuður:

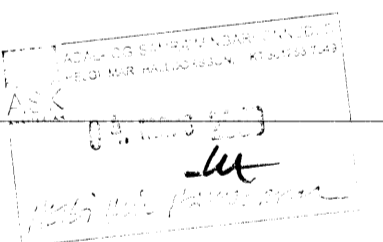

Héðinn  
Gjáhella 4  
221 Hafnarfjörður

Lagnaleiðir, rennur, stigar  
3. hæð  
Mkv: 1:50



VERKFRÆÐISTOFA

Grensásvegur 3  
108 Reykjavík  
Sími 520 9900  
Fax 520 9901  
www.rts.is



Altak gæðvottun skv  
BS EN ISO 9001:2000  
FS 68744

32-2166-1-  
03.04.2008

031401

A

