


ARI

Hönnuður:  
ARI, HAS  
Yfirfarir:  
---  
Samþykkt: Davíð Svavason kt: 100356-3339

Breytingar:  
B1: 12.12.2008 Rennuhli  
---  
---  
---  
---  
---

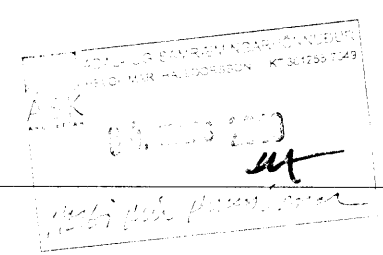

Adalhönnuður:  
  
Héðinn  
Gjáhella 4  
221 Hafnarfjörður

Raflagnir í rafrennur, rafstiga og gólf  
3. hæð  
Mkv: 1:50

**VERKFRÆÐISTOFA**  
Grensásvegur 3  
108 Reykjavík  
Sími 520 9900  
Fax 520 9901  
www.rts.is

Altak gæðvottun skv  
BS EN ISO 9001:2000  
FRV  
FS 88744

32-2166-1-  
03.04.2008  
031701  
B1