


Mótd: 17/3, 2009
Hrólfur

Hönnuður:
ARI, HAS
Yfirfarð:

Samþykkt: Davíð Sálvason *DS* kt: 100358-3339

Breytingar:
B1 12.02.2009 Reyndartekning

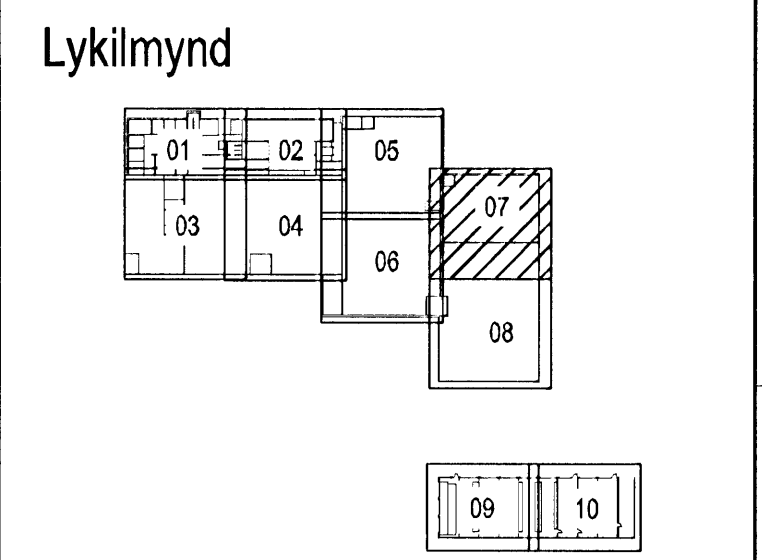

Aðalhönnuður: *[Signature]*

Héðinn
Gjáhella 4
221 Hafnarfjörður

Brunaviðvörunarkerfi
1. hæð
Mkv: 1:50

RTS
VERKFRÆDISTOFA

Grensásvegur 3
108 Reykjavík
Sími 520 9900
Fax 520 9901
www.rts.is

Atlix gæðavottun þev
BS EN ISO 9001:2000

FRV
FS 88744

32-2166-1-
03.04.2008

013407 B1