



TENGIMYND MKV. 1

Samþykkt bann
25 MAR 2009
 Byggingafulltrúinn / Hvínarfrófi
 F.h. Hröflur S. Gunnlaugsson

ÚTGÁFUFERILL

NÚMÉR.	DAGS.	SKRIFINGAR	HAUNAD.
B1	10.10.2006	BYGGINGARTEIKNING	PB
B2	04.05.2007	ÞMSAR BREYTINGAR	PB
B3	23.08.2007	LÖGN AD SNJÓBRÆÐSLU BÉTT VID	PB
R1	30.08.2008	REYNDARTEIKNING	PB

DAGS. UNDRSKRIFTAR: NAFN OG KT. SAMREINGINGARHÖNNUNAR
 UNDRSKRIFT SAMREINGINGARHÖNNUNAR:

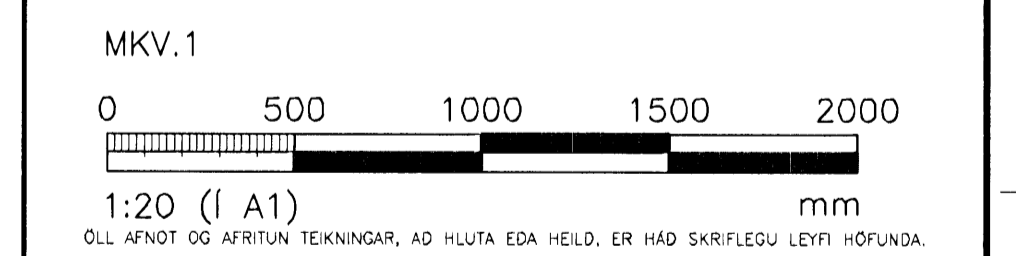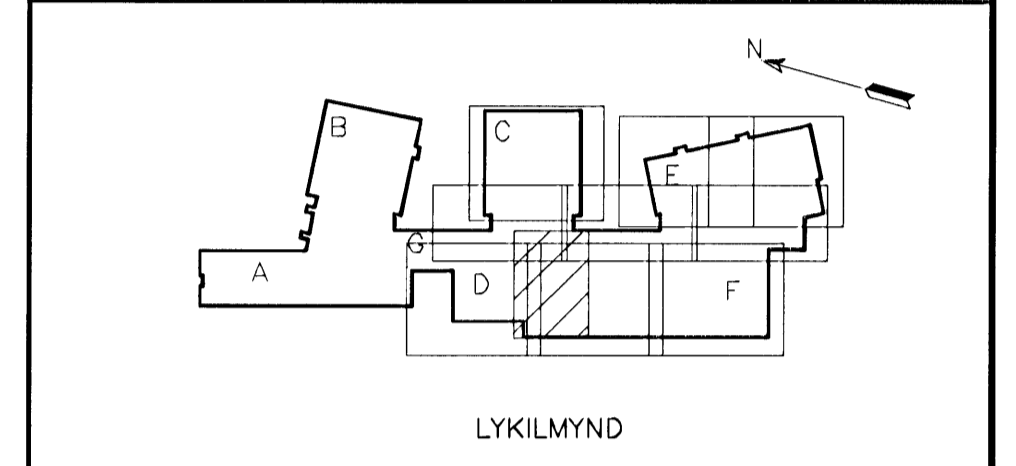

VGK HÖNNUN
 GRENSÁSVEGI 1 · 108 REYKJAVÍK · Sími: 422 3000 · Faxi: 422 3001
 VEFFANG: www.vgkhonnun.is · NETFANG: vgkhonnun@vgkhonnun.is

HEITI VERKS
HRAUNVALLASKÓLI 2. ÁF.
DREKAVELLIR 9, HAFNARFIRDI

HEITI TEKNINGAR:
HITAKERFI:
TÆKNIRÝMI, TENGIMYND

MÆLI:	TEKNAÐ:	DEYMSLUNUMER:	VNR:
HAUNAD:	YFRFARÐ:	MKV:	NR. TEKNINGAR:
DAGS. UNDRSKRIFTAR:	NAFN OG KT. HÖNNUNAR:	P2-465	
UNDRSKRIFT HÖNNUNAR:	ÚTGAFI:	R1	

LÁRUS ÁRSÆLSSON 008625119