



Byggingafultrúi Hafnarfjarðar
Móttækistöð þann 27/6/09
07 AUG 2009
Sigurður Steinar Jónsson

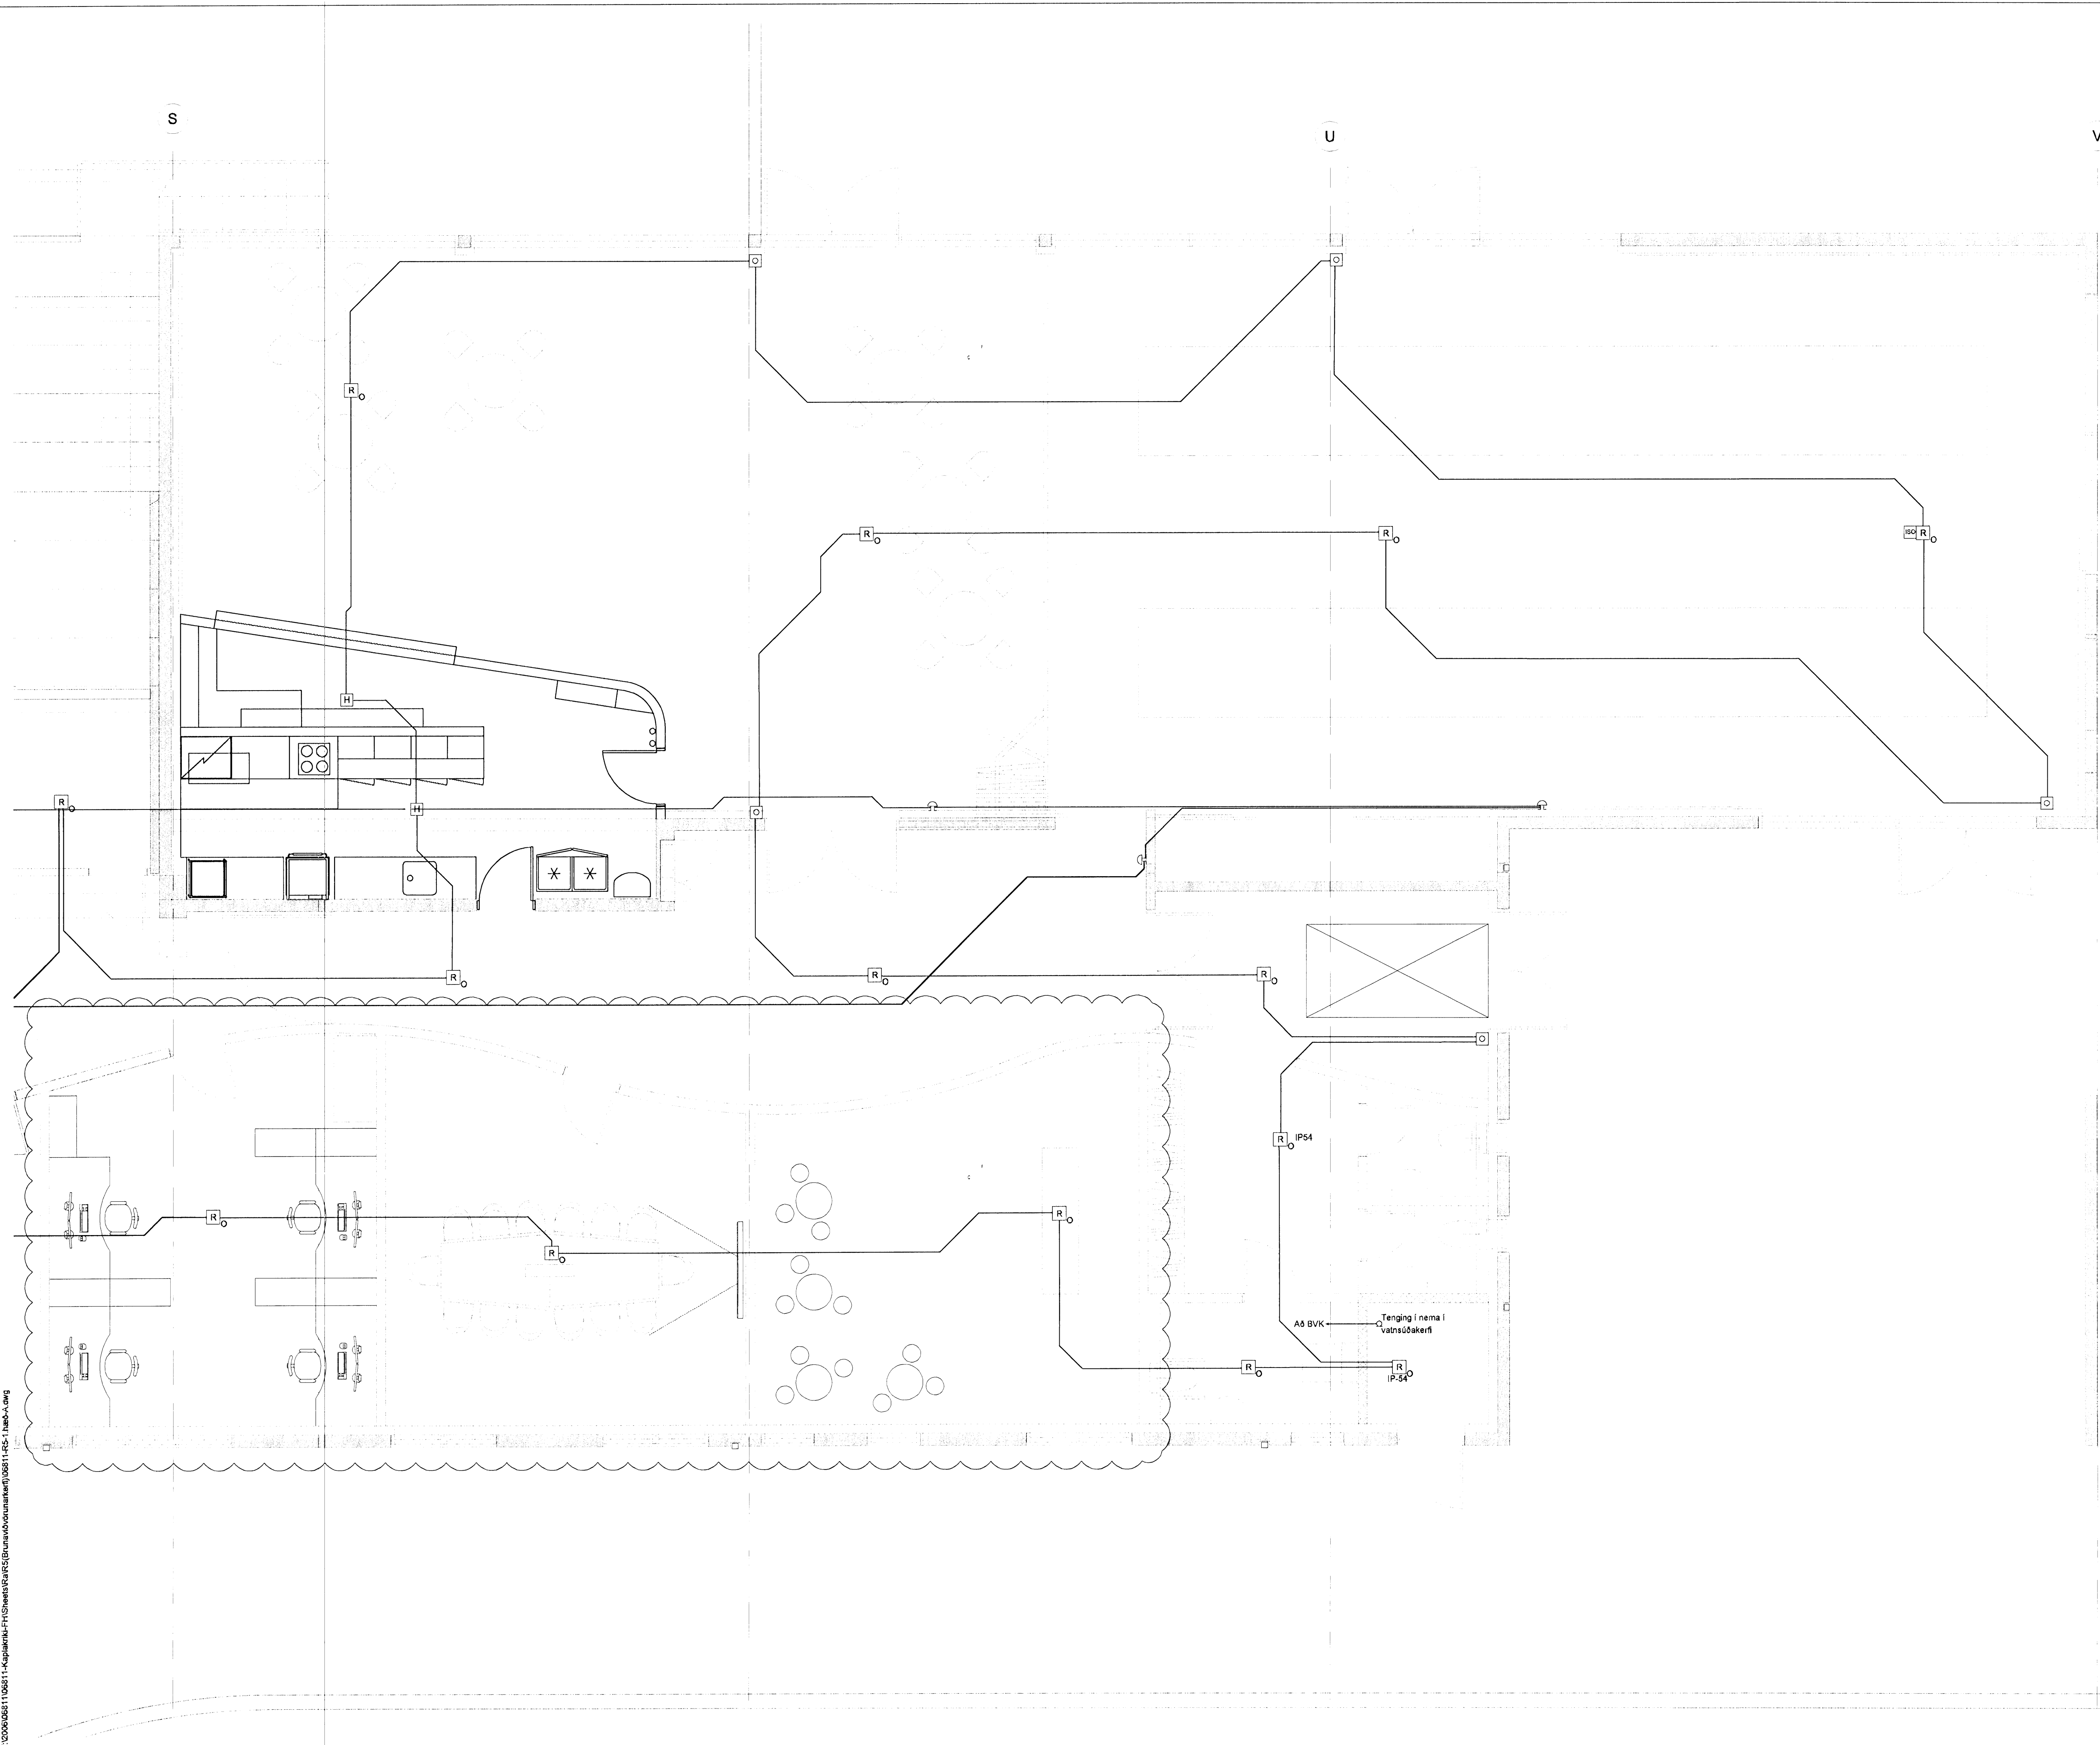

BATTERÍÐ | ARKITEKTAR

Sigurður Steinar Jónsson
Kt. 110457-2789

KAPLAKRIKI

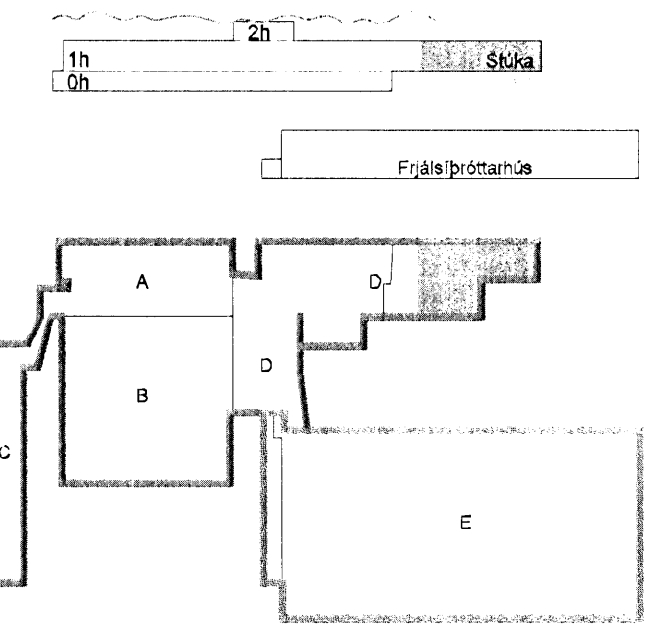

B 12.06.09 Breyting á herbergjum SF/BSG
A 27.11.07 Verkefning RVKHJ
Útg. Dags. Skýring Hannab/Virfarió



VERKFRÆÐISTOFA

BEJARHRAUN 20 · 220 HAFNARFJÓRDUR · KENNIT. 710796-2829
vab@vab.is · Sími 585 8600 · Fax 585 9610 · www.vsb.is

Áritun séðhönnuðar Örn Guðmundsson Kt: 220961-2739

Verkefni: KAPLAKRIKI HAFNARFIRÐI

Verkhliú: Rafkerfi Brunaviðvörðunarkerfi 1.hæð Grunnmynd

Hannab	Teiknað	Virfarió	Kvarði	Síða
RVKHJ	RVKHJ	RVK	1:50	/ A1
Dags.	Verkefni	Teikning	Útgáfa	
30.04.2007	06811	A R514	B	

V:\2006\06811\06811-Kaplakriki\11-Schemu\RVK\Grunnmyndunarkerfi\06811-R514-1.hæð-A.dwg