



ÚTLIT SUÐUR, 1:100

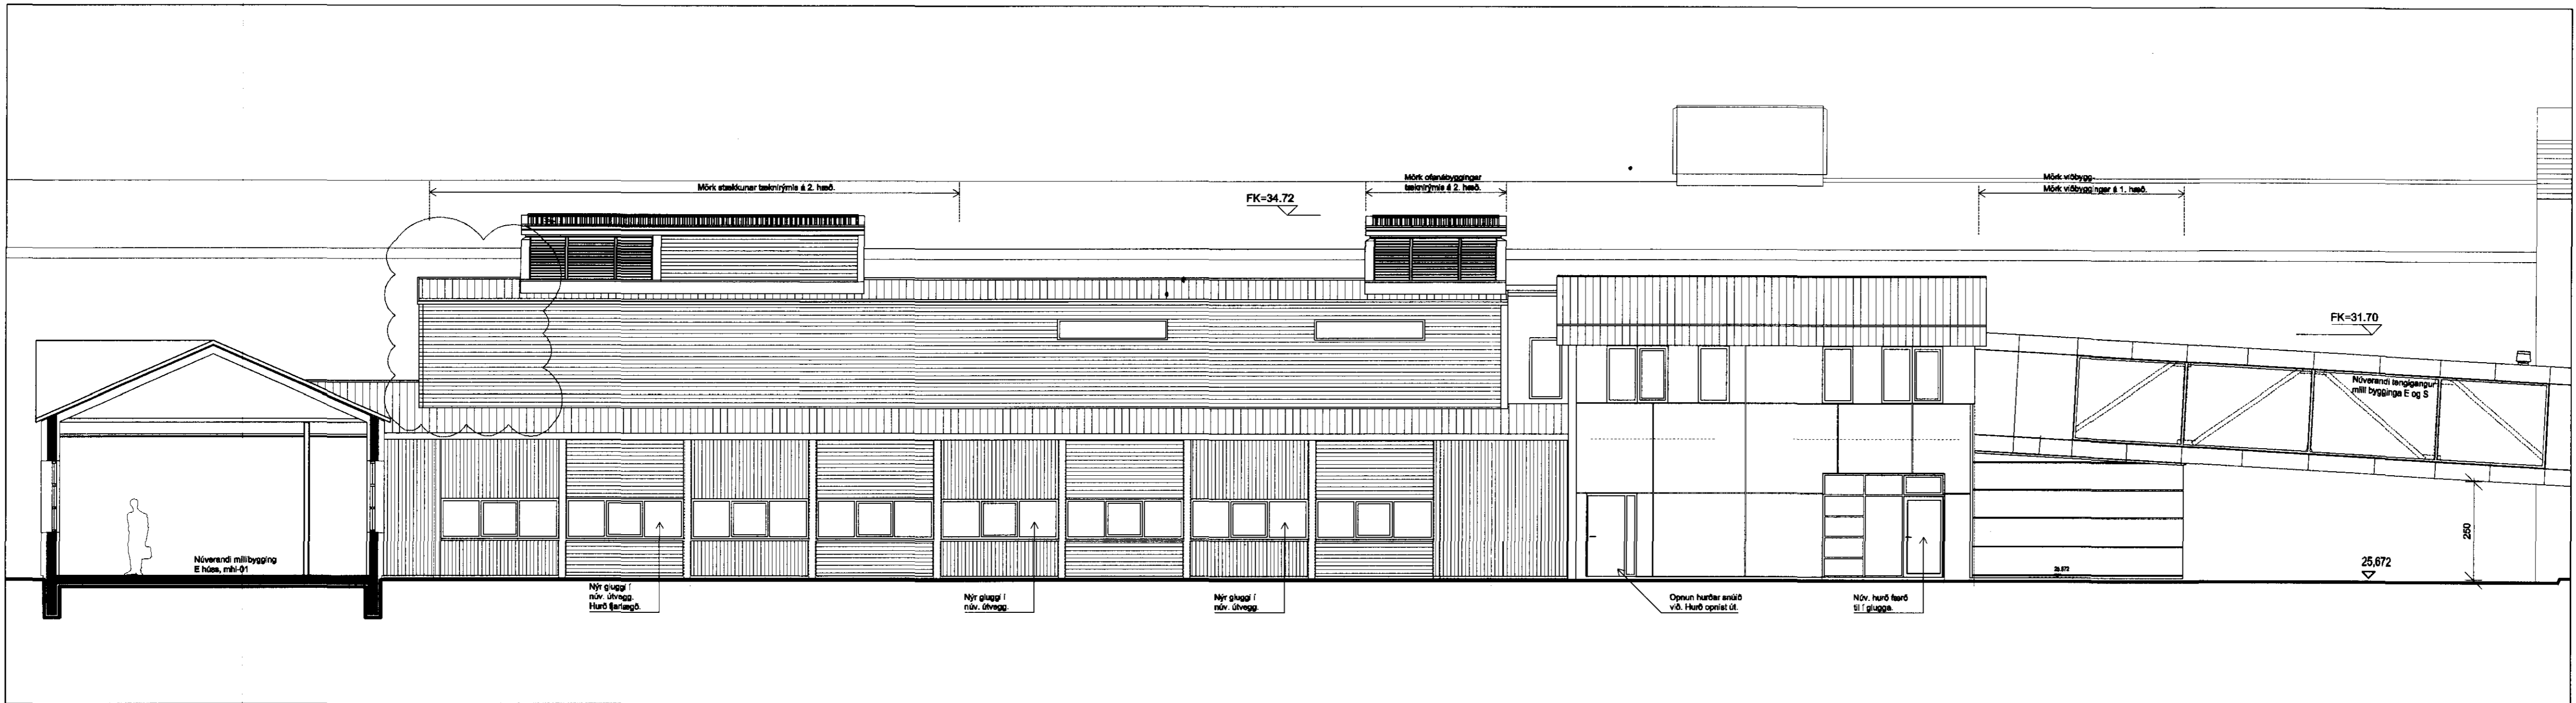


ÚTLIT VESTUR, 1:100

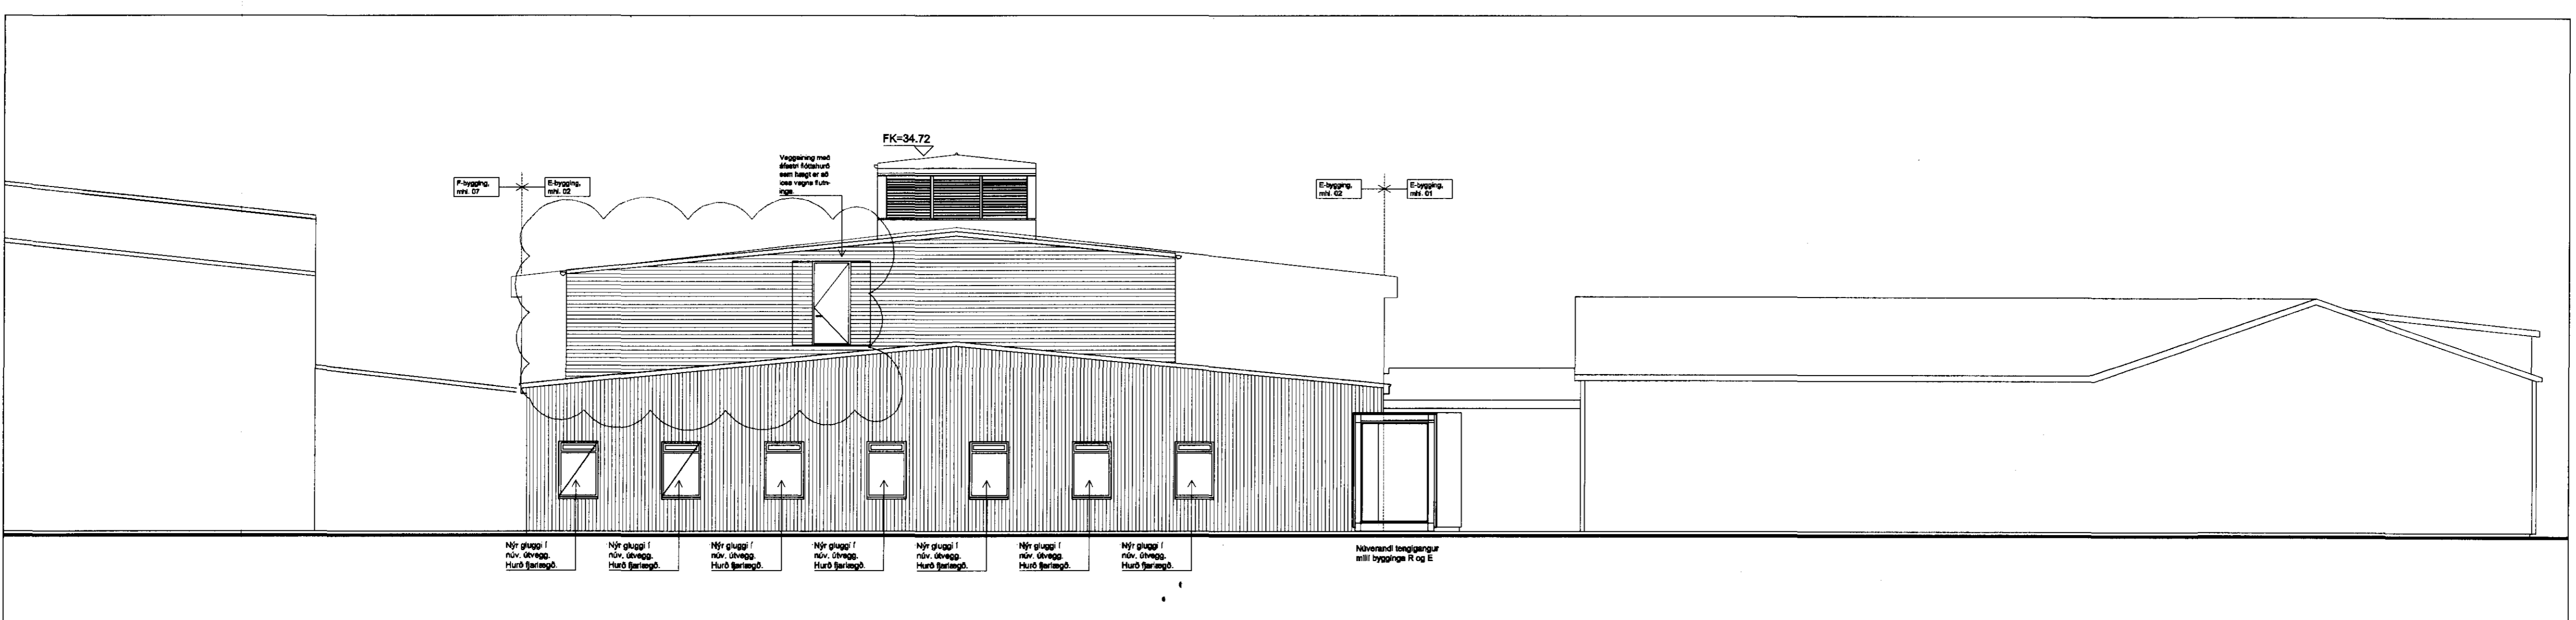


ÚTLIT NORÐUR, 1:100

SKÝRINGAR:

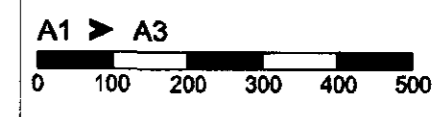

C:
 B:
 A: Stærðskráð talmörkja þaks. 28.07.2010
 BREYTINGAR: DAGS:

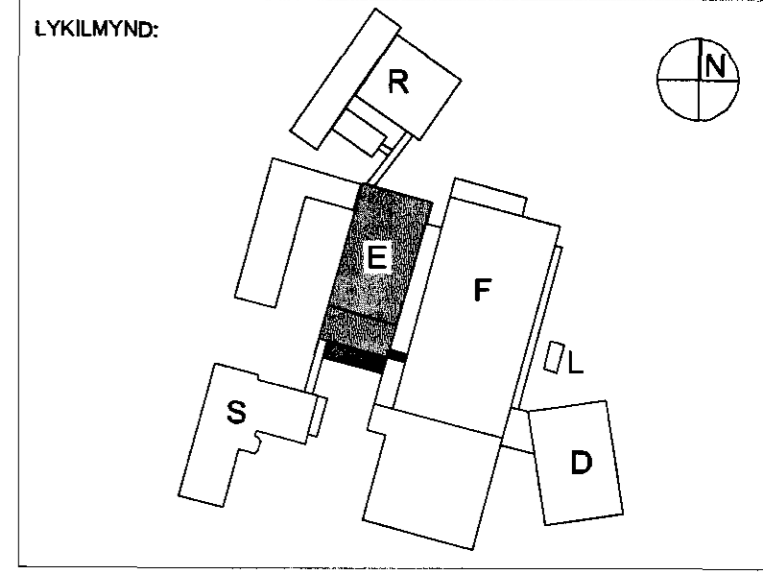

VERKKAUPI:
actavis
 REYKJAVÍKURVEGUR 78.
 BYGGINGARHLUTI: E-BYGGING
 AÐALUPPDRÁTTUR
 ÚTLIT
 VERK: ACTA 0933 DAGS: 19.04.2010
 KVARNI: 1:100 TEIKNAR: BÓSIÓB
 SKRÁ: 0933-E-104.DWG

ÚTI INNI

ARKITEKTAR

ÞINGHOLTSSTRÆTI 27 101 REYKJAVÍK
 Símar 552 7660 & 562 7660 FAX 552 7661
 NETFANG: u@ul.is
 VEFANG: http://www.ul.is

BALDUR Ó. SVAVARSSON ARKITEKTAR FAI
 120357-5149

JÓN ÞÓR ÞORVALDSSON ARKITEKTAR FAI
 021256-7579

TEIKNINGANR: **A-E-104** BREYTING: **A**