



Samþykkt þarh  
 27 OCT 2010  
 Byggingafulltrúi  
 F.H. Sigurður Steinar Jónsson




Ásýnd - Suður  
 mkv. 1:100

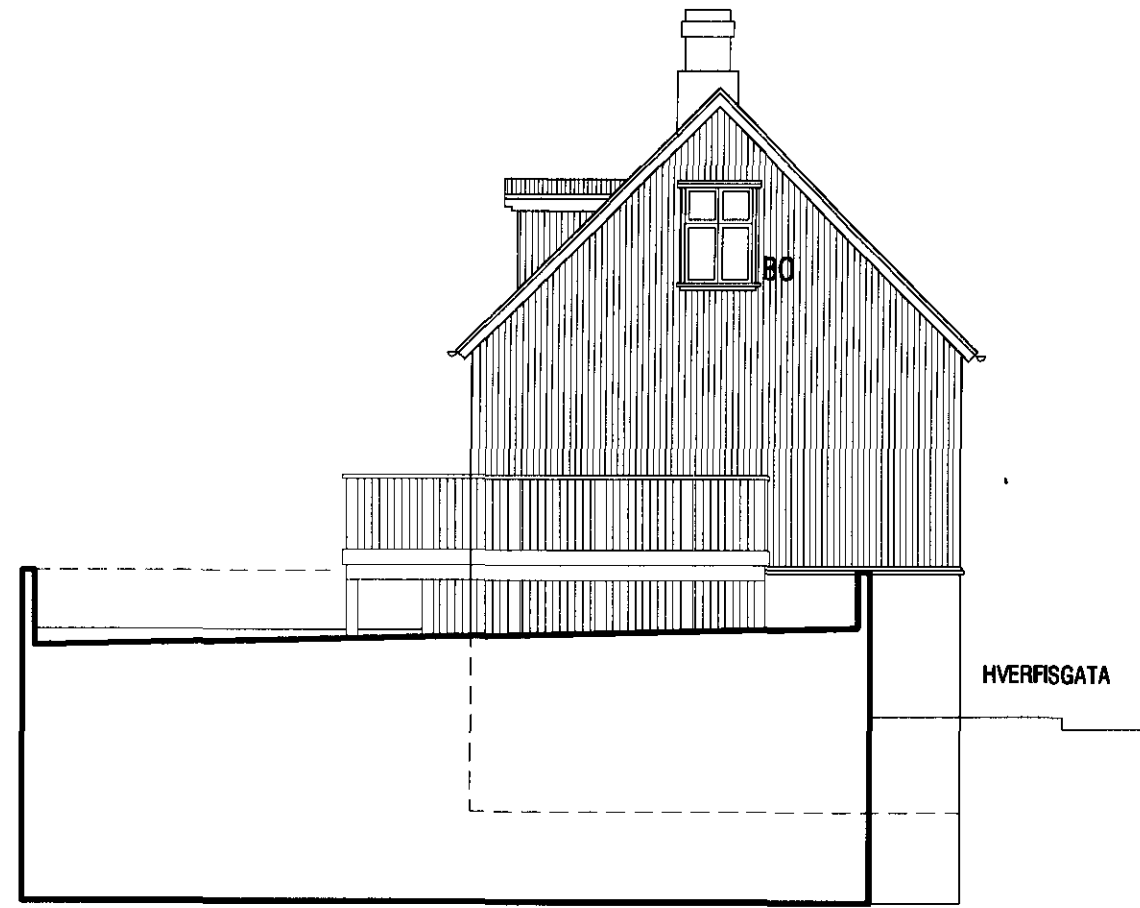

Ásýnd - Austur  
 mkv. 1:100

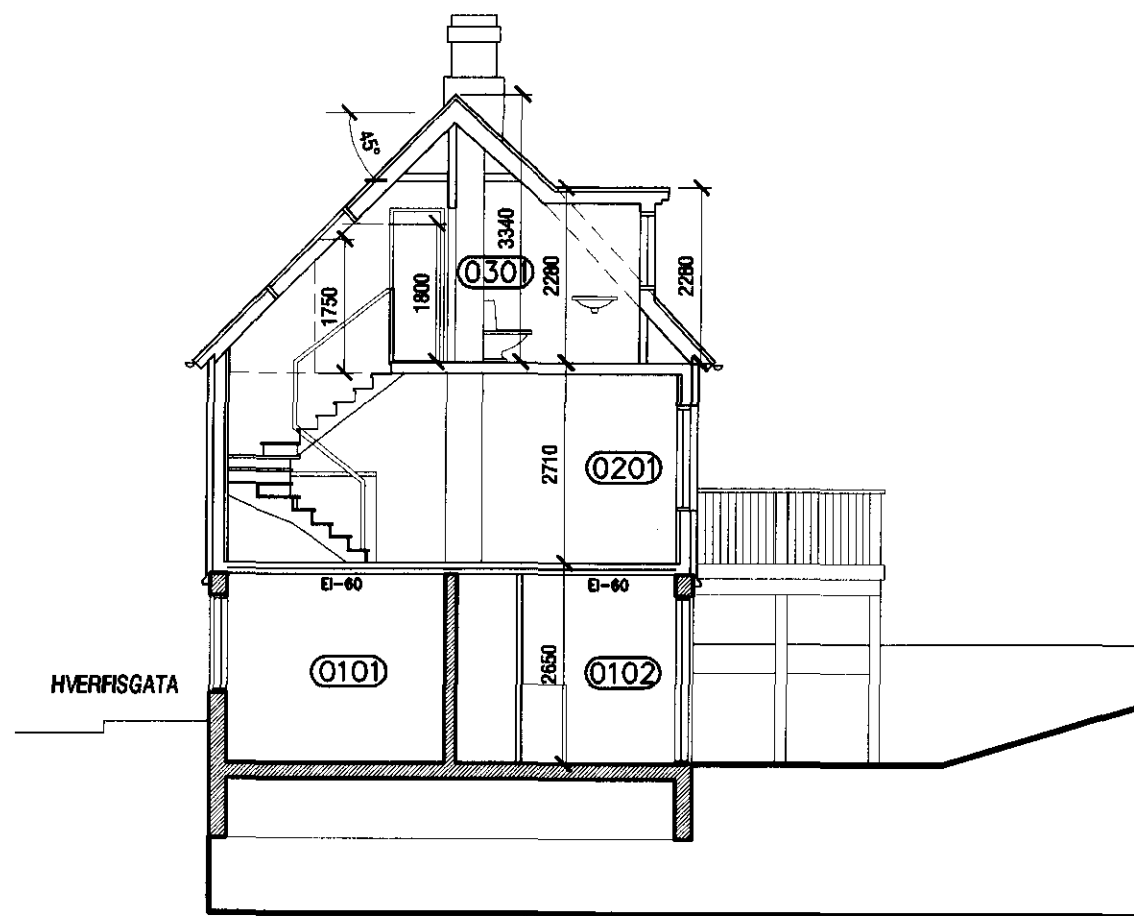


Sneiðing A-A  
 mkv. 1:100

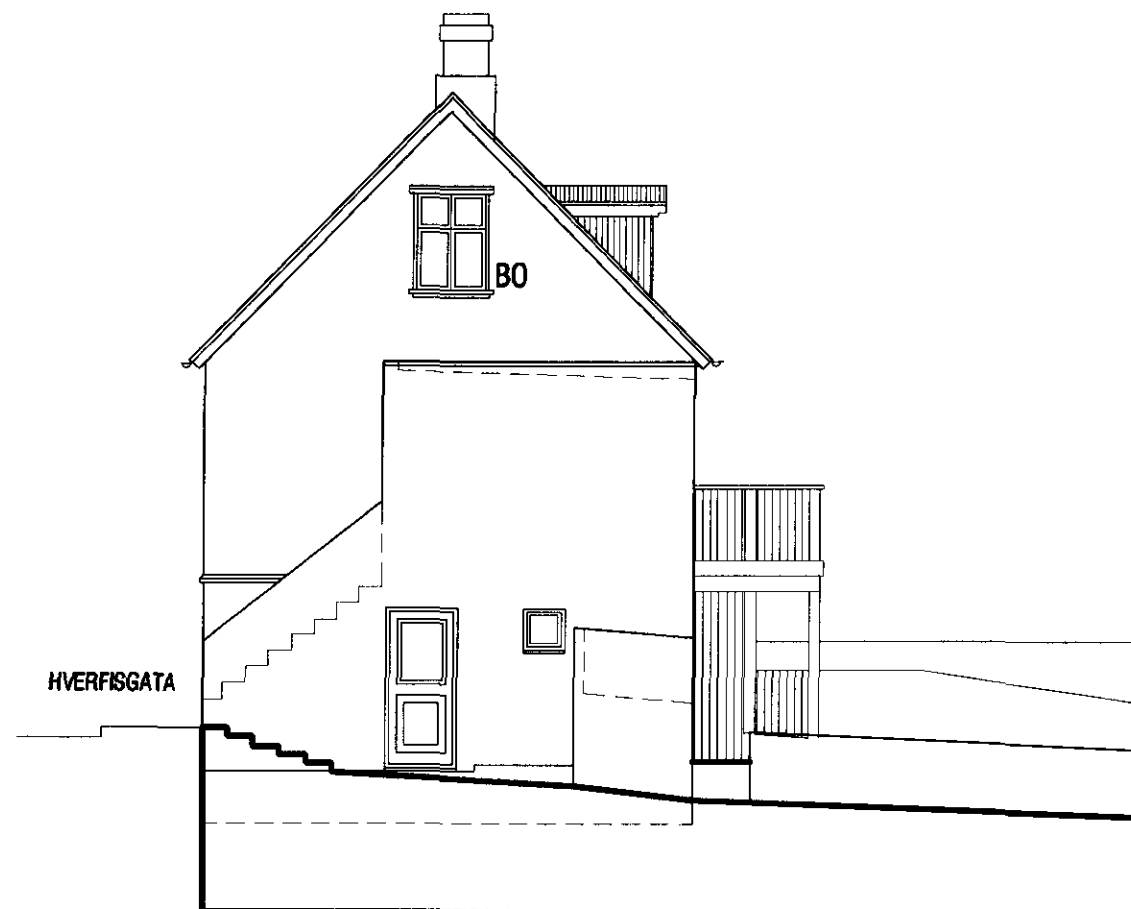

Ásýnd - Norður  
 mkv. 1:100



Ásýnd - Vestur  
 mkv. 1:100

 **verkstæði arkitekta**  
 KÁRINEIRIKSSON arkitekt FAÍ - kt: 070365-4059 - VERKSTÆÐI ARKITEKTA ehf  
 Gunnarsundi 5 - 220 Hlj. - sími: 565 9779 - email: aok@aok.is - www.aok.is

HVERFIGATA 52 - HAFNARFJÖRDUR 10/09  
 Reyndarteikning / breytingar

ADALUPPDRAÁTTUR mkv. 1:100

ásýndir 0202  
 sneiðing A-A

hannað: KE teiknað: KE dags: 6.sept. 2010

breyting A:  
 breyting B:  
 breyting C:  
 breyting D:

**A2** ATH! Öll mál eru í millimetrum. Öll vafatríði skal bera undir hönnuð.  
 Máló ekki af teikningum, öll mál athugist á staðnum.  
 Öll afnot og afritun teikninga, að hluta eða í heild, er háð skriflegu leyfi höfundar.