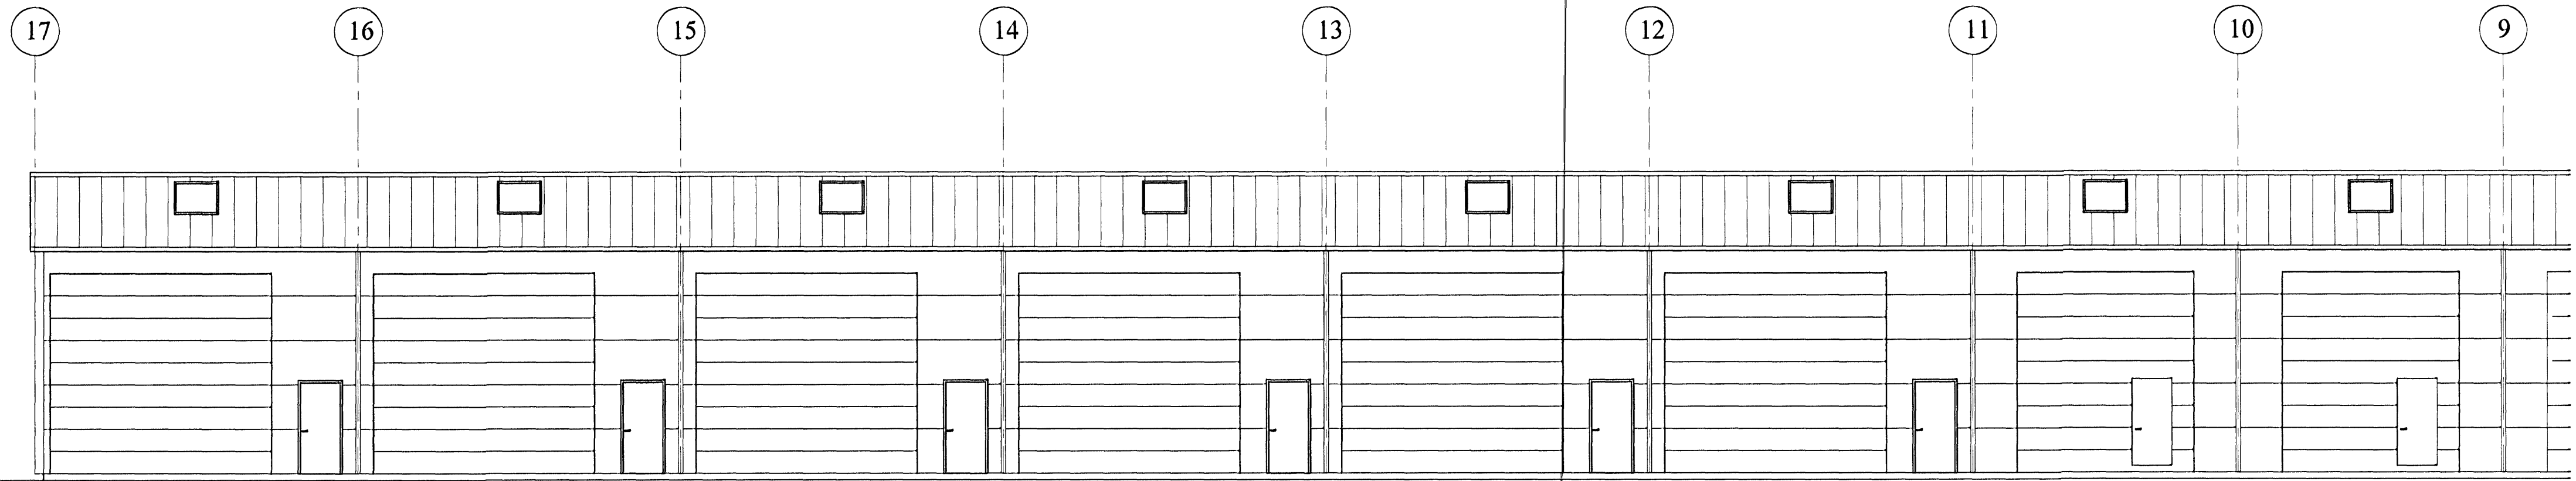


ÚTLIT, NORDUR 1:100

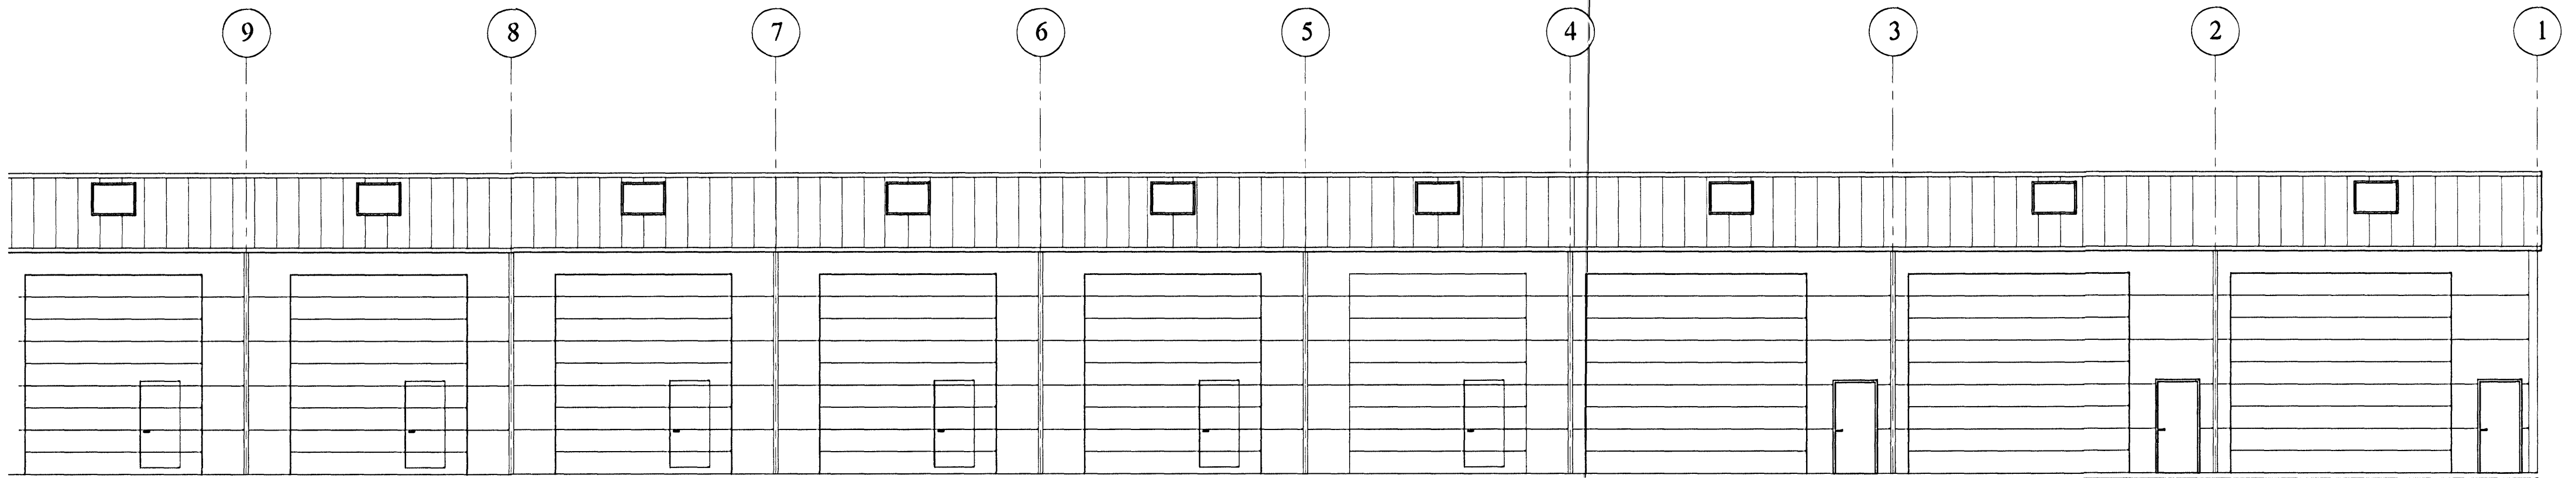

 Samþykkt þann
 18 JUN 2008
 Byggingafulltrúinn í Vánarfirði
 F.h. Jón Sigurðsson

HÖNNUDUR HÚSS: SIGURBJARTUR HALLDÓRSSON




ÚTLIT, AUSTUR 1:100

01-11



ÚTLIT, AUSTUR 1:100

| | | | | |
|---|----------------------------|--|--|--|
|  | NÝJA TEIKNISTOFAN EHF | | RAUDHELLA 1 HLUTI 01-11 BÍLA OG TÆKJAGEYMSLA ÚTLIT REYNDARTEIKNING | |
| | SIDUMULA 20 | | VERK NR 4-B | |
| | 108 REYKJAVÍK | | MÁL 1:100 DAGS 2.08.2008 | |
| | Sími 568 8899 FAX 568 0868 | | H9/SIGURDUR EINARSSON 140432-4749 | |