




Samþykkt þann


18 JUN 2008

Byggingafurðir/Flárnartíð
Fh. Jón Sigurðsson


HÖNNUÐUR HÜSS: SIGURBJARTUR HALLDÓRSSON

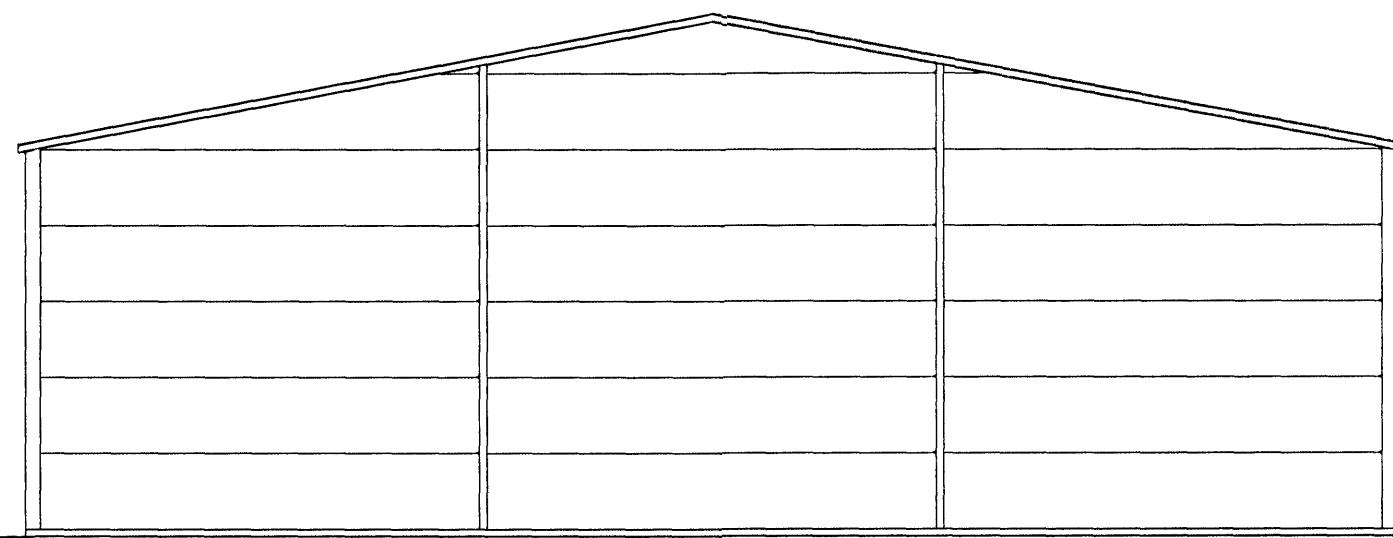

ÚTLIT, SUDUR 1:100

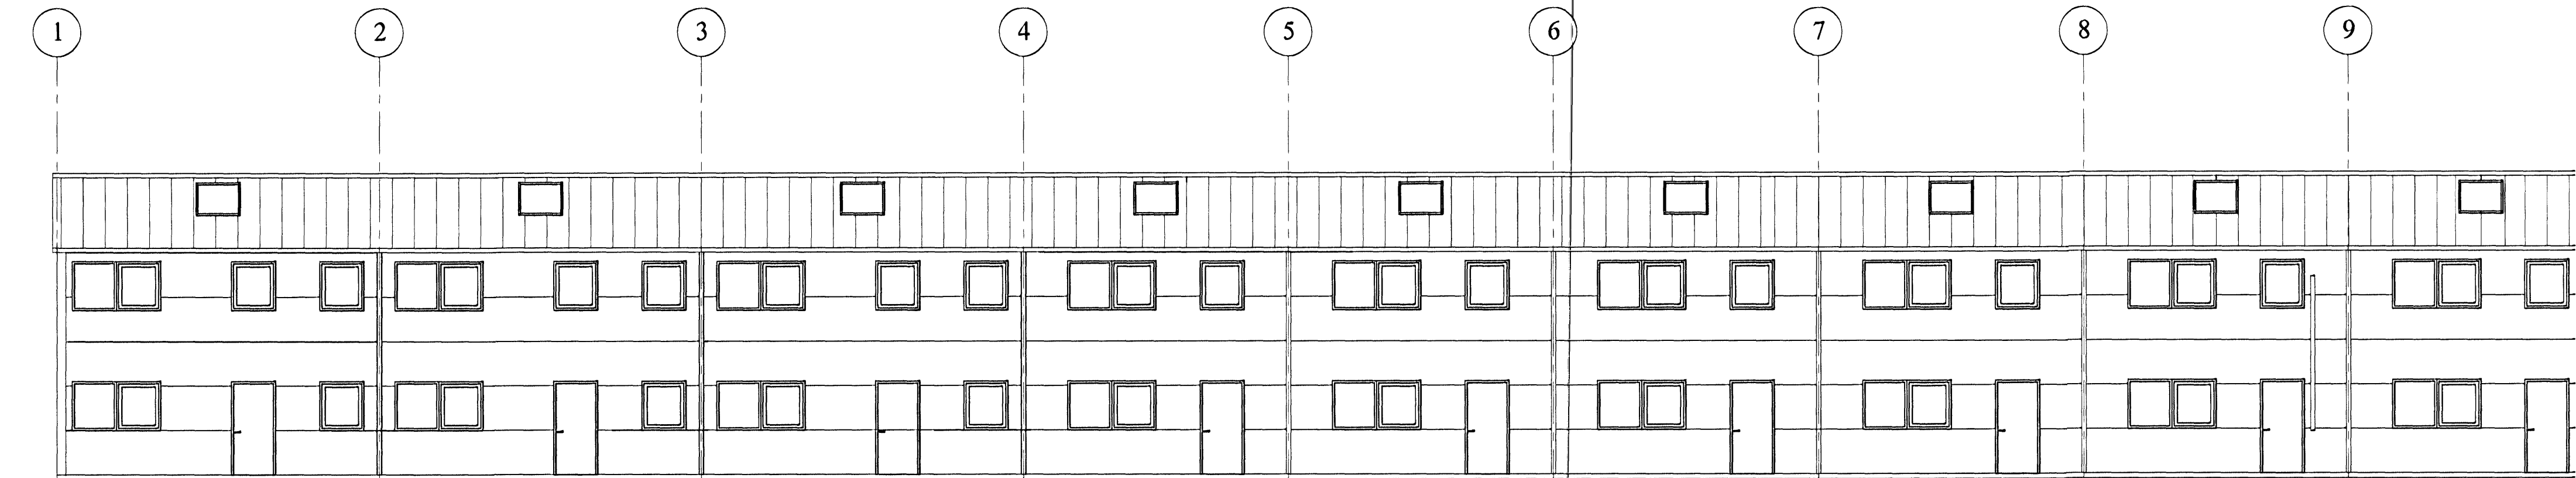

ÚTLIT, VESTUR 1:100

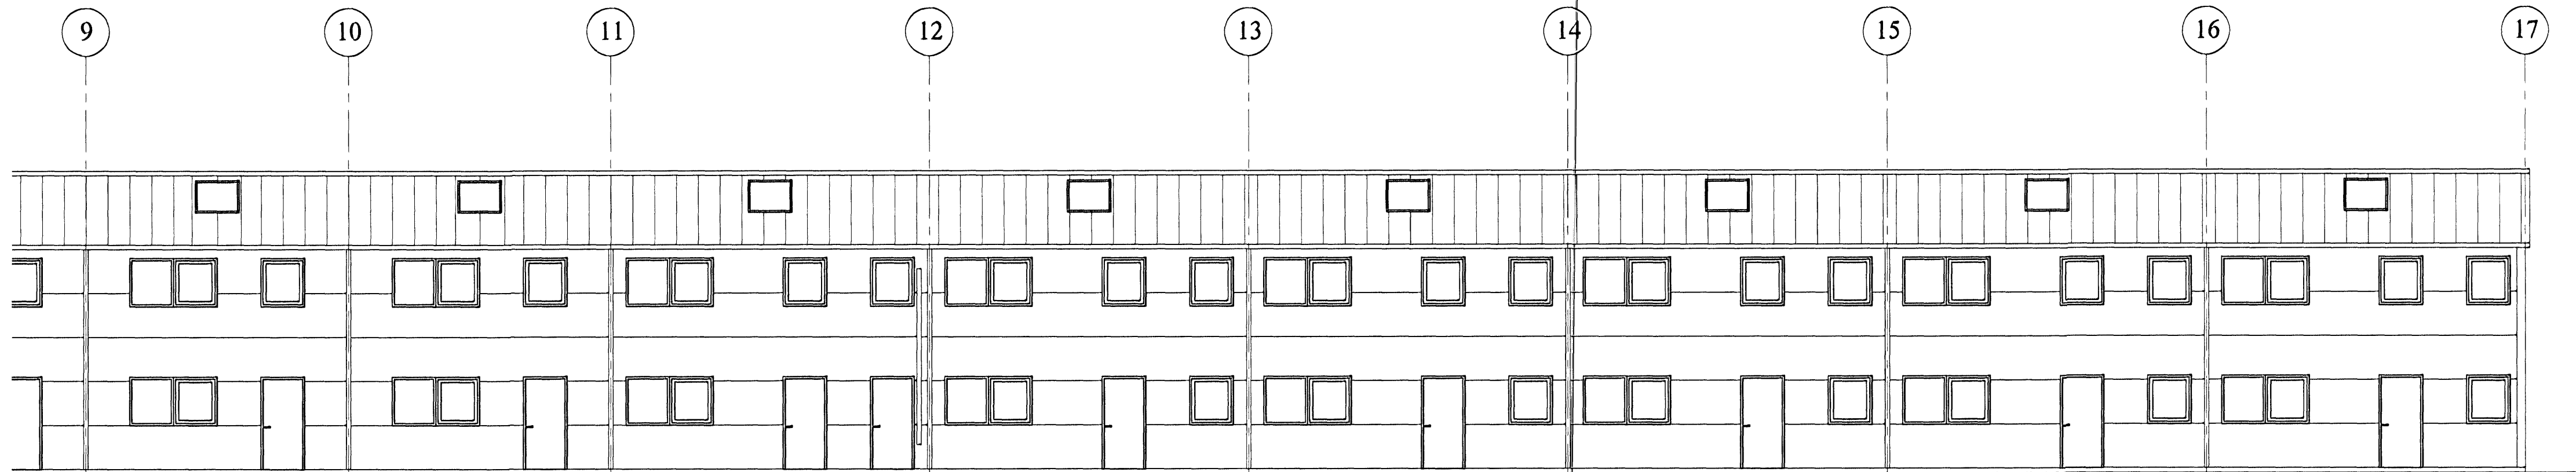

ÚTLIT, VESTUR 1:100

01-11



NÝJA
TEIKNISTOFAN EHF
SIDUMULA 20
108 REYKJAVÍK
SÍMI 568 8899 FAX 568 0868

RAUÐHELLA 1
HLUTI 01-11 BÍLA OG TÆKJAGEYMSLA
ÚTLIT REYNDARTEIKNING

VERK NR 4-A
MÁL 1:100 DÁGS 2.08.2008
HS/SIGURDUR EINARSSON 140432-4749

Sigbjartur Halldórsson