




Samþykkt þann

18 JUN 2008

Byggingarkennitala Hafnarfirði
Eh. Jón Sigurðsson

HÖNNUDUR HÚSS: SIGURBJARTUR HALLDÓRSSON

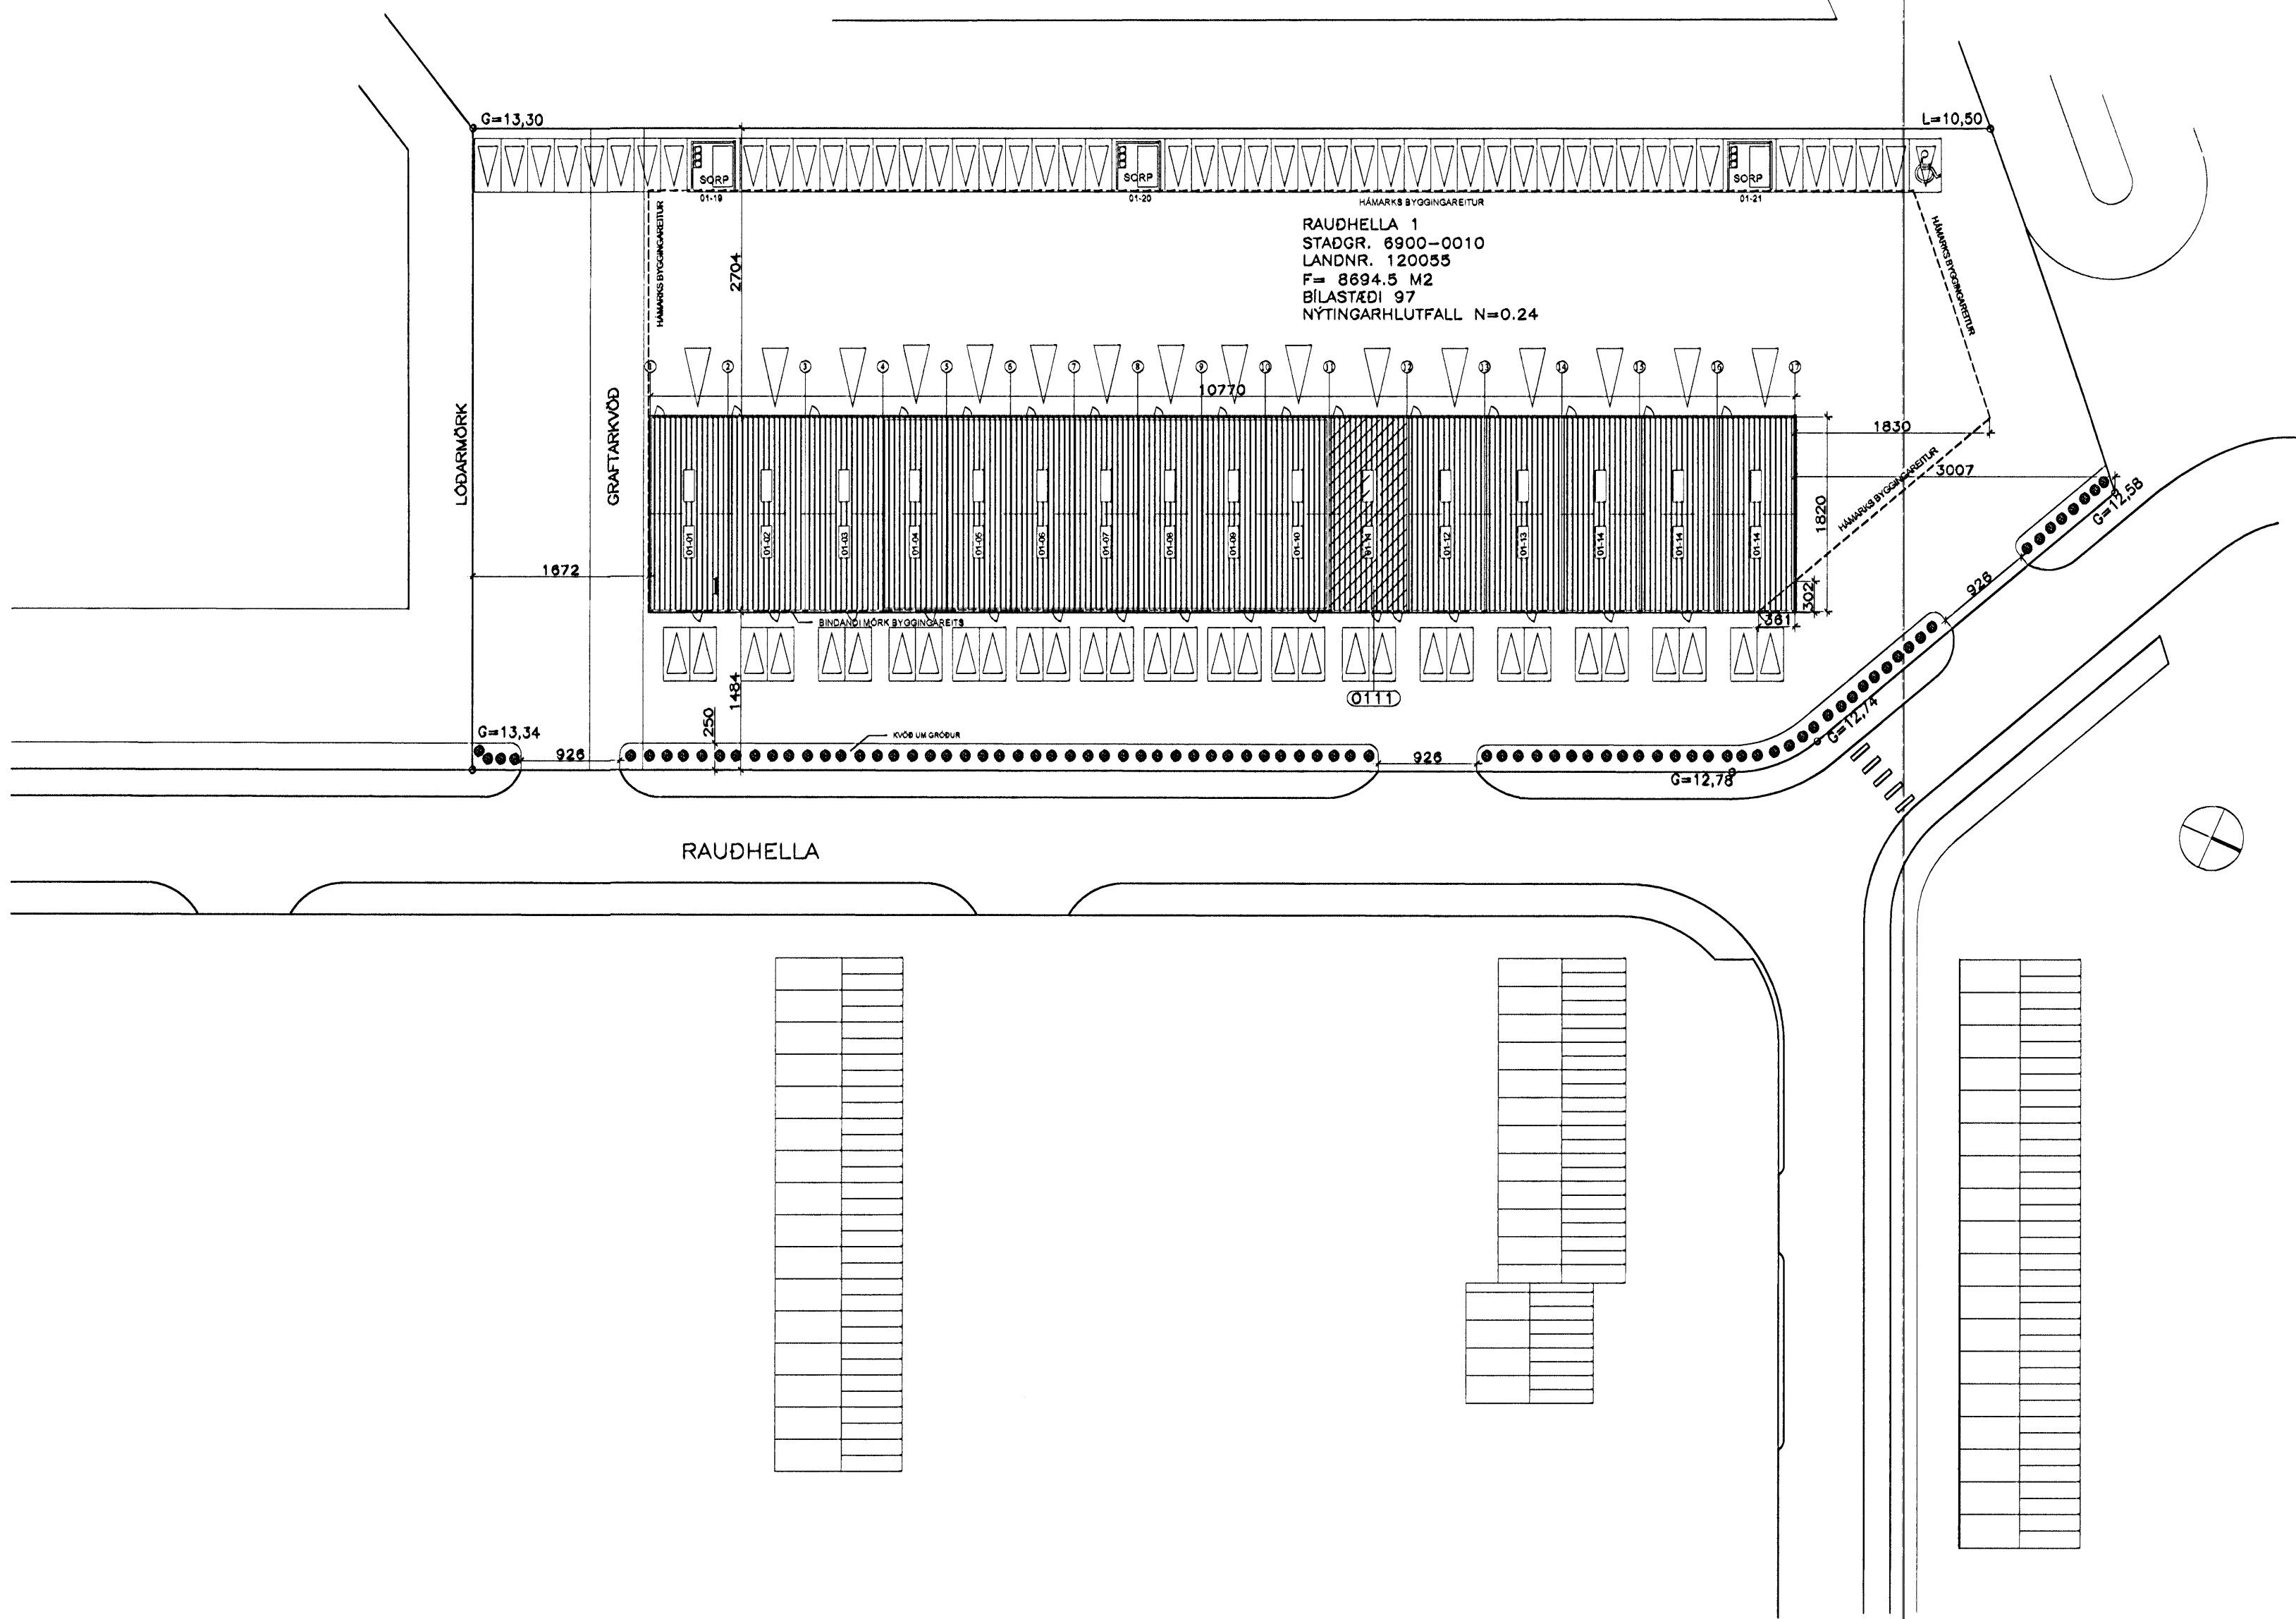

NÝJA
TEIKNISTOFAN EHF

SIÐUMÚLA 20
108 REYKJAVÍK
SÍMI 568 8899 FAX 568 0868

RAUDHELLA 1
HLUTI 01-11 BÍLA OG TÆKJAGEYMSLA
AFSTÖÐUMYND REYNDARTEIKNING

VERK NR 1
MÁL 1:500 DAGS 2.06.2008

HS/SIGURDUR EINARSSON 140432-4749