



A SNID MKV. 2


F SNID MKV. 1

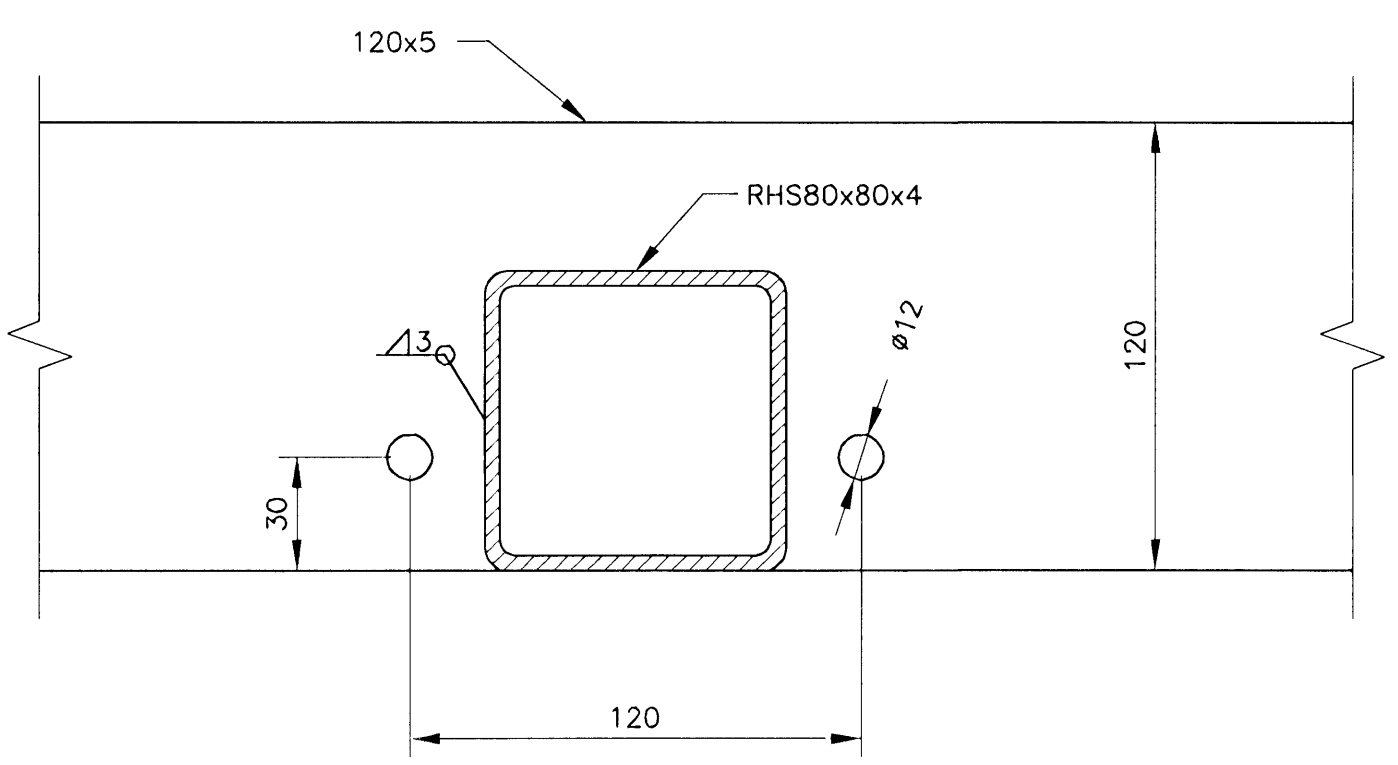

B SNID MKV. 2

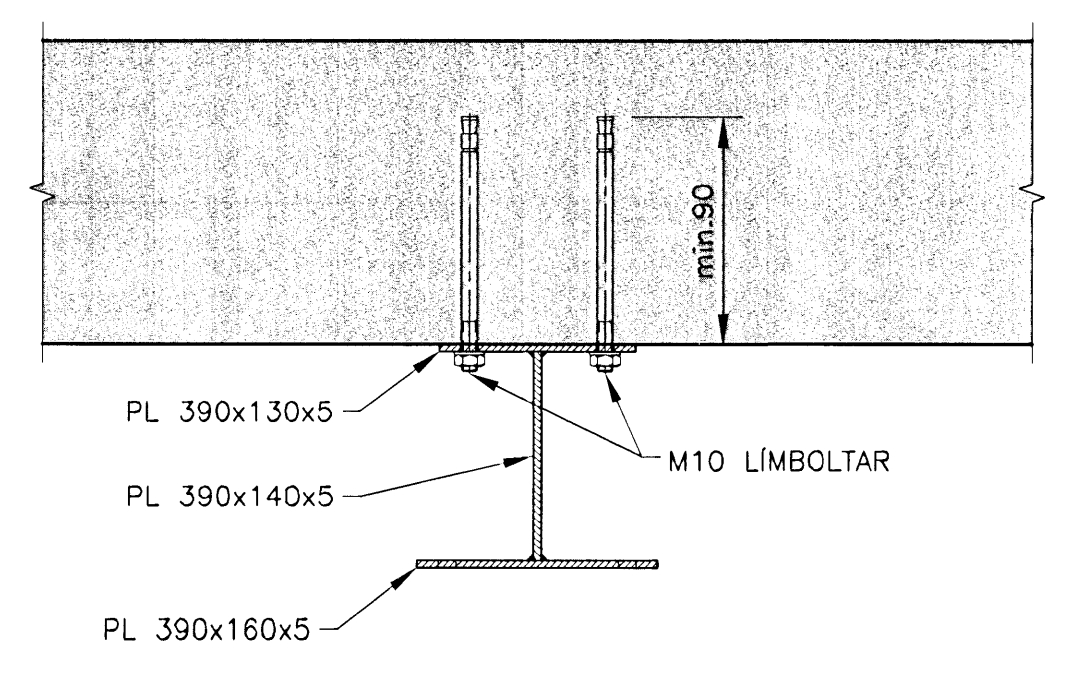


C SNID MKV. 1

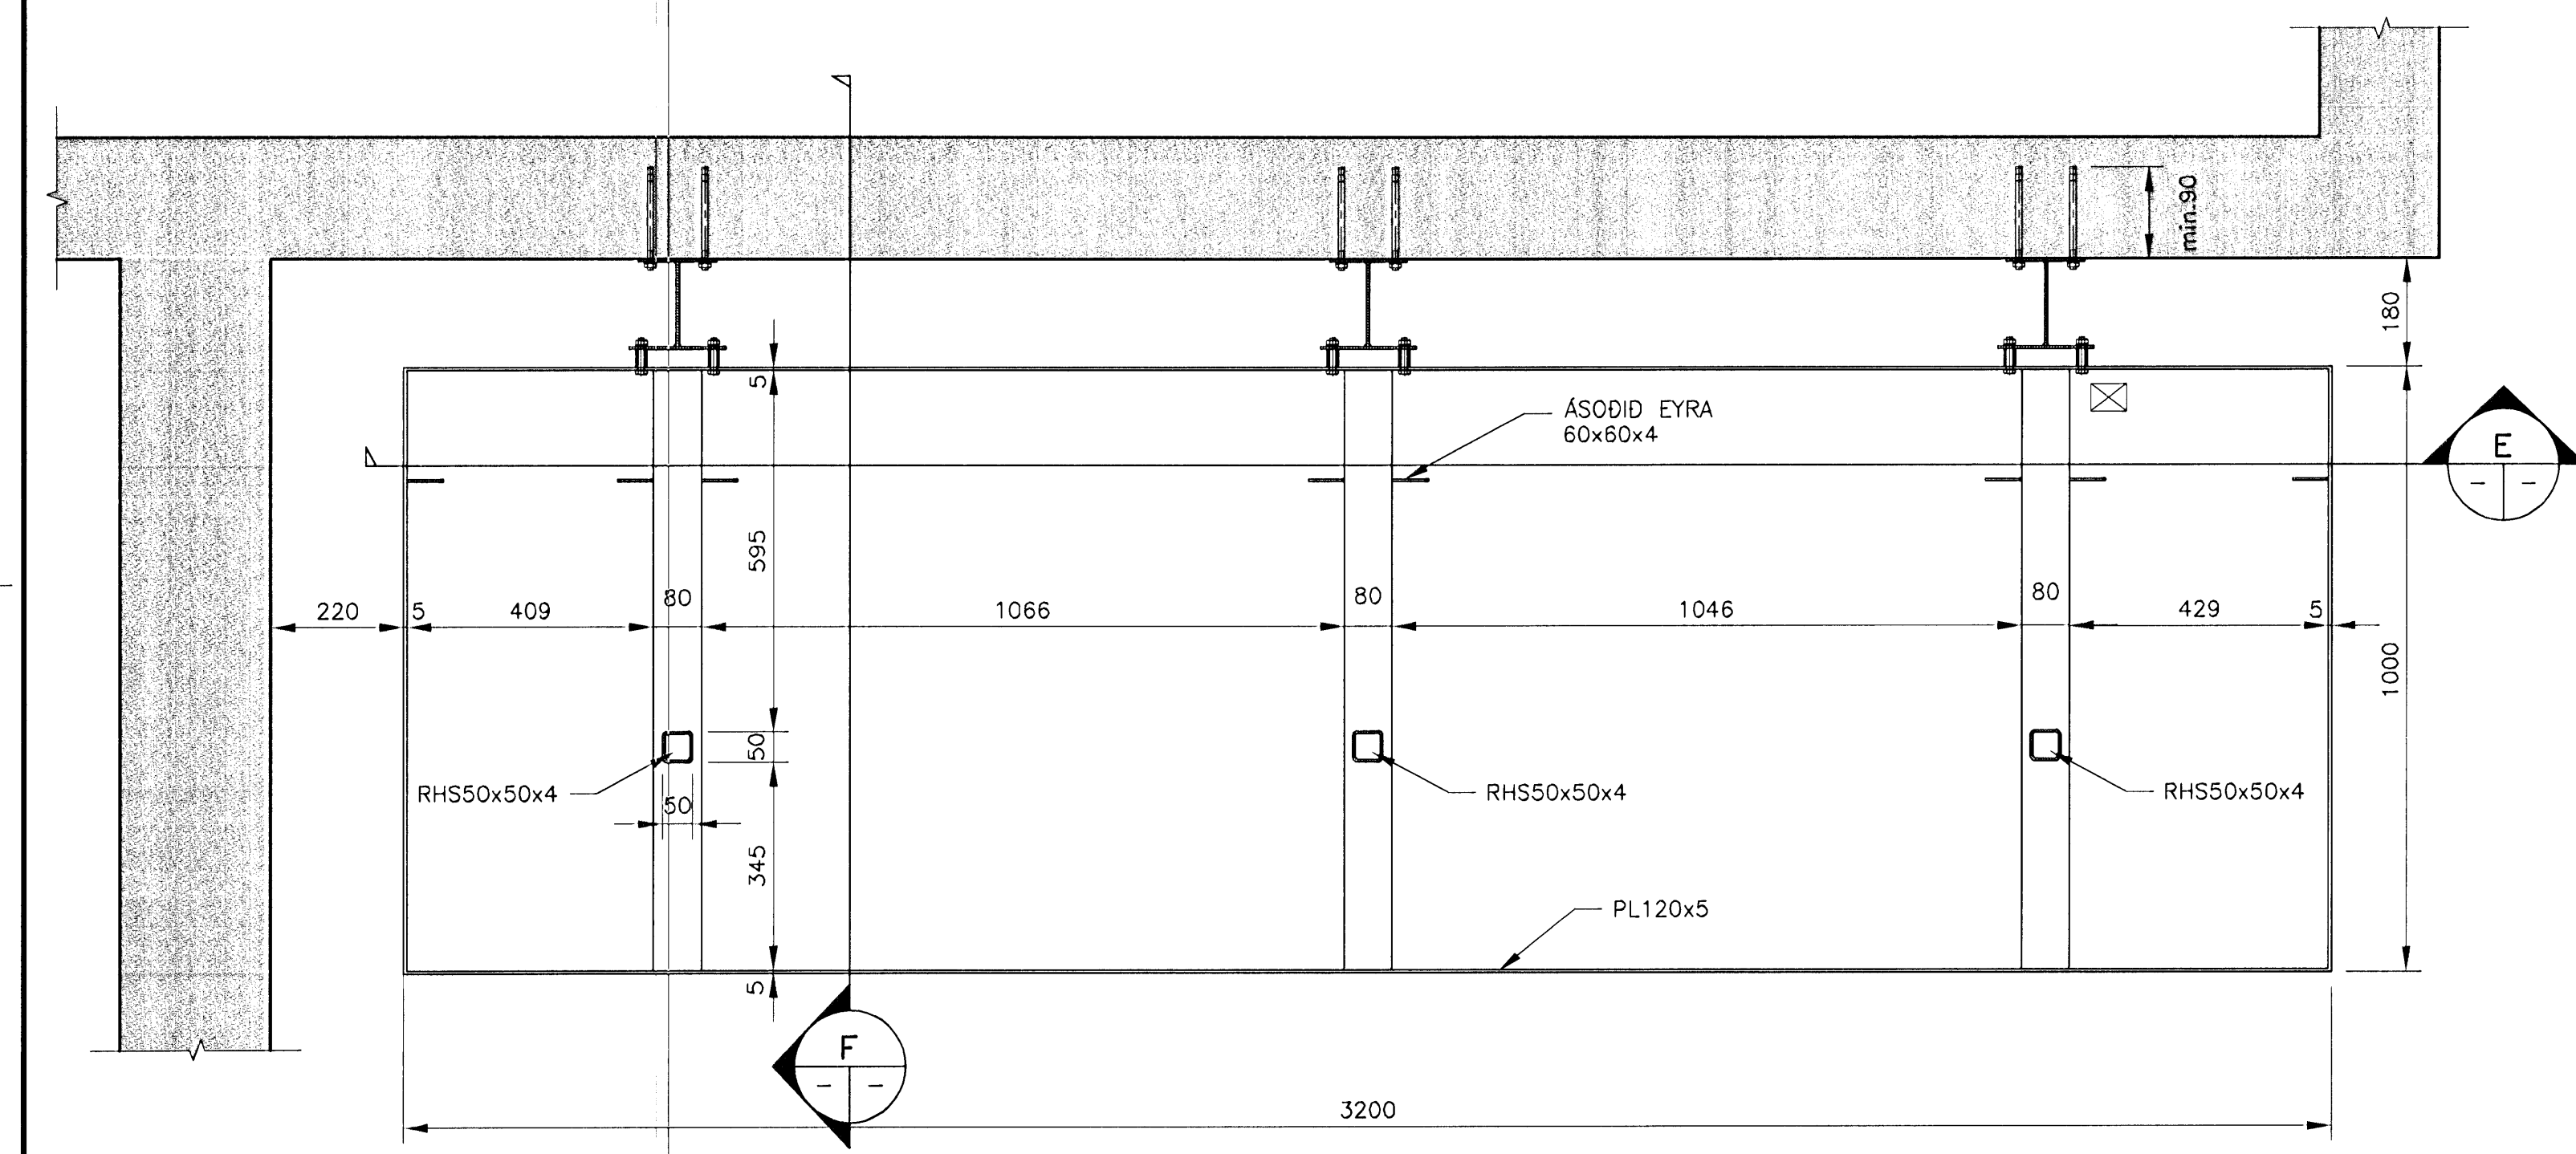


E


GRUNNMYND-SKYGGNI MKV. 3

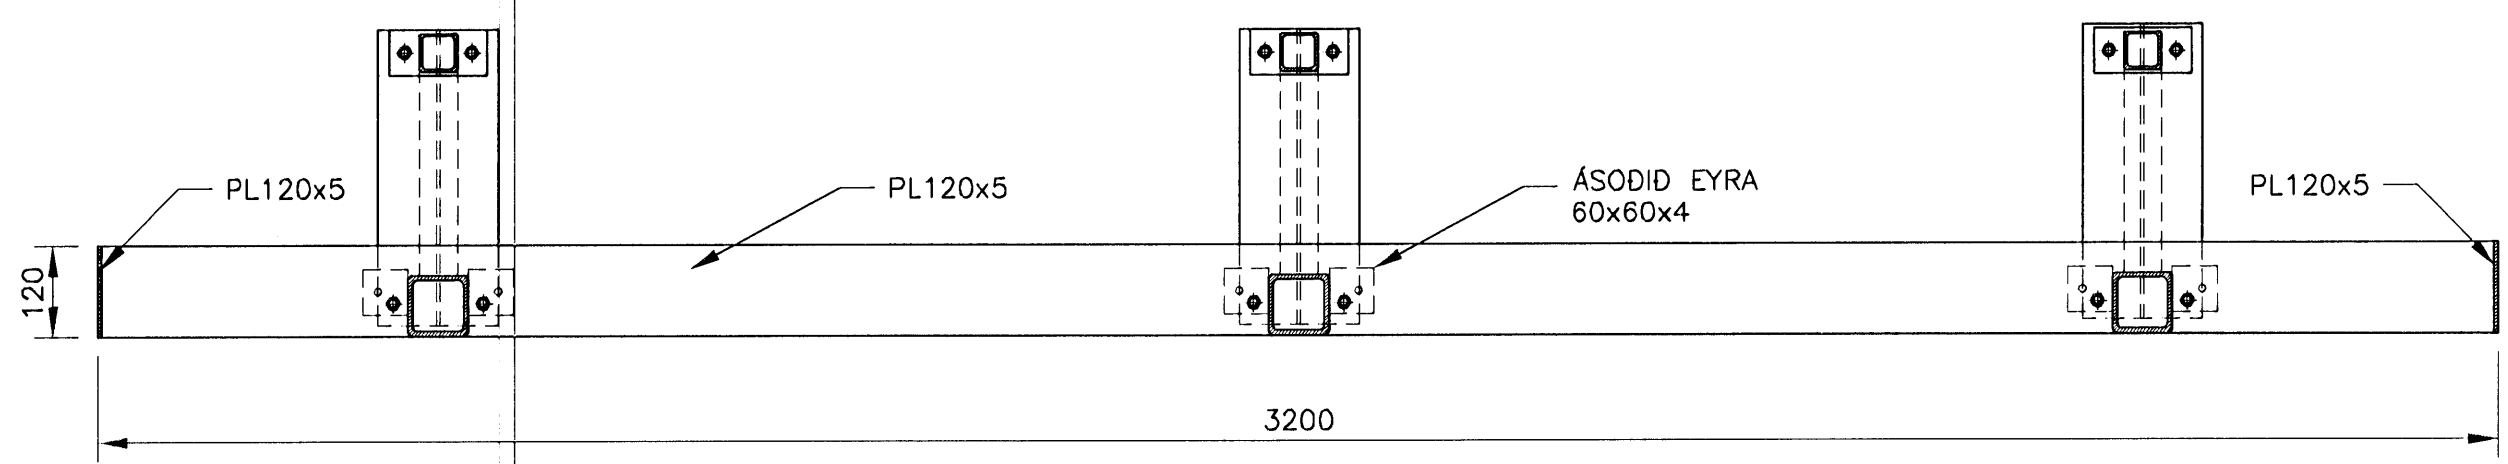


E SNID MKV. 3

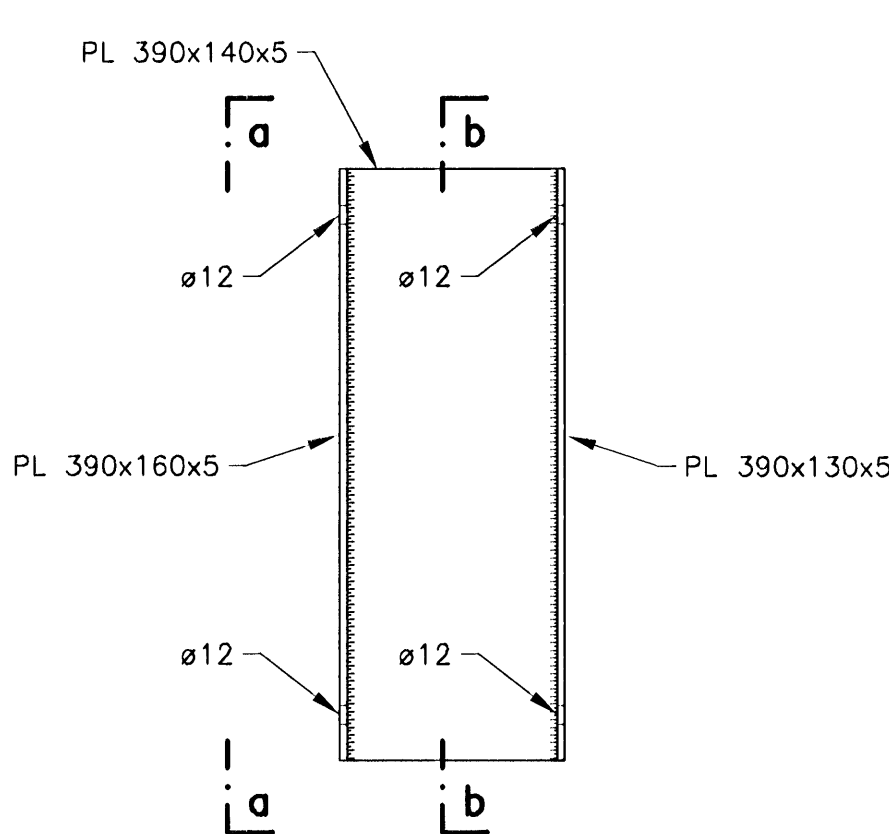

D DEILI MKV. 1

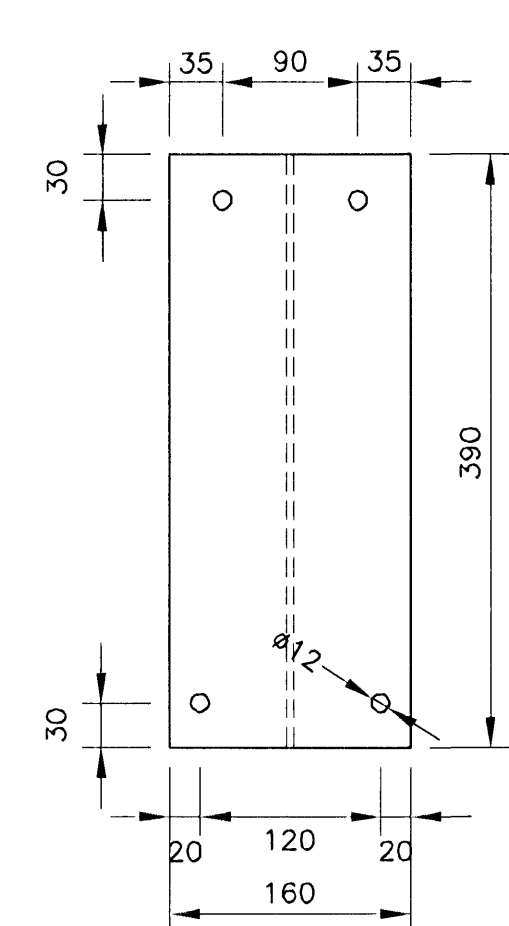

a SNID MKV. 1

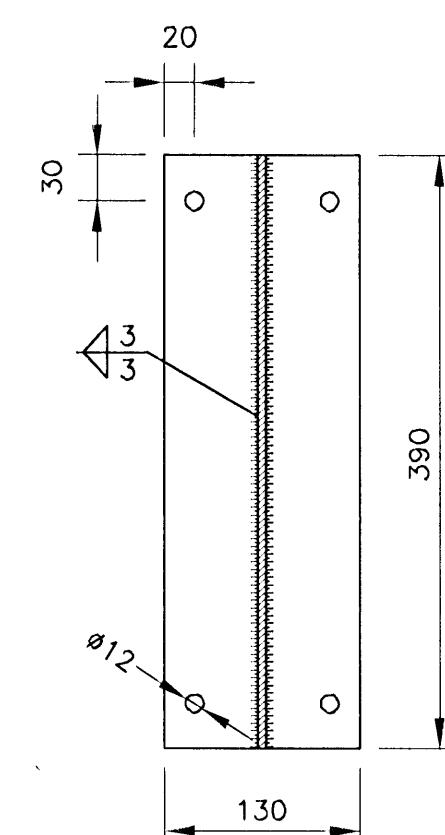

b SNID MKV. 1


Samþykkt þann  
19 AUG 2009  
Byggingafulltrúinn í Hafnarfirði  
Eh. Hrólfur S. Gunnlaugsson

ÚTGÁFUFRILL


NÚMUR	DAGS	SKRIFINGAR	HAUND
B1	10.10.2006	BYGGINGARTEIKNING	HÓÓ
R1	19.08.2008	REYNDARTEIKNING	HÓÓ

DAGS. UNDRISKRIFTAR: NAFN OG KT. SAMRÆMINGARHÖNNUNAR:  
UNDRISKRIFT SAMRÆMINGARHÖNNUNAR:


MKV. 3

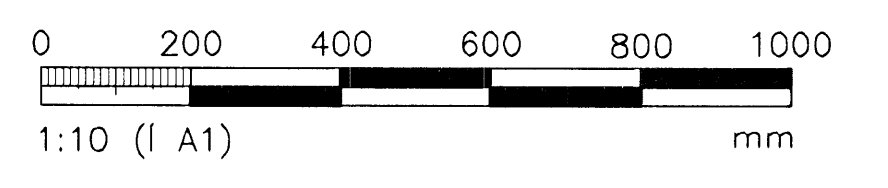

MKV. 2

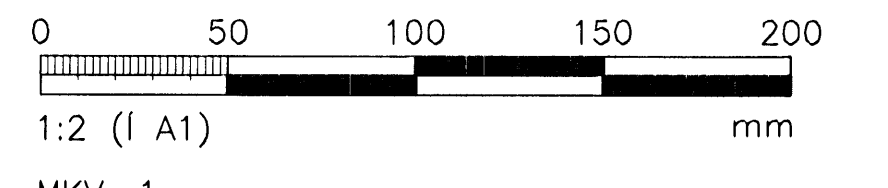

MKV. 1

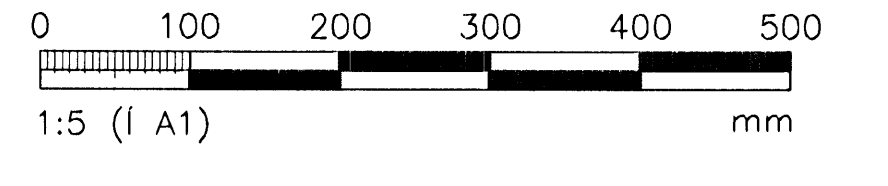

ÖLL ATRÖT OG AFRITUN TEIKNINGAR, AD HILUTA EDA HEILD, ER HÁÐ SKRIFLEGU LEYFI HÖFUNDA.

**VGK HÖNNUN**  
GRENSÁSVEGI 1 · 108 REYKJAVÍK · Sími: 422 3000 · Fax: 422 3001  
VEFFANG: www.vgkhonnun.is · NETFANG: vgkhonnun@vgkhonnun.is

HEITI TEIKNINGAR:  
**HRAUNVALLASKÓLI 2. ÁF.**  
DREKAVELLIR 9, HAFNARFIRÐI

HEITI TEIKNINGAR:  
BURDARVIRKI:  
VINDFANG  
GRUNNMYND, SNID OG DEILI

MÁLT:	TEIKNAD:	GEYMSLUNUMER:	VNR:
HAUND:	BAR:	MKV:	3.151.21B
DAGS. UNDRISKRIFTAR:	YFIRFAR:	MKV:	NR. TEIKNINGAR:
31.12.2008	VGK-HÖNNUN	430572-0169	<b>B2-412</b>
UNDRISKRIFT HÖNNUNAR:	NAFN OG KT. HÖNNUNAR:	200882-5119	ÚTGÁFA:
LÁRUS ÁRSKILSSON	VGK-HÖNNUN		R1