



Með: 19/10 2009  
H. G.

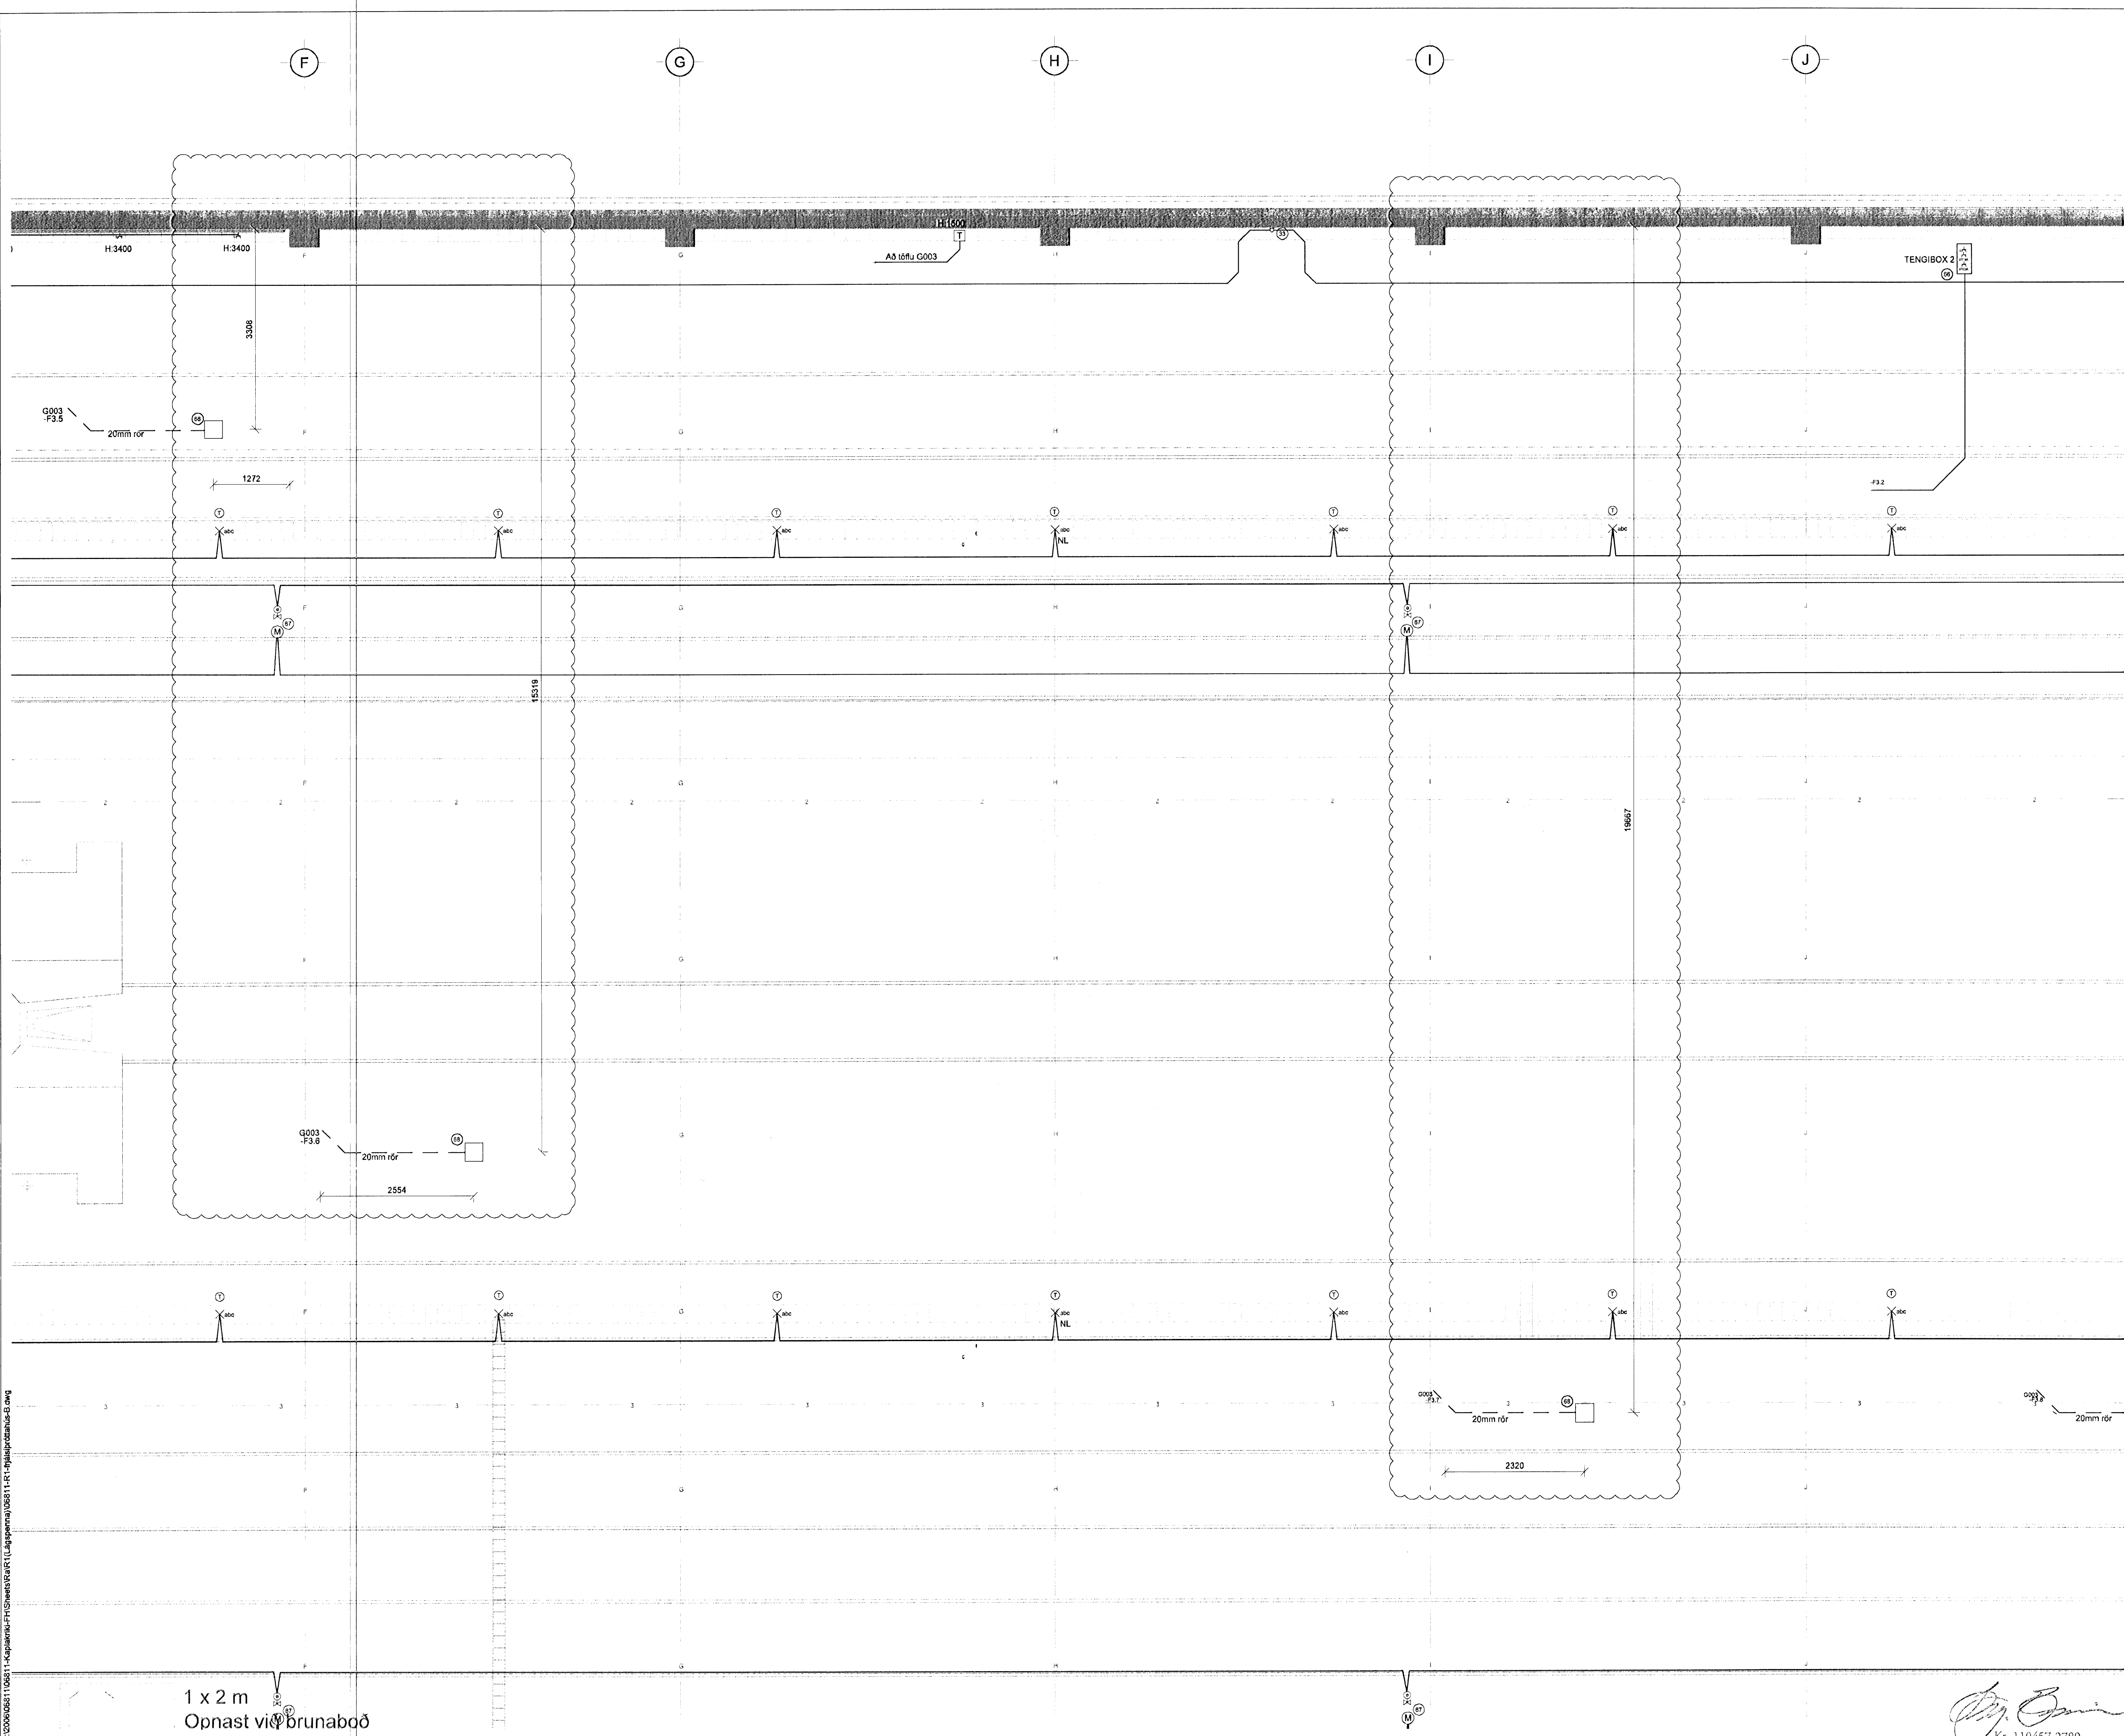

KAPLAKRIKI

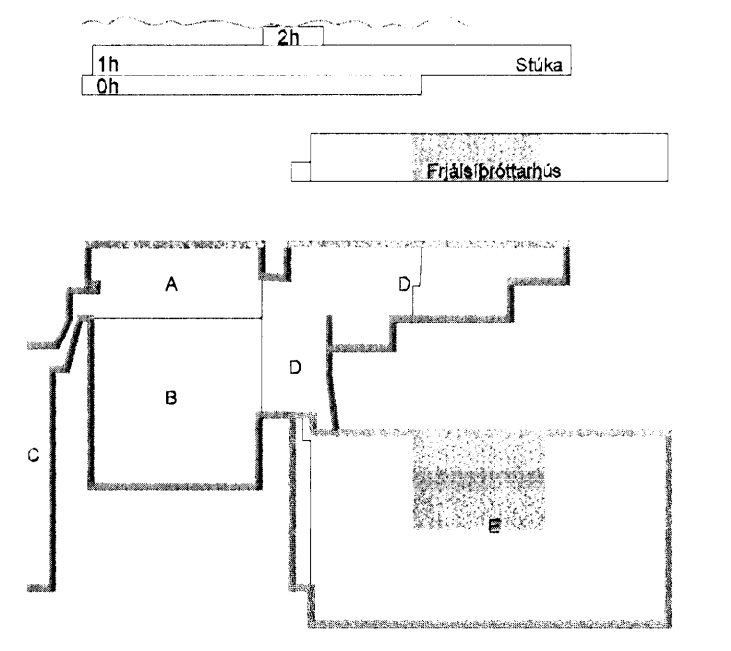

B 13.10.09 Gólfbox másett BSG/ÓG  
 A 17.09.08 Gólfíðis færð til SF/ÓG  
 Útg. Dags. Skýring Hannas/Yfirfarð



VERKFRÆÐISTOFA

BÆJARHRAUN 20 · 220 HAFNARFJÖRDUR · KENNIT. 710708-2899  
 vsb@vsb.is · Sími 585 8600 · Fax 585 8610 · www.vsb.is

Árnum sérhönnuðar  
 Örn Guðmundsson Kt: 220961 2739 *Örn*

Verkhúsi		KAPLAKRIKI		HAFNARFIRÐI	
Verkhúsi		Rafkerfi		Lágsþenna frjálspíróttahús	
Hannas		Teiknað		Yfirfarð	
RVK/HJ		RVK/HJ		ÖG	
Dags.		Verkefni		Kvarði	
18.03.2008		06811		1:50	
		Teikning		/ A1	
		B R102		Stöa	
				Útgáfa	
				A	

*Hannas*  
 Kt. 110457-2789

V:\2008\0611\0611-Kaplaeri-F3\Sheet\F3\F3.dwg