



VERKTEIKNING

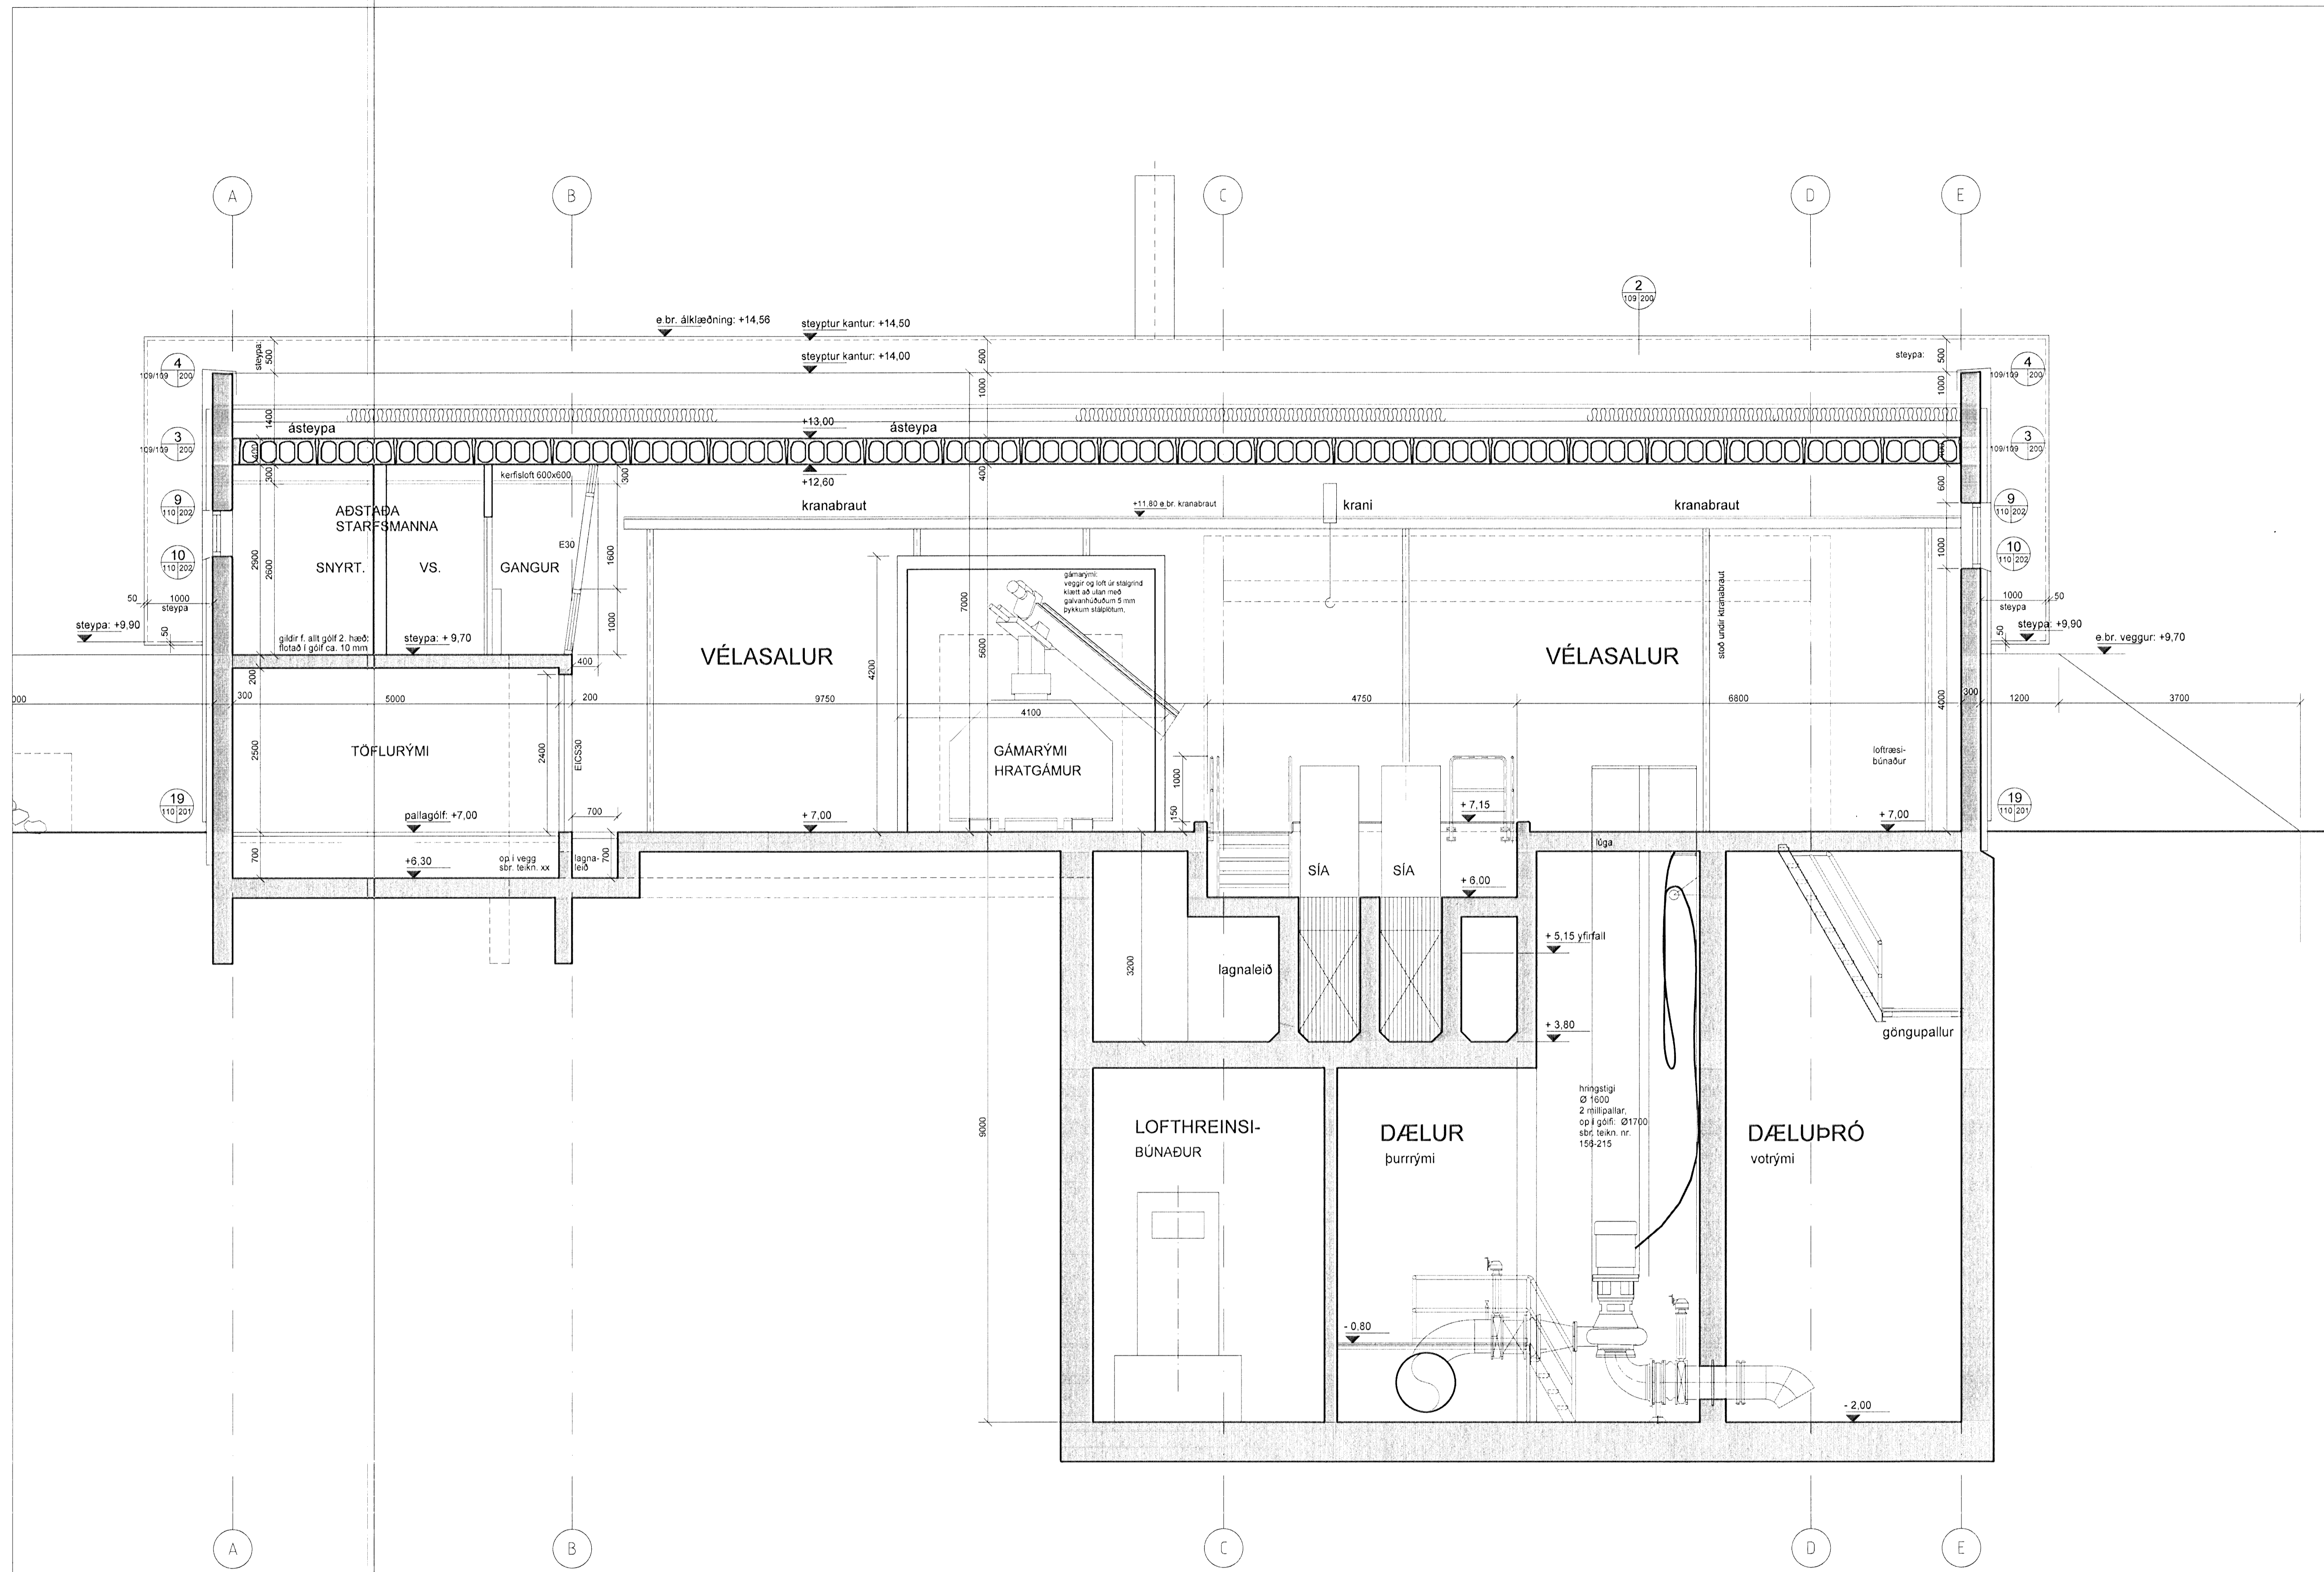

SNID B-B

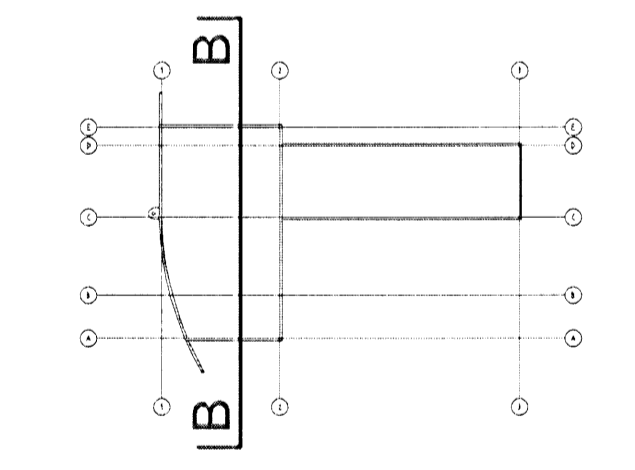

STEINSTEYPA  
GIPSKLÆDDIR MILLVEGGIR

Á: Lokad rými fyrir gám í vélasal. 06.08.2009  
BREYTING: DAGS:

**HRAUNSVÍK, HAFNARFIRÐI**  
**DÆLU- OG HREINSISTÖÐ**

verk: **snid B-B**  
teikning: **verkteikning**  
efni: **1:50**  
mkv: **28.04.06** nr. **156-110A**  
dags: *Ragnvaldur Adamsson* 240448-2469  
**ADAMSSON ehf - arkitektastofa**

LAUGAVEGI 32b sími: 551 1300  
101 REYKJAVÍK netfang: adamsson@sumnet.is  
REYNR ADAMSSON arkitekt feli teiknað.