
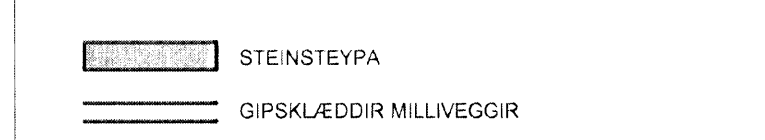
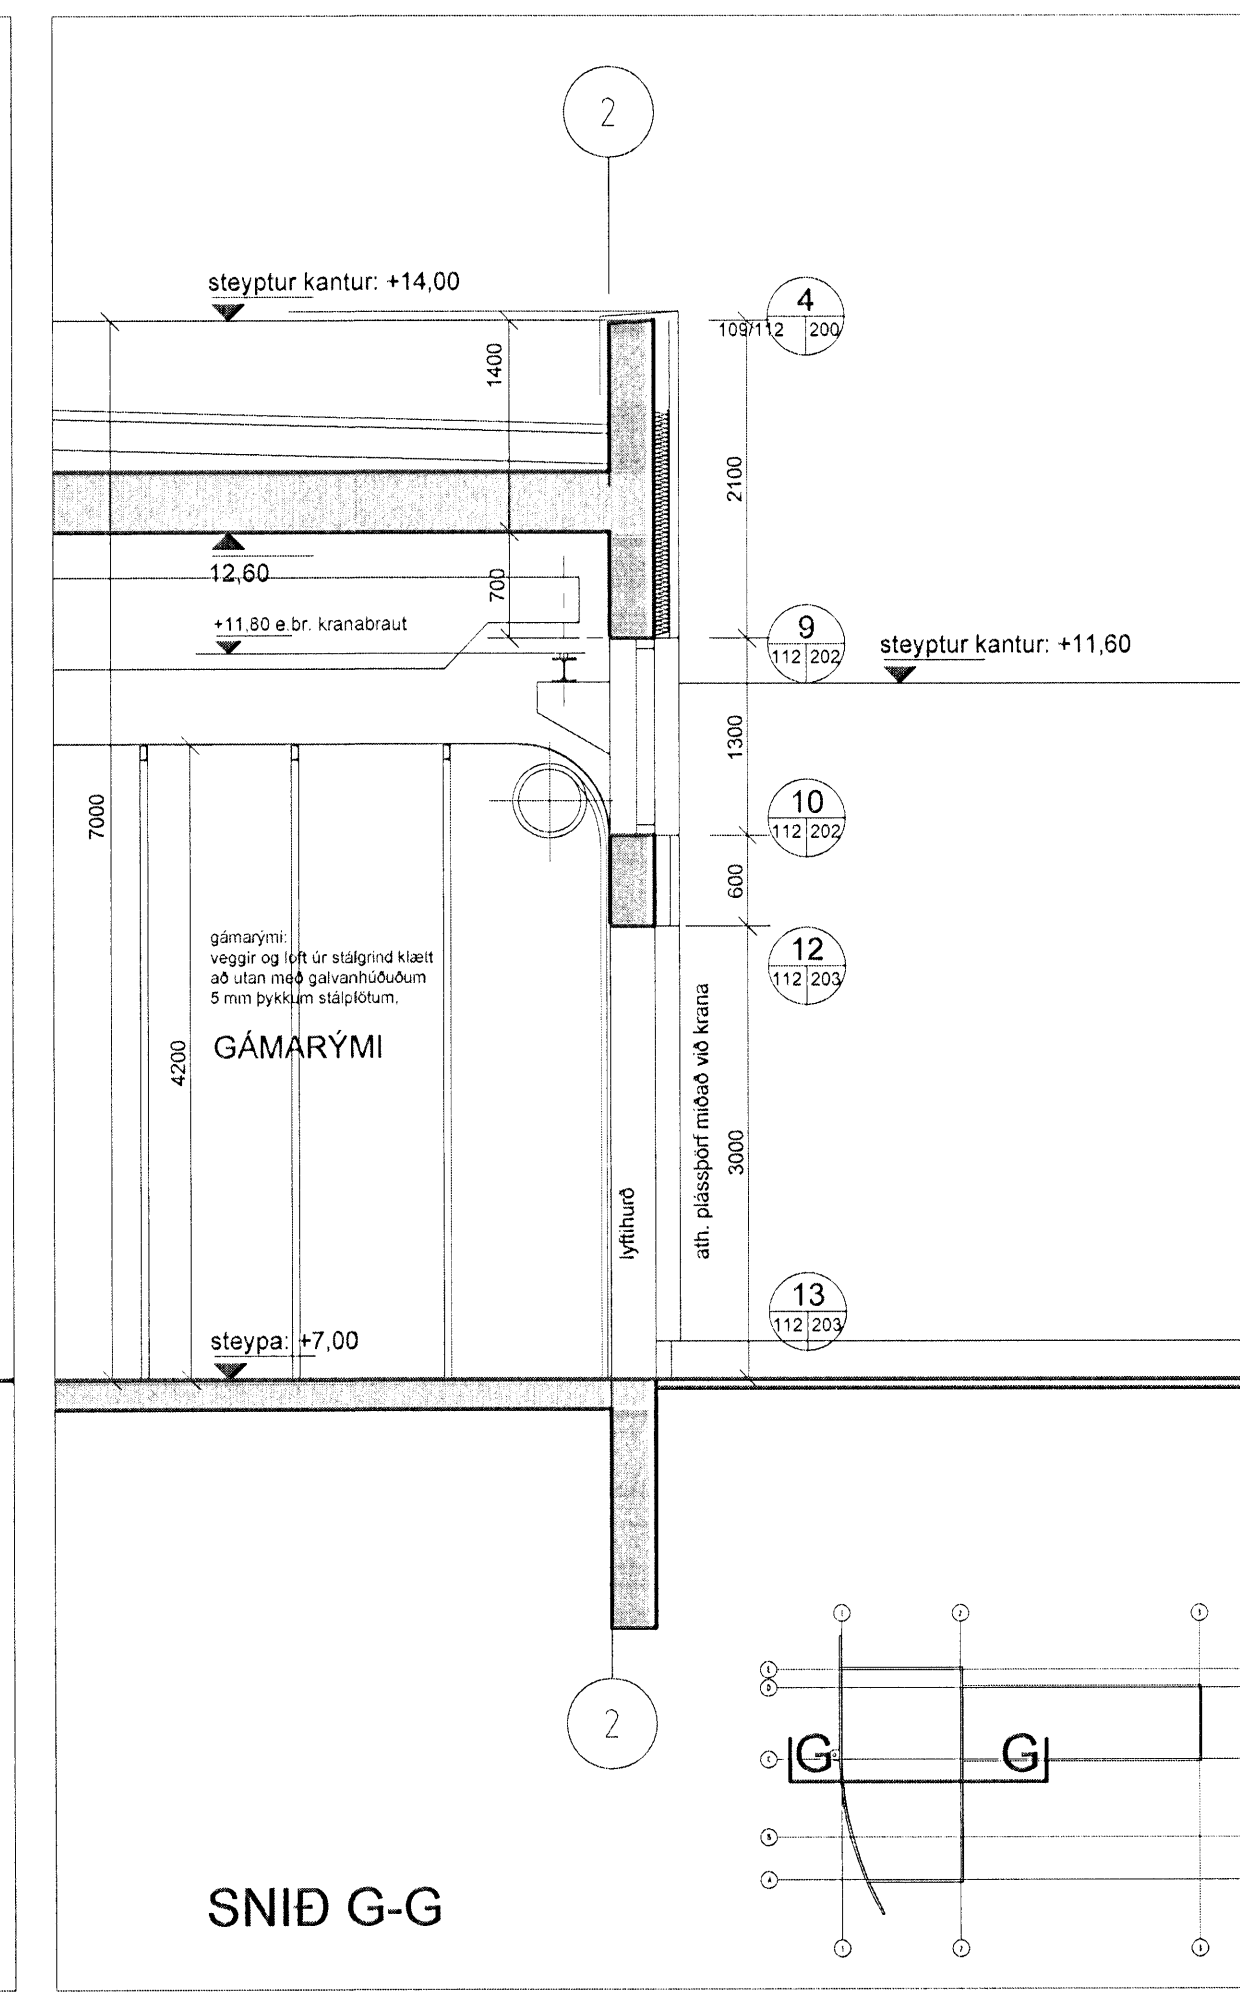
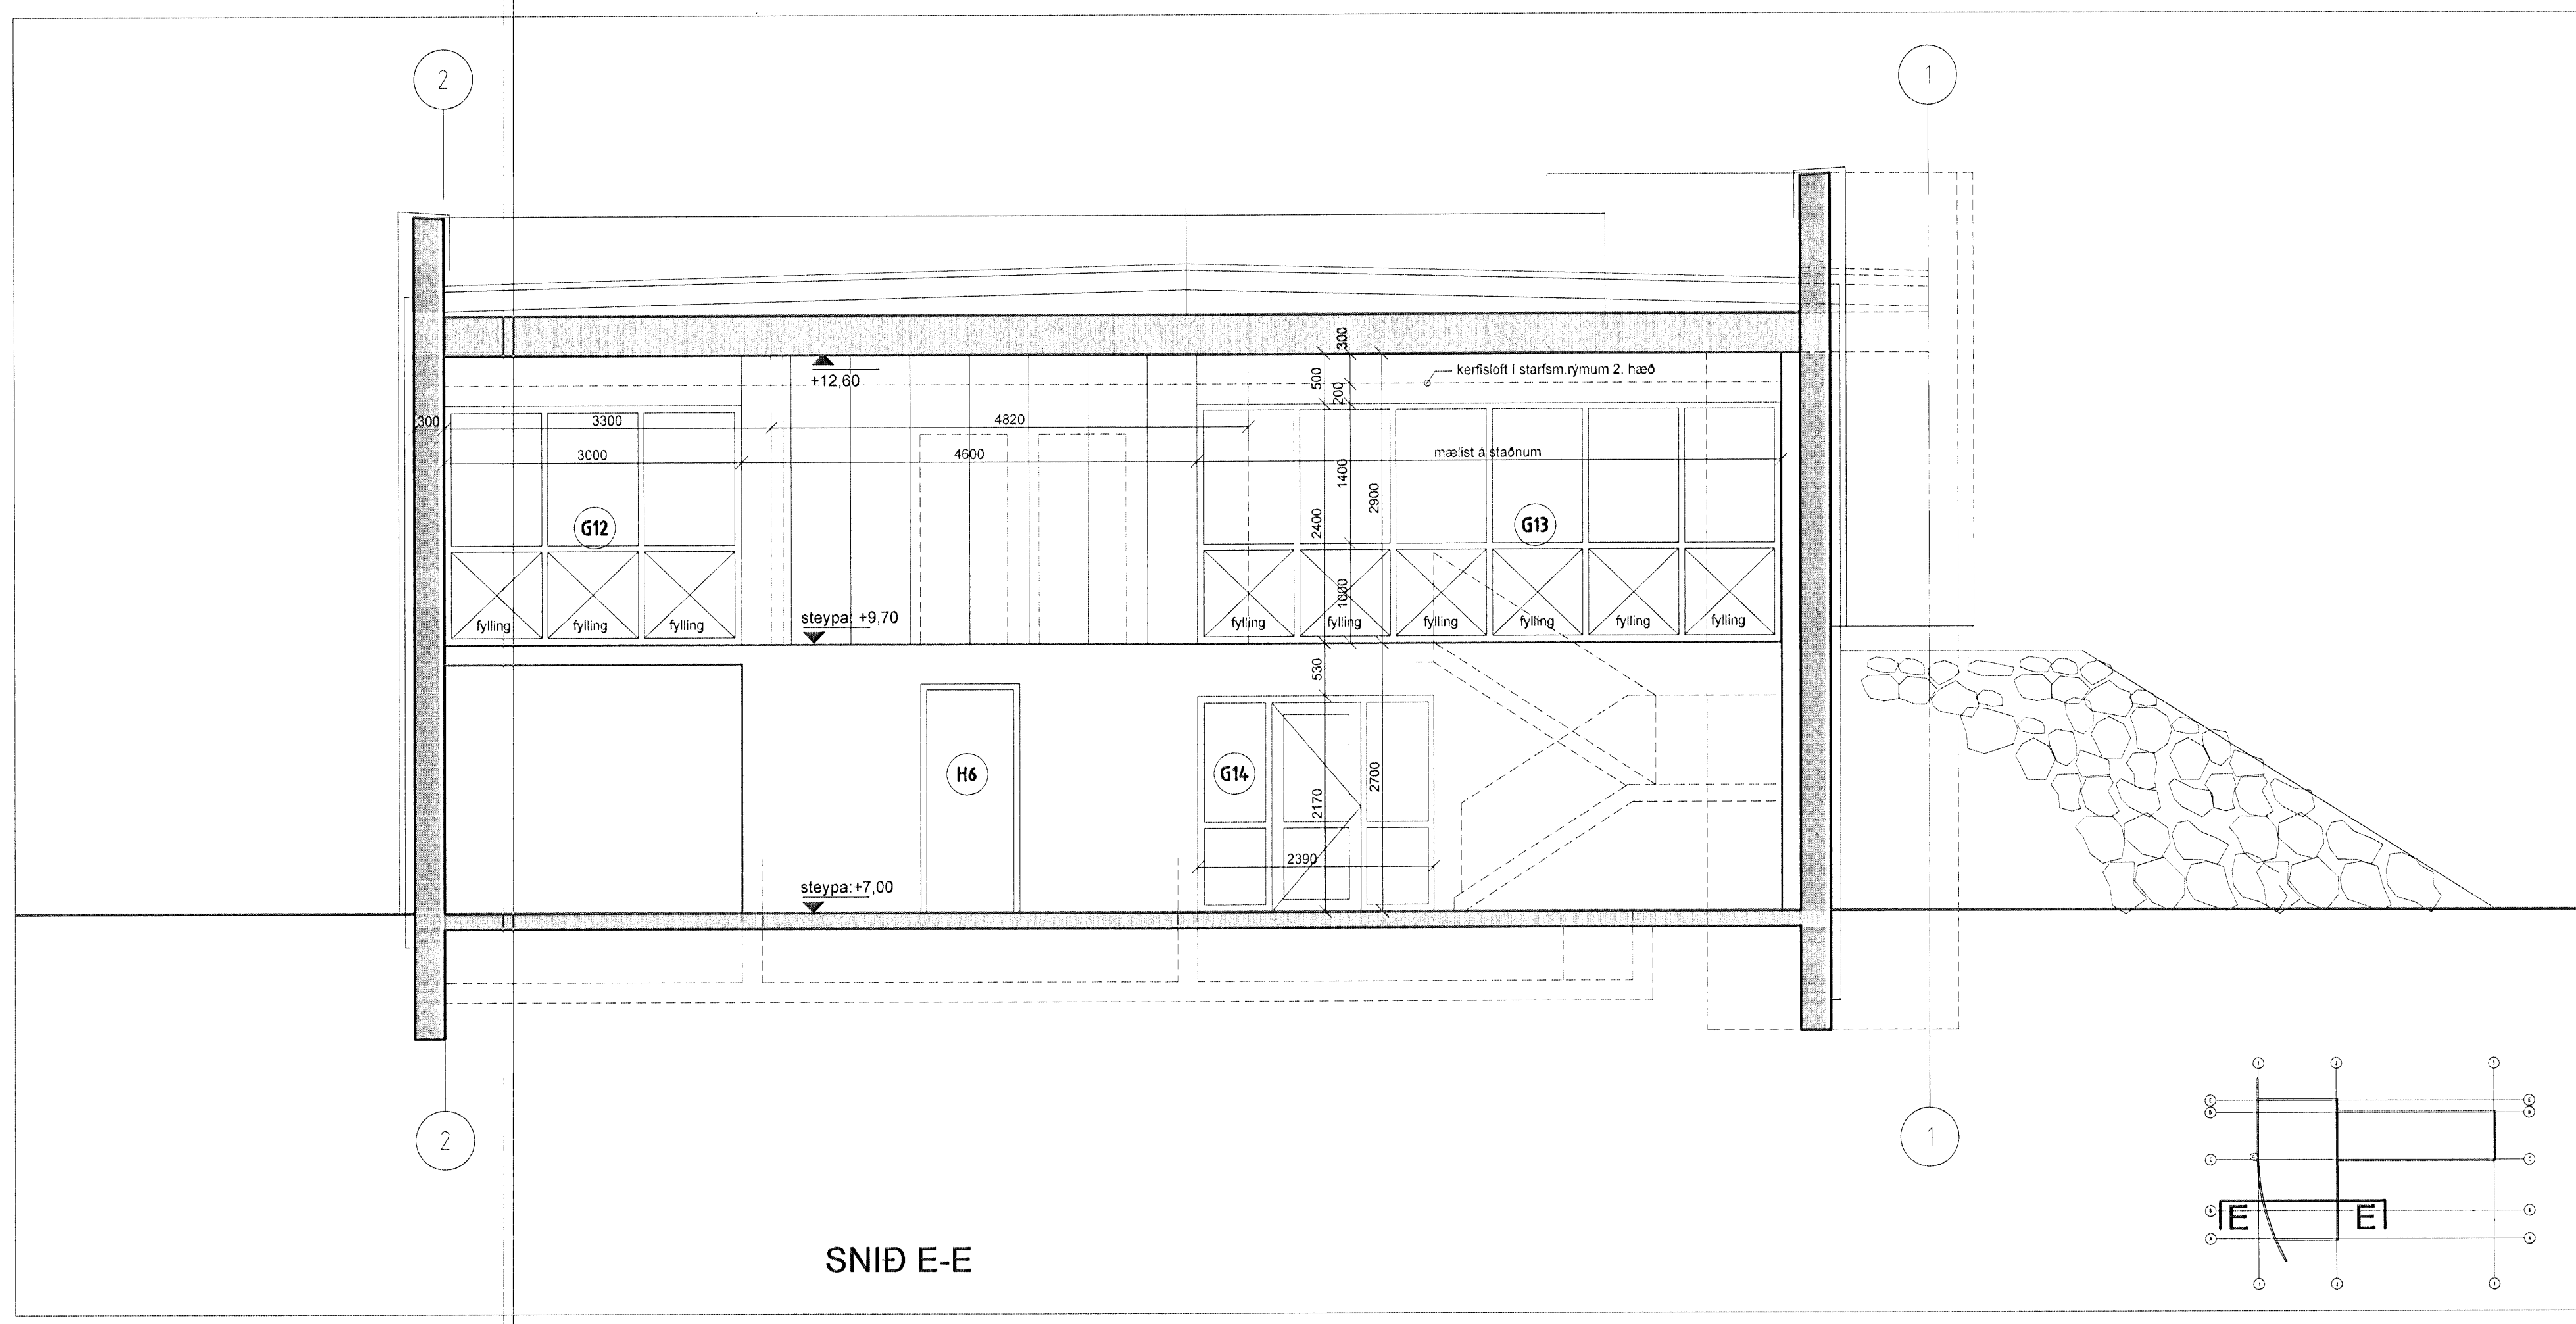
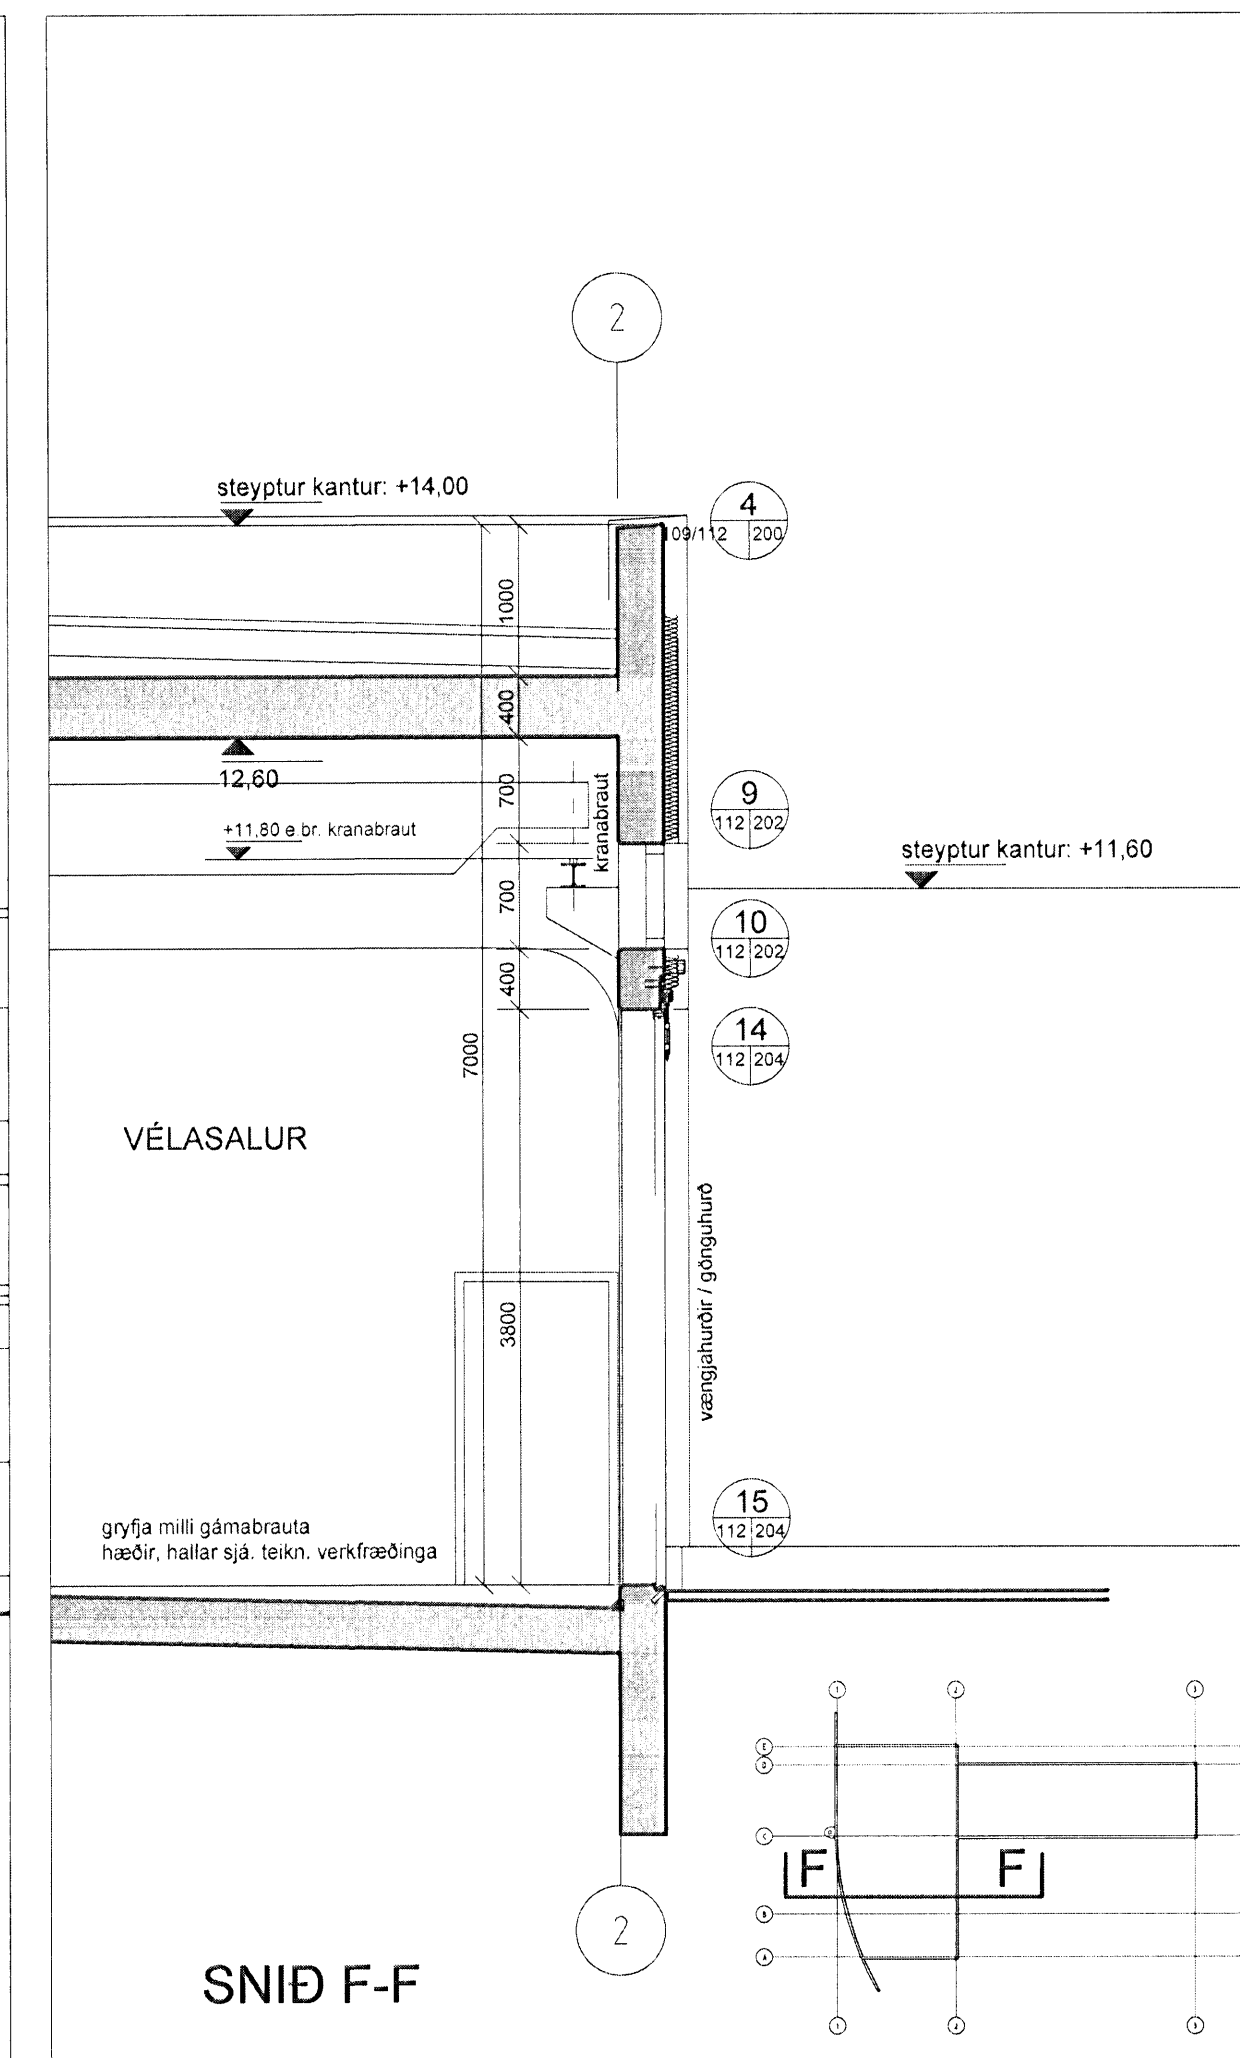


VERKTEIKNING

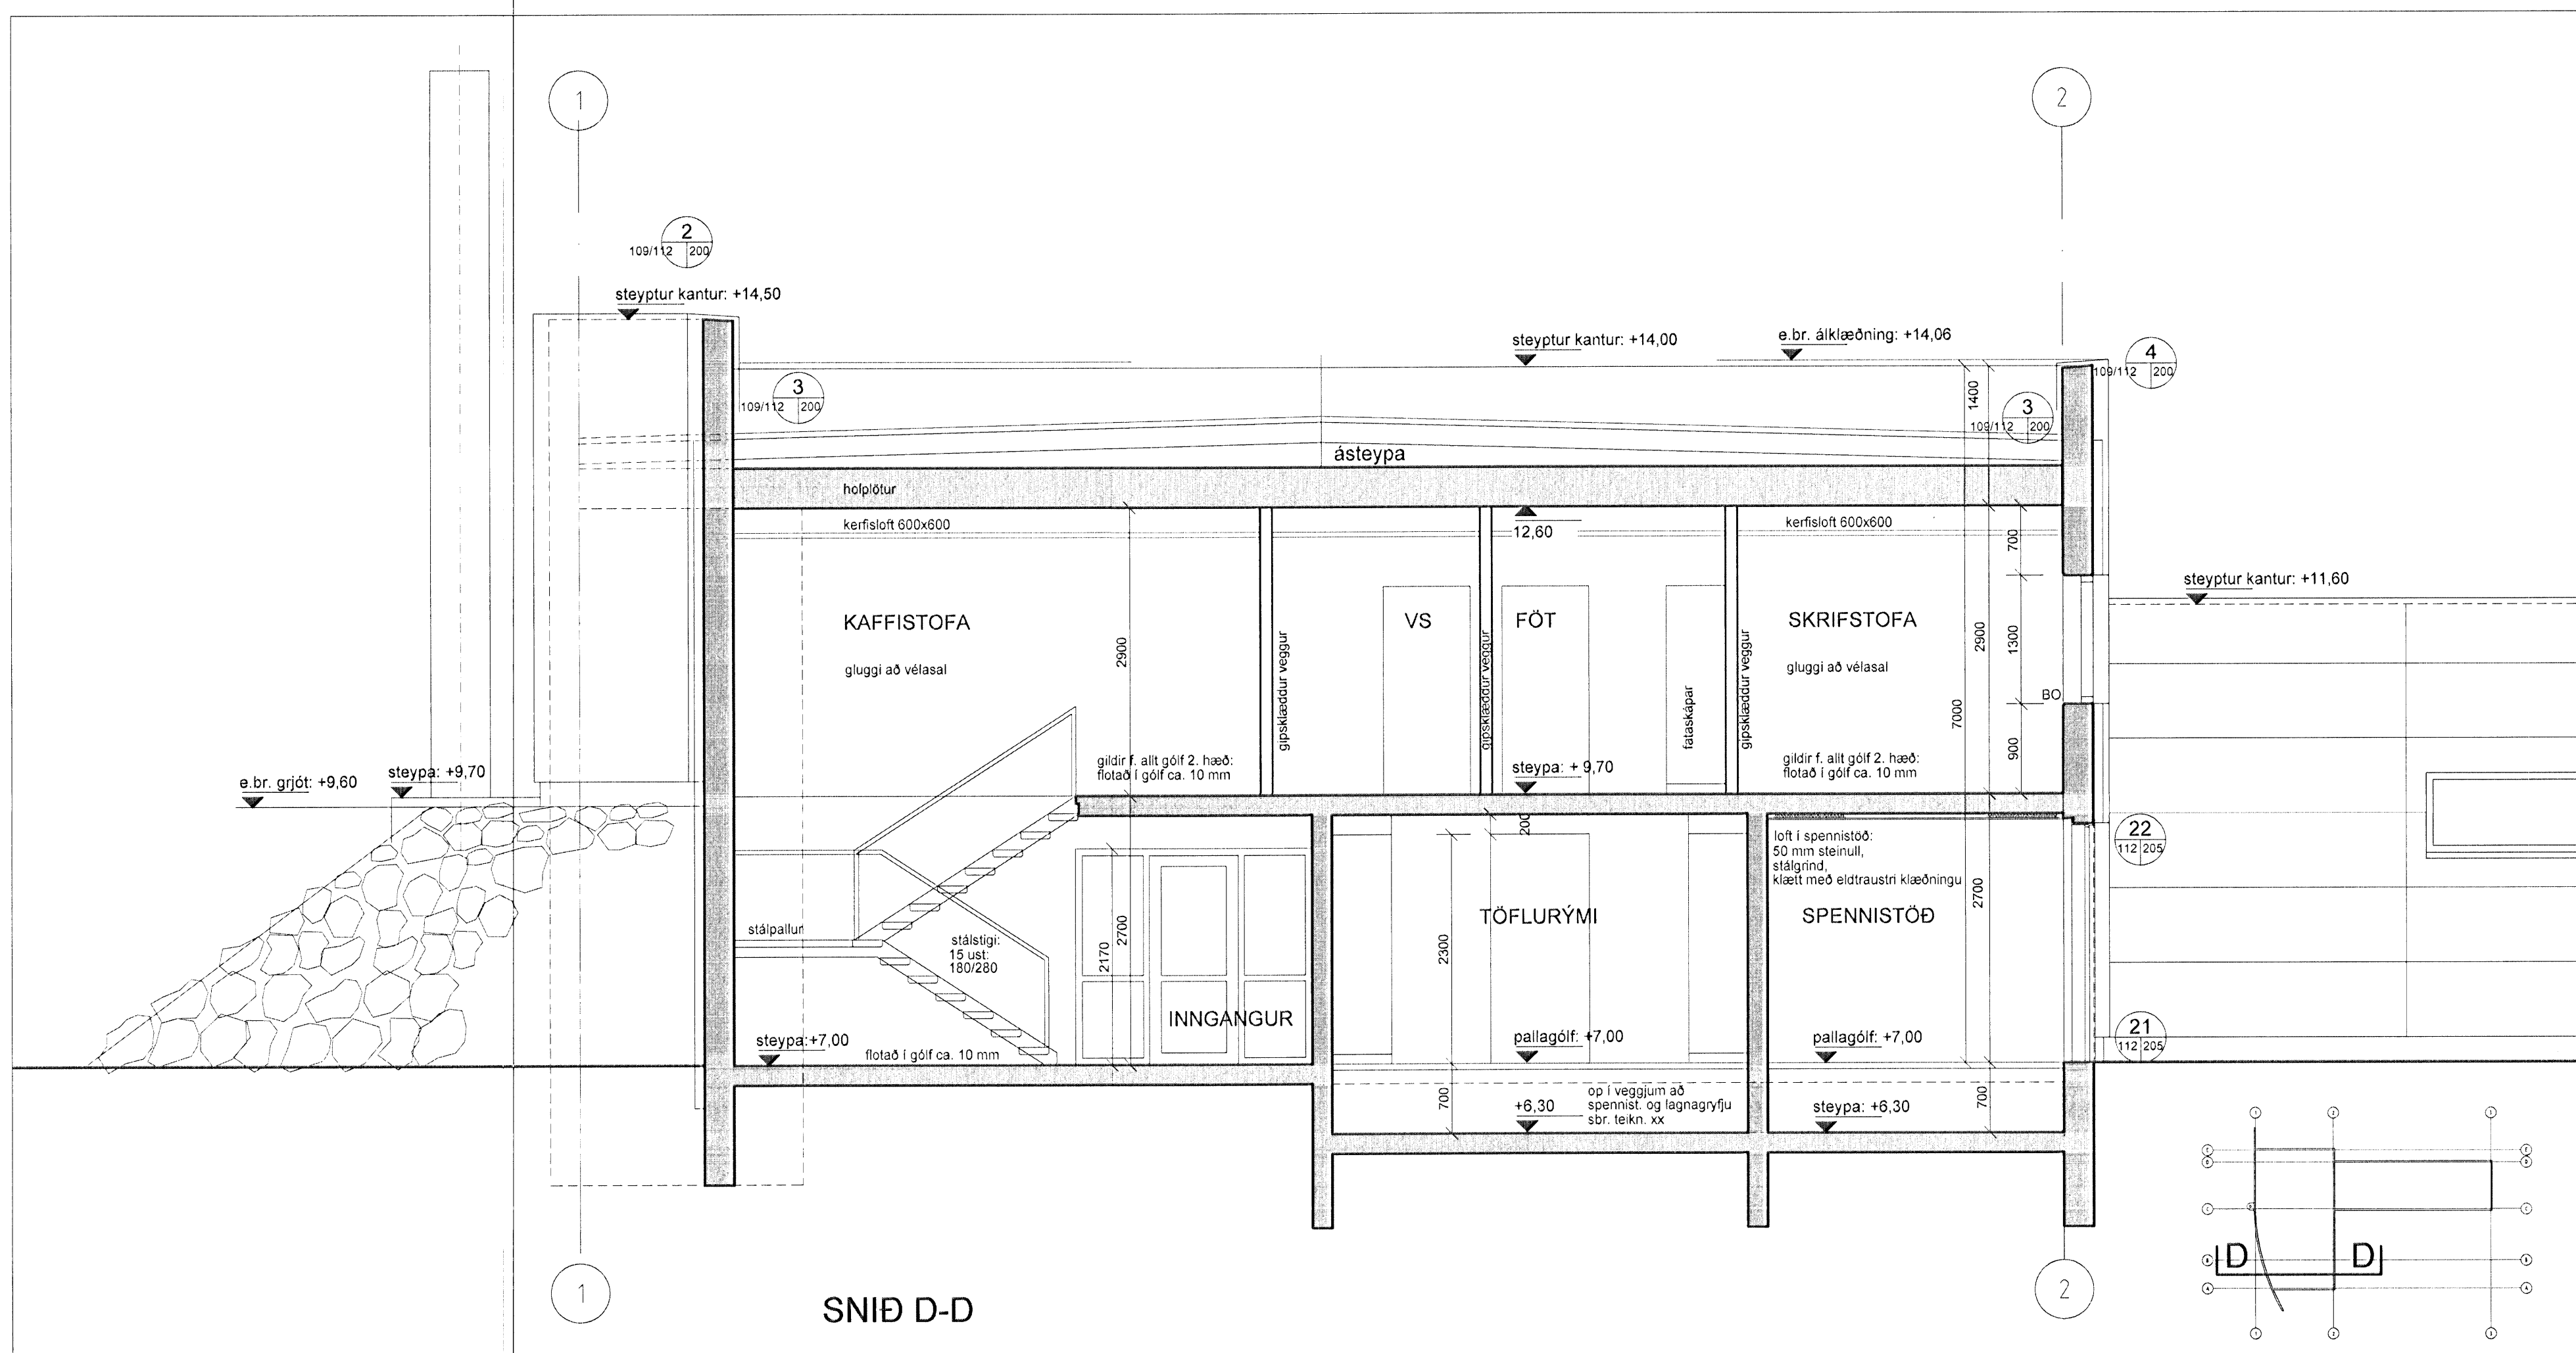

A: Lokad rými fyrir gáma í vélasal, breytt snið F-F og G-G. 06.08.2009
 BREYTING: DAGS:

HRAUNSVÍK, HAFNARFIRÐI
 DÆLU- OG HREINSISTÖÐ

verk: snið D-D, E-E, F-F, G-G
 verkeikning

efni: 1:50

mkv: 28.04.06 nr. 156-112A

dags: 101 REYKJAVÍK

undirskrift: *Reynir Adamsson* kt. 240448-2469
ADAMSSON ehf - arkitektastofa

LAUGAVEGI 32b sími: 551 1300
 101 REYKJAVÍK netfang: adamsson@simnet.is

REYNIR ADAMSSON arkitekti fól teiknað.