


BR1, BR2 og BR3 eru Ø600 PL

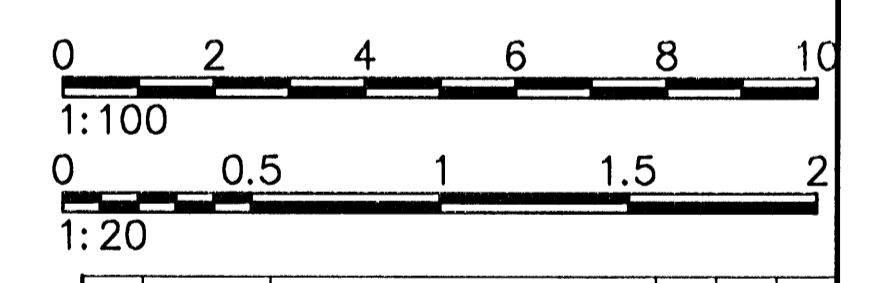

R	2009-08-18	REYNDARTEIKNING	ÓE	ÓE	ÓE
A	2009.05.07	VERKTEIKNING	GuJ	ÓE	GuJ
Ótg.	Daga	Breyting	Ha.	Yf.	Sp.
HAFNARFJARDARBÆR			Sími: 585 5655		
FRÁVEITA HAFNARFJARDAR			FAX: 585 5839		
STRANDGÖTU 11			www.verkis.is		
220 HAFNARFJORDUR			Arndís 4		
			108 Reykjavík		
			Sími: 422 8000		
			Hú: 81278-0289		
			www.verkis.is		
Höfundur:		Guj	Yfirgripur:	ÓE	Mkv. 1:100/1:20
Samþykkt:		Guj	VERKIS Ólafur Erlingsson 20090427		
Töluskrá:		K:\2003.02\07\08-Oseyri-B\tekn\0727.02-03.dwg		Bláskrá:	
Dagur:		APRIL 2009	Útgáfa:	2003.0207	27.02 R

Grjótbeð þjappað hraun 50-250mm

Grjótbeð þjappað hraun 50-250mm

Grjótbeð þjappað hraun 50-250mm með stærri steinum í bland

HNITASKRÁ:

Nr.	X-hnit	Y-hnit	Nr.	X-hnit	Y-hnit
BR1	354.813.938	399.069.687	K01	354.779.178	399.094.044
BR2	354.819.808	399.099.717	K02	354.784.922	399.098.014
BR3	354.783.654	399.068.705	K03	354.786.365	399.105.398
NF01	354.804.751	399.062.298	K04	354.798.097	399.113.294
NF02	354.814.924	399.070.350	K05	354.812.732	399.110.433
NF03	354.817.687	399.084.485	K06	354.820.628	399.098.700
NF04	354.820.448	399.098.614	K07	354.815.059	399.070.207
NF05	354.812.702	399.110.276	K08	354.803.326	399.062.311
NF06	354.798.067	399.113.137	K09	354.788.691	399.065.172
NF07	354.786.522	399.105.367	K10	354.780.795	399.076.905
NF08	354.780.770	399.074.966	K11	354.781.659	399.081.325
NF09	354.788.722	399.065.329	K12	354.777.589	399.087.213
NF10	354.792.044	399.083.742			