



Úr Gildi

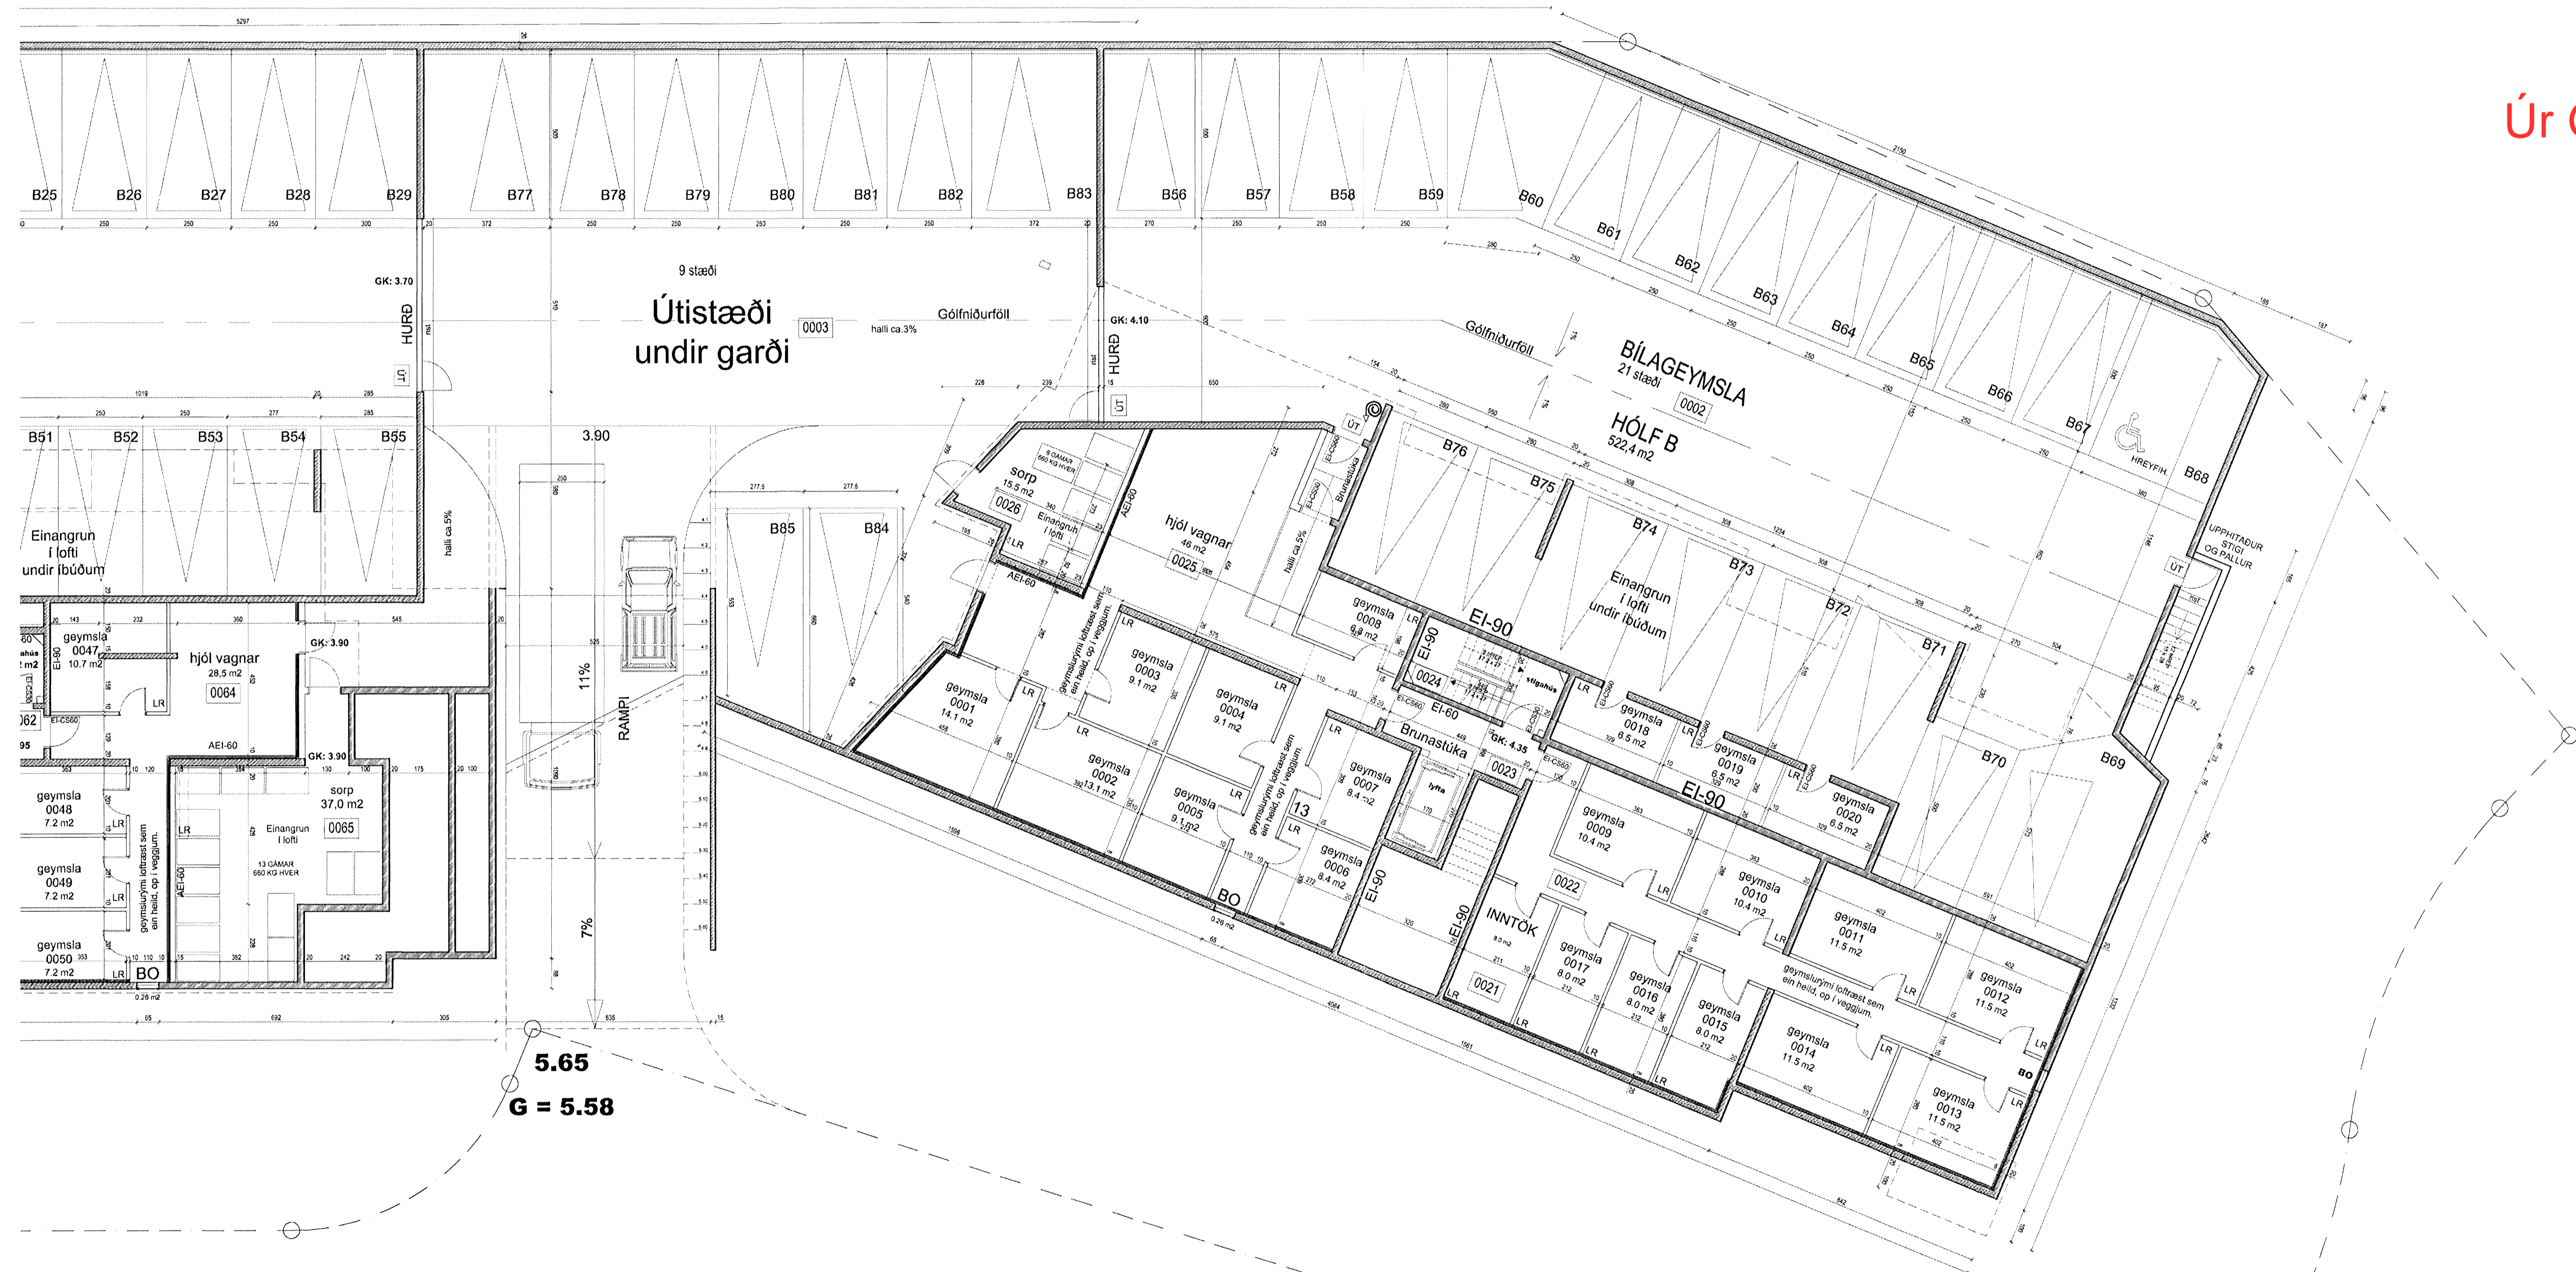

5.65  
G = 5.58

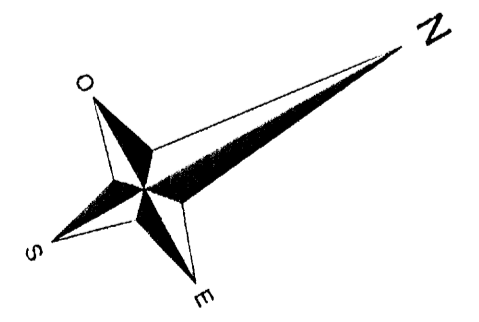

DAGS	Breytingar
18.01.2006	Gólfniðurföll