



AP

= 6.00

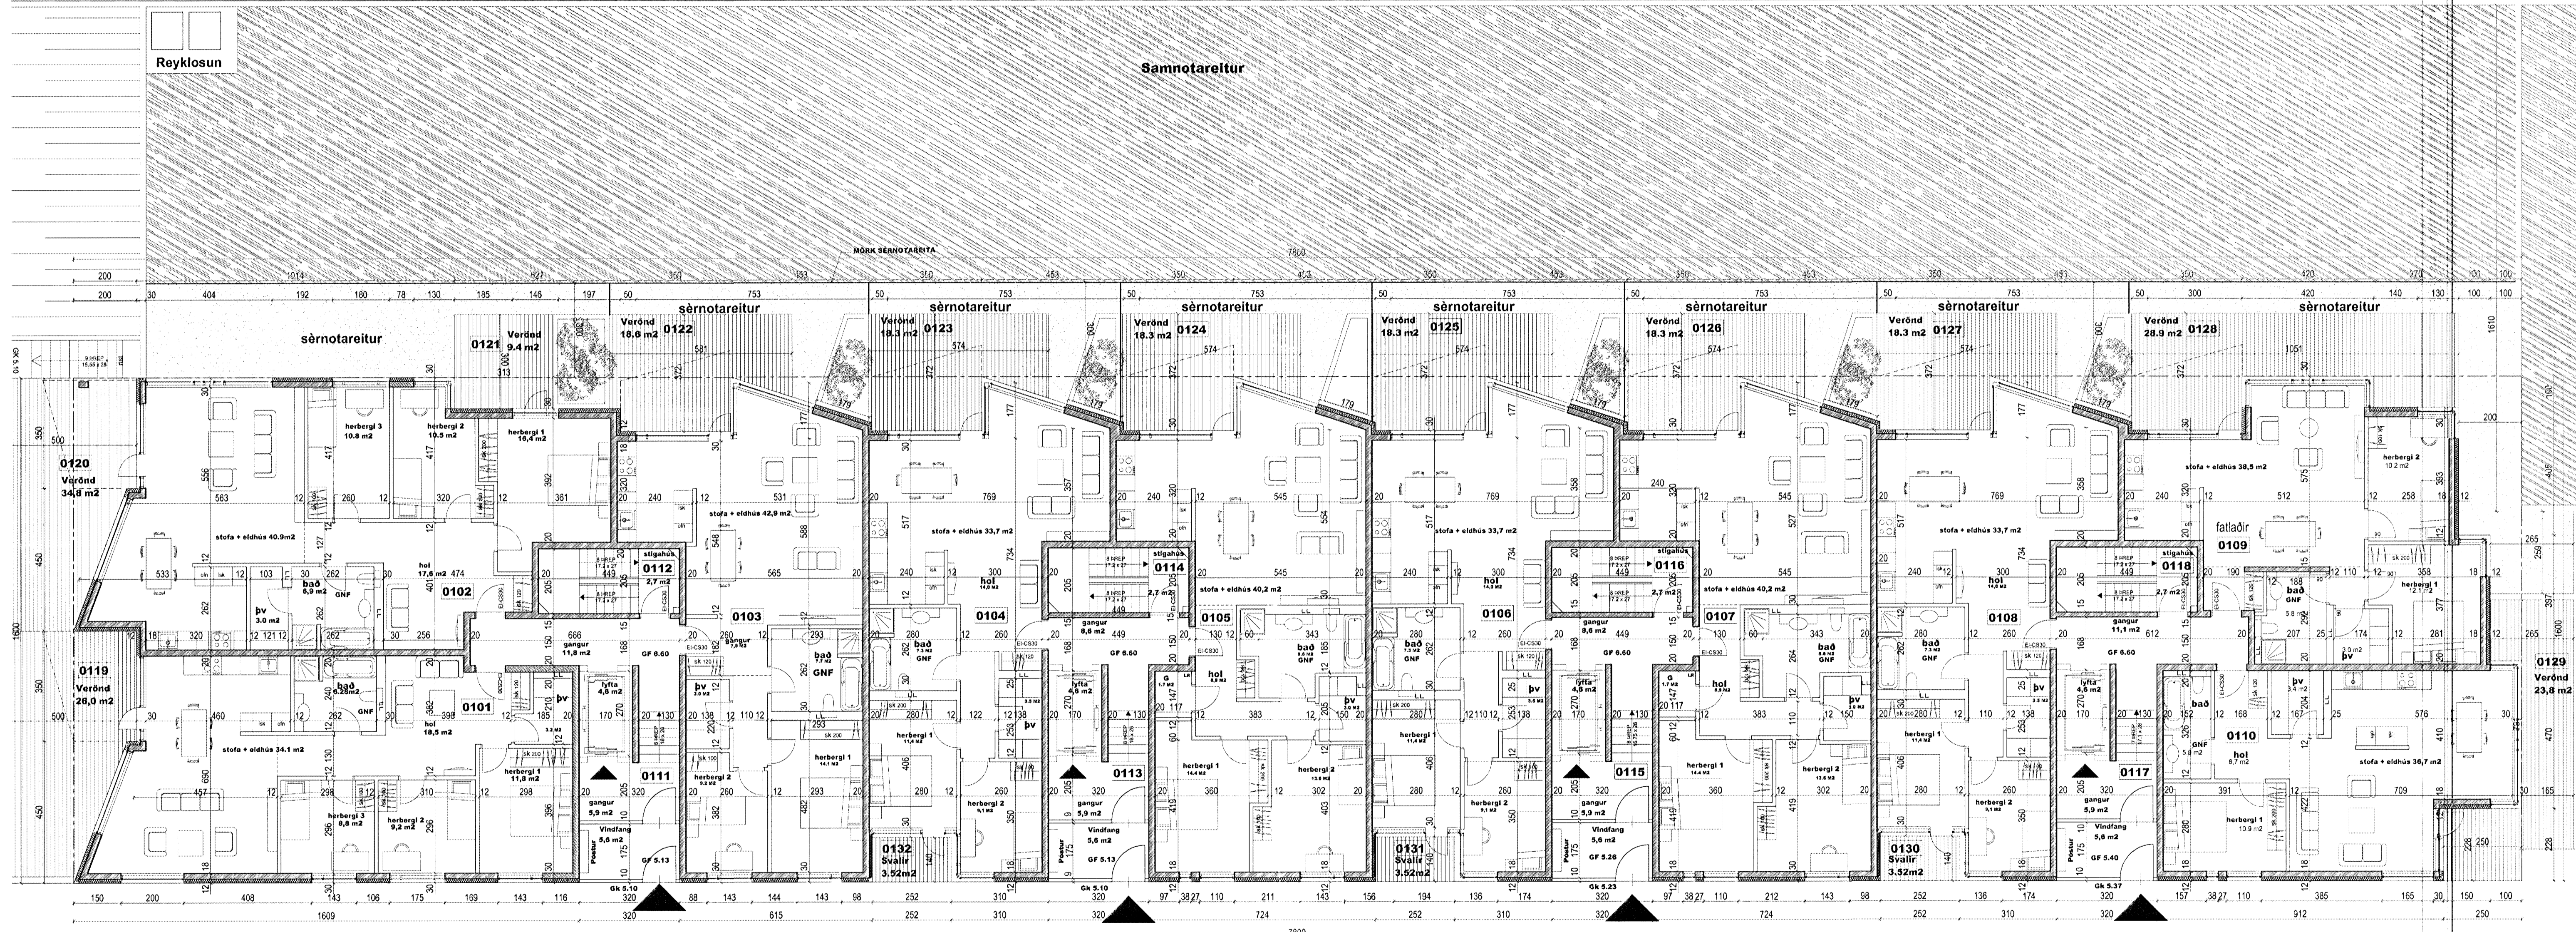

= 4.80

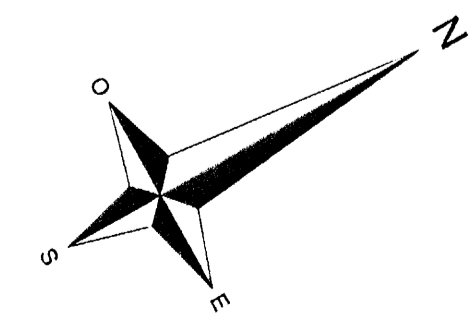

DAGS	Breytingar
18.01.2006	Sérnotareitur, teikir, flái, Tiltal íbúða

Matshluti 2
LL : lagnaleiðir

L = 5.18

L = 5.27