

L = 6.00


Úr Gildi



L = 4.80

L = 5.18

L = 5.27

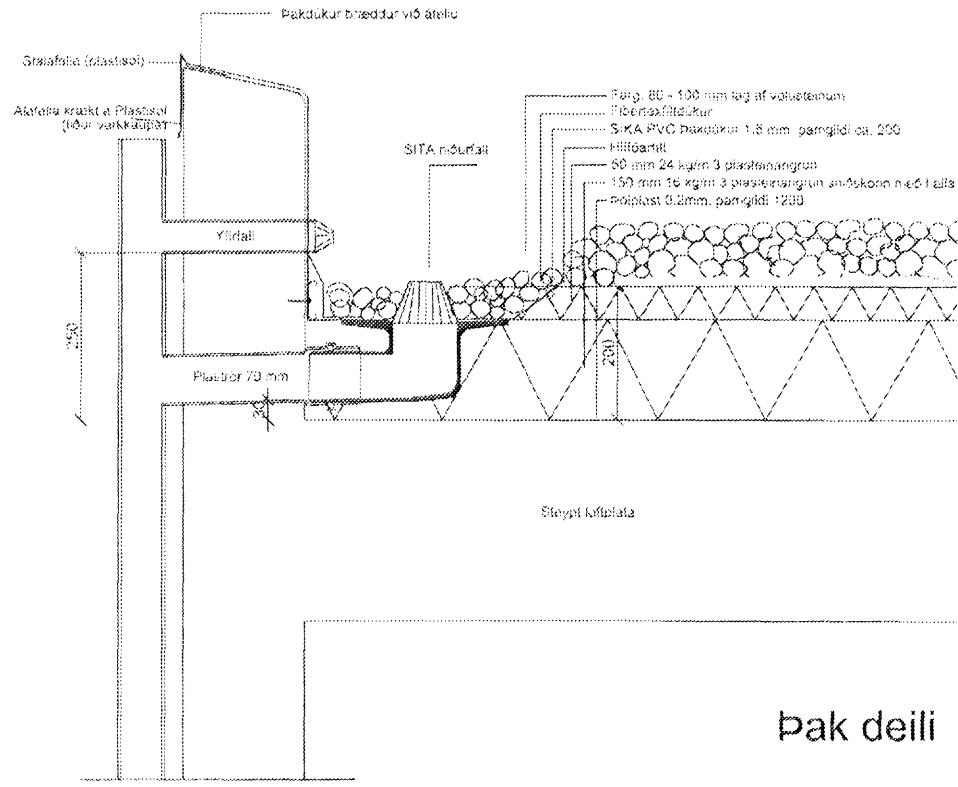

DAGS	Breytingar
18.01.2006	Sérnotareitur, laikir, flái

Þólf