

R=4,0
B=2,14
G-25.13
G-24.98
R=18,0
B=5,61
G-24.93

B=18,14
R=102,75

7,32 m
G-25.33
F:626,23 m²

11 m
G-25.38
F:324,5 m²

11 m
G-25.45
F:325,5 m²

15 m
G-25.51
F:524,7 m²

R=2,0
B=3,14
G-25.55
G-25.41

DREKAVELLIR


23,75 m

R=5,50
B=4,23

R=15,50
B=6,80

R=110,50
B=20,52

R=2,0
B=3,51

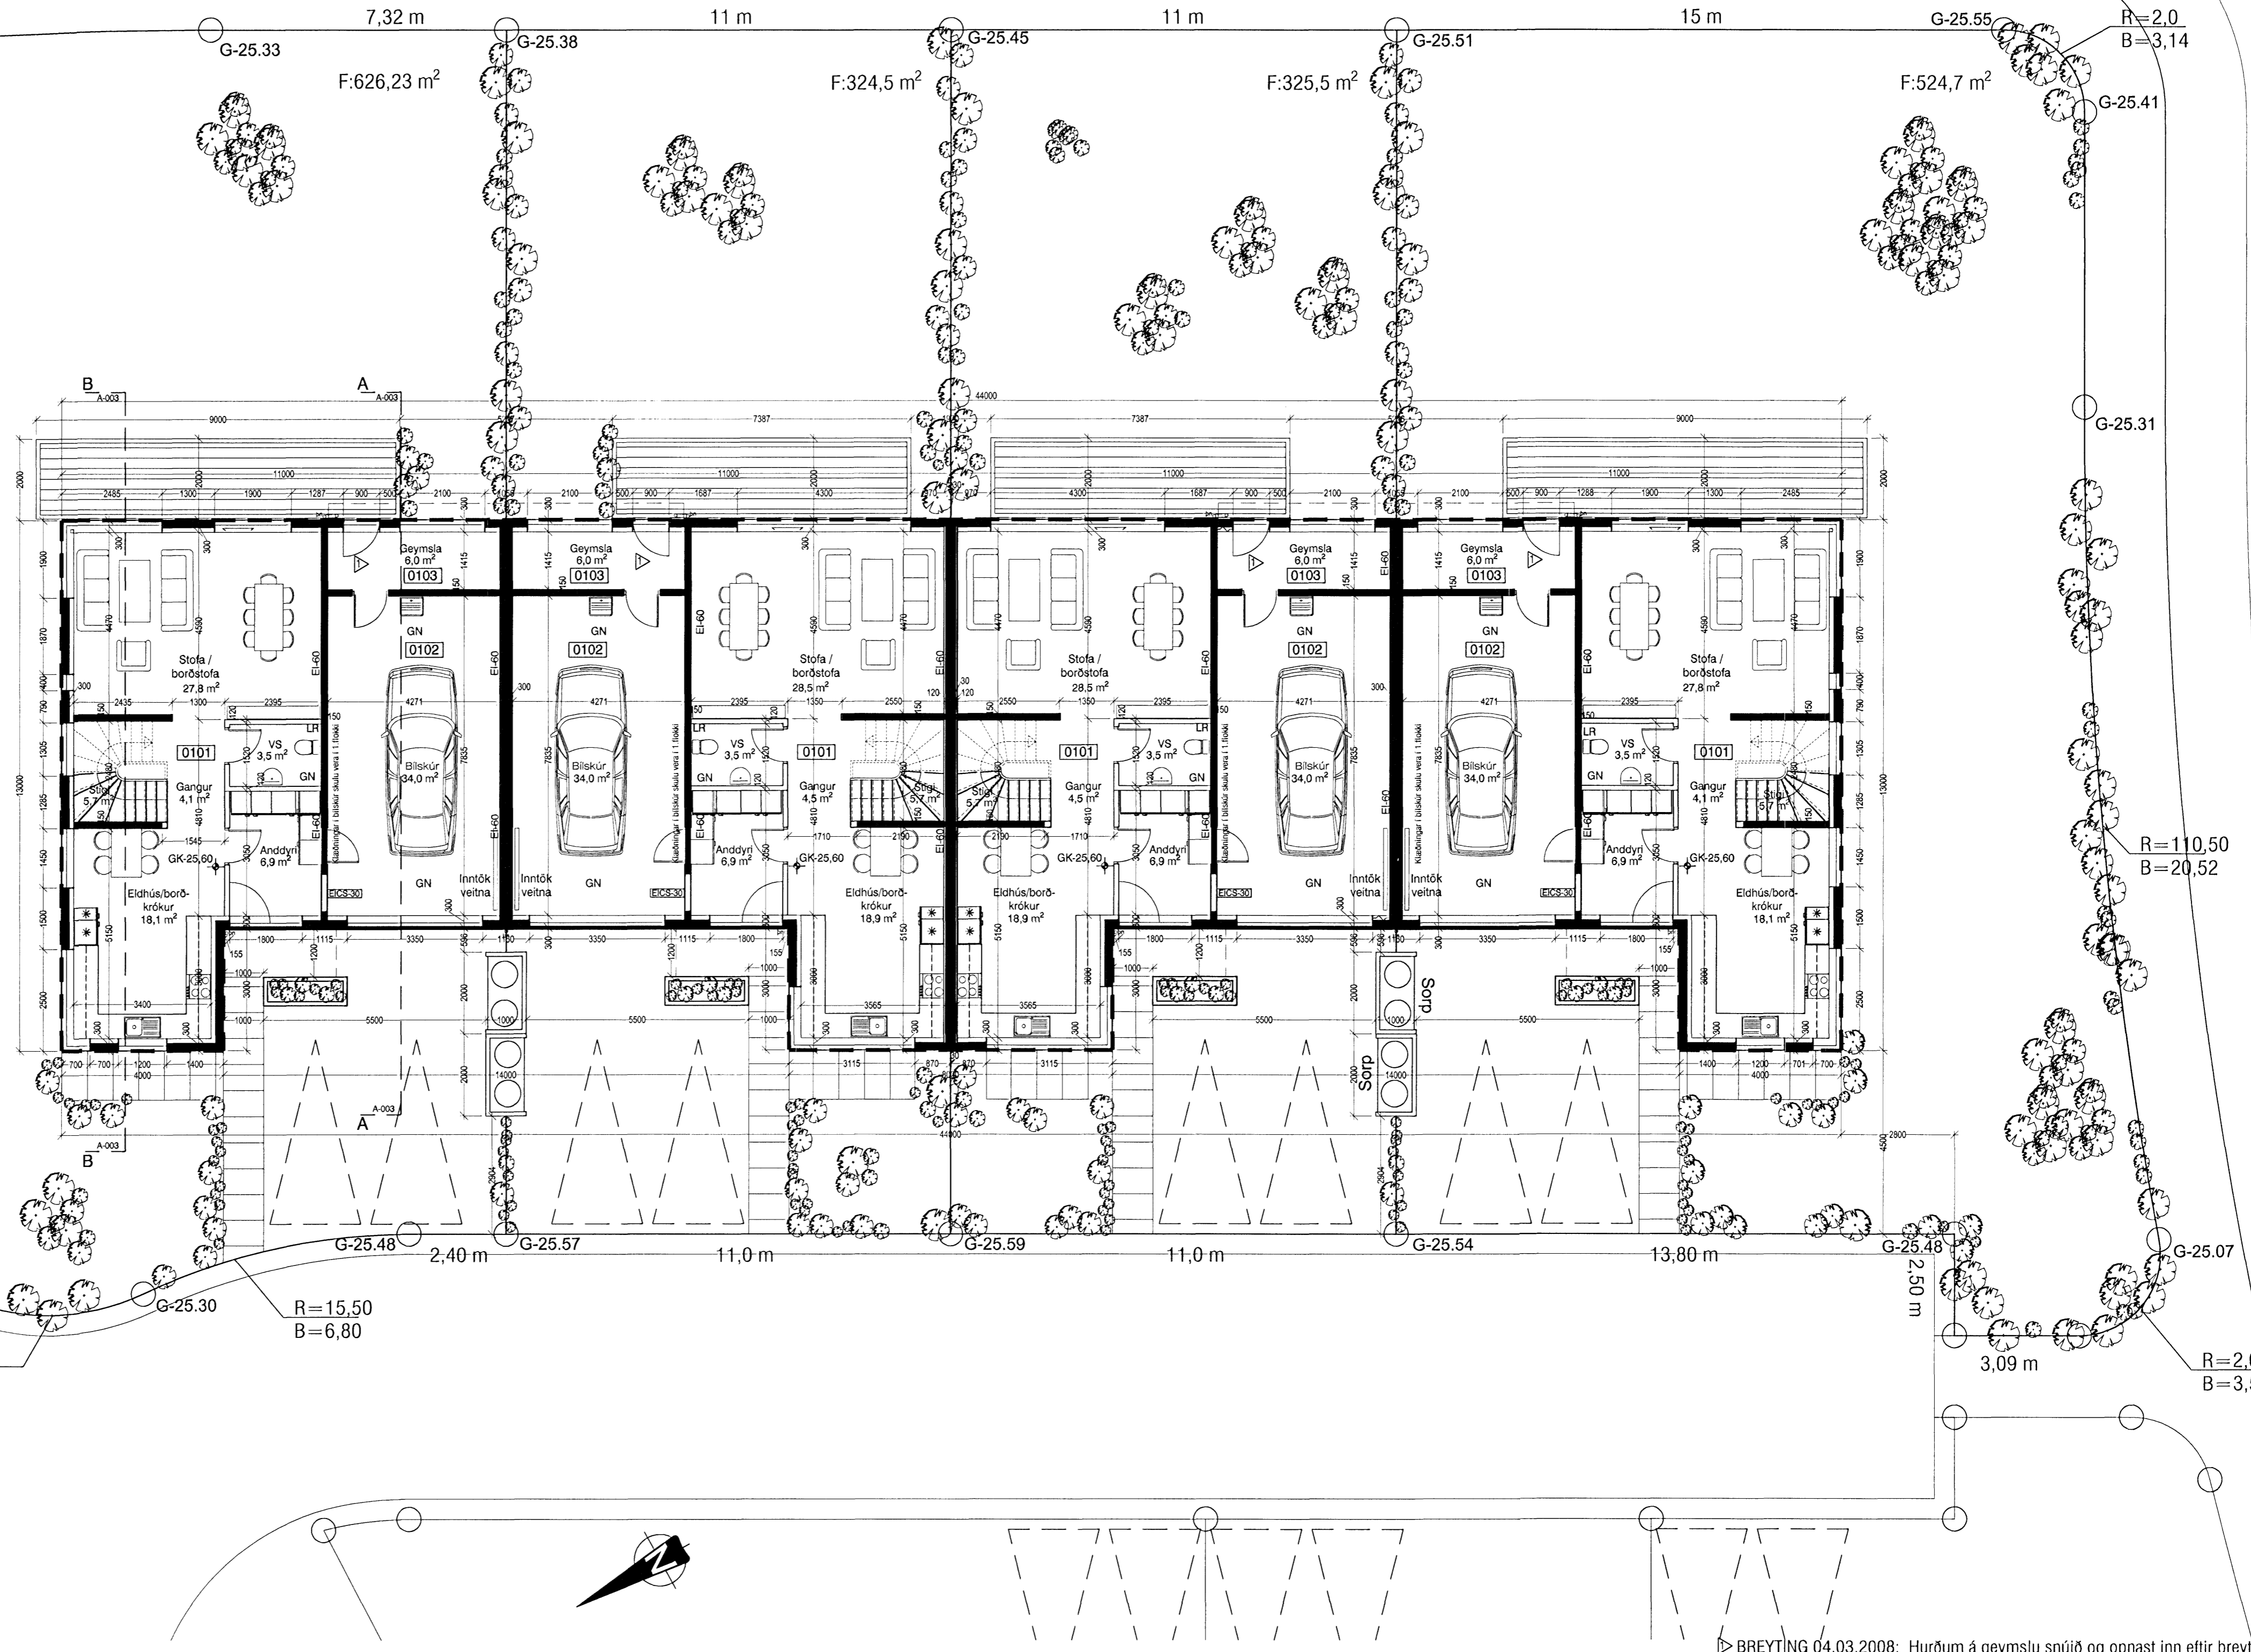

BREYTING 04.03.2008: Hurðum á geymslu snúð og opnast inn eftir breytingu, opnuðust áður út.

VEKTOR -hönnun og ráðgjöf - Akralind 6, 201 Kópavogi.		Jón Hrafn Hildúvesson byggingarfræðingur KÍ 255982-8519 Sími 554-6660 Fax 554-6669	
Tökn. nr. _____ Samþykkt _____		St. _____ Dags _____	
Hönnuð JHH		Teiknað BH	
Dagsetning 11.12.2006		Málkvarth. 1:100	
Vrk.nr. A-06-12-65		Tökn.nr. A-002	

DREKAVELLIR 54 - 60; Hafnarfirði
BYGGINGARNEFNDAR TEIKNINGAR
Grunnmynd 1. hæðar