
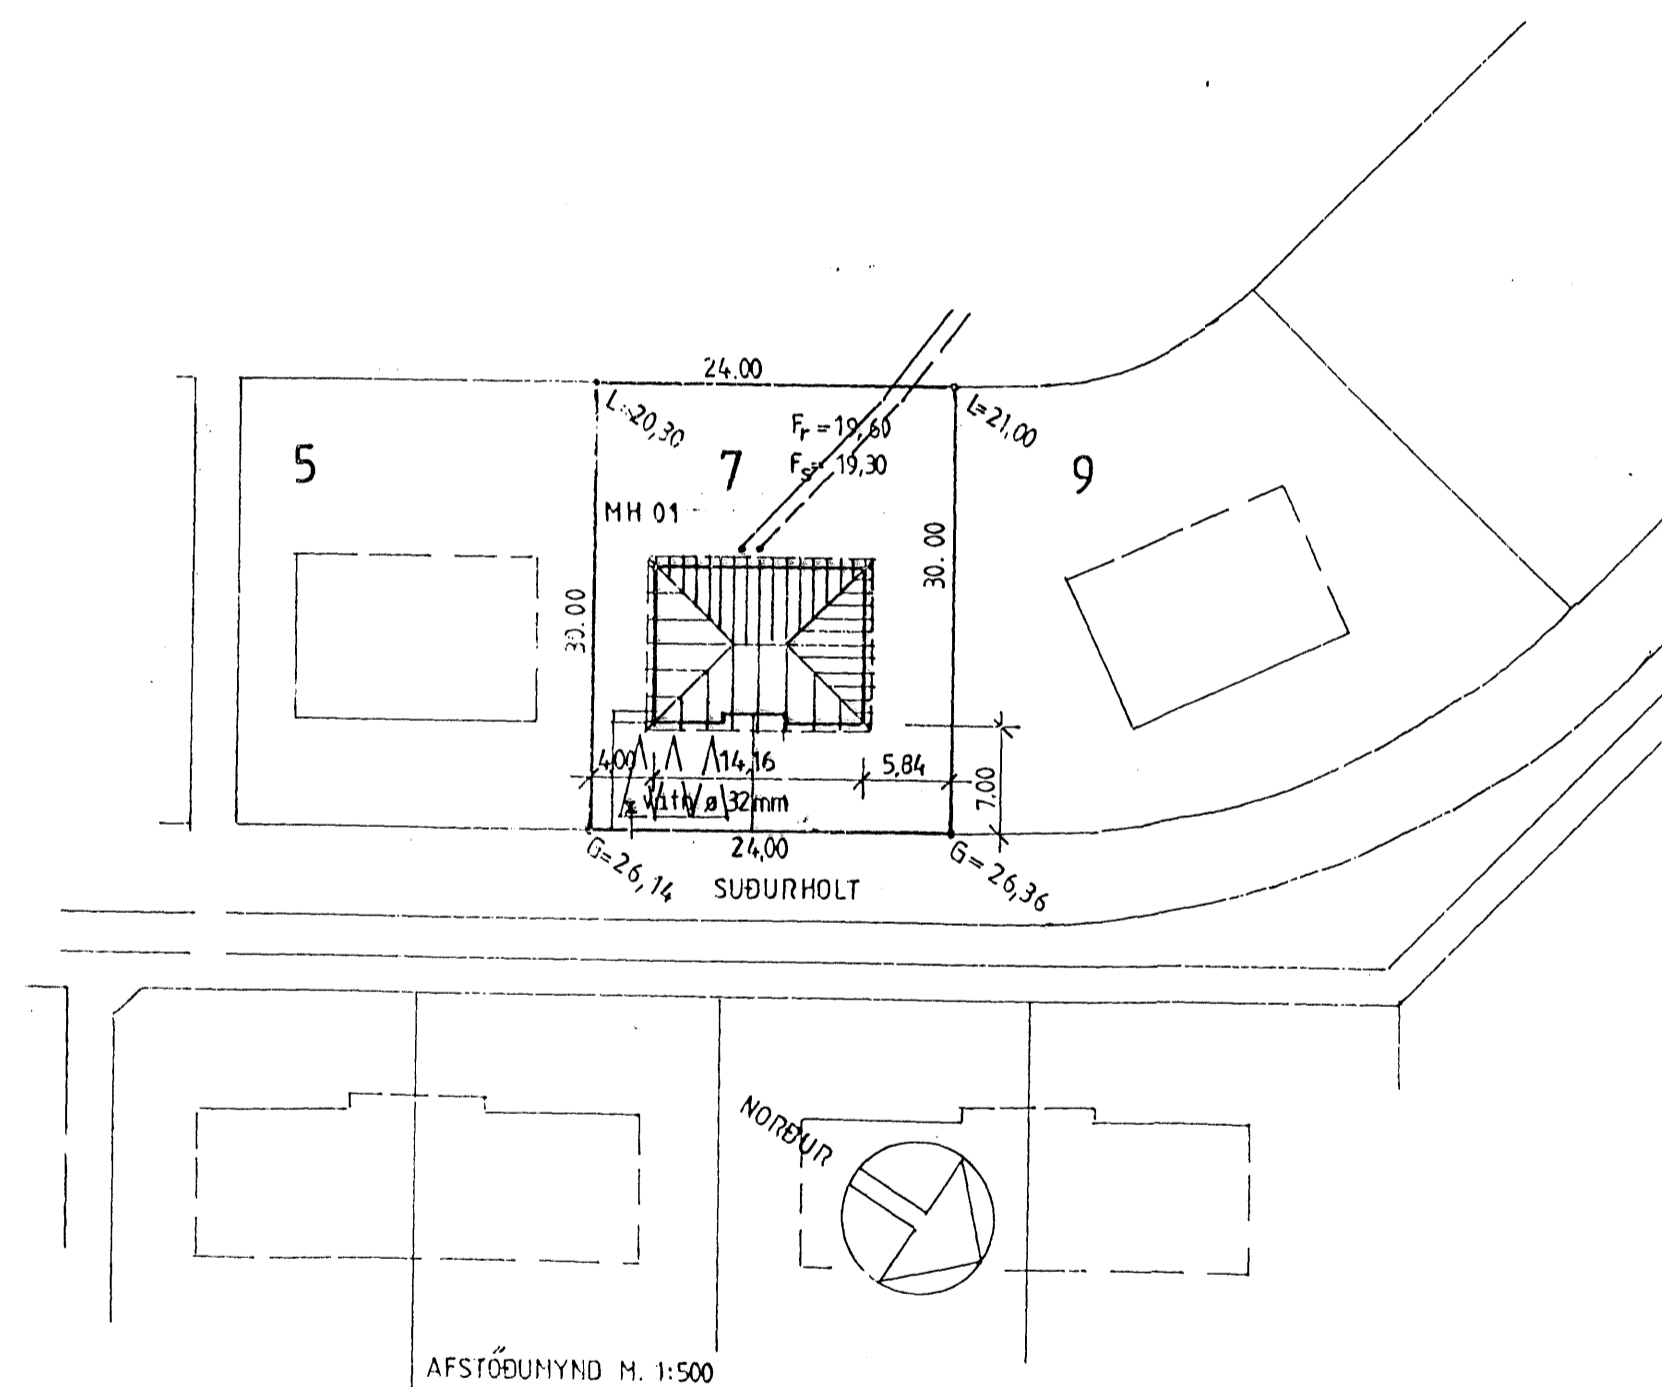


Samþykkt þann

19 MAR 2008

Byggingafulltrúin H. Hafnarfirði
F.H. Jón Sigurðsson

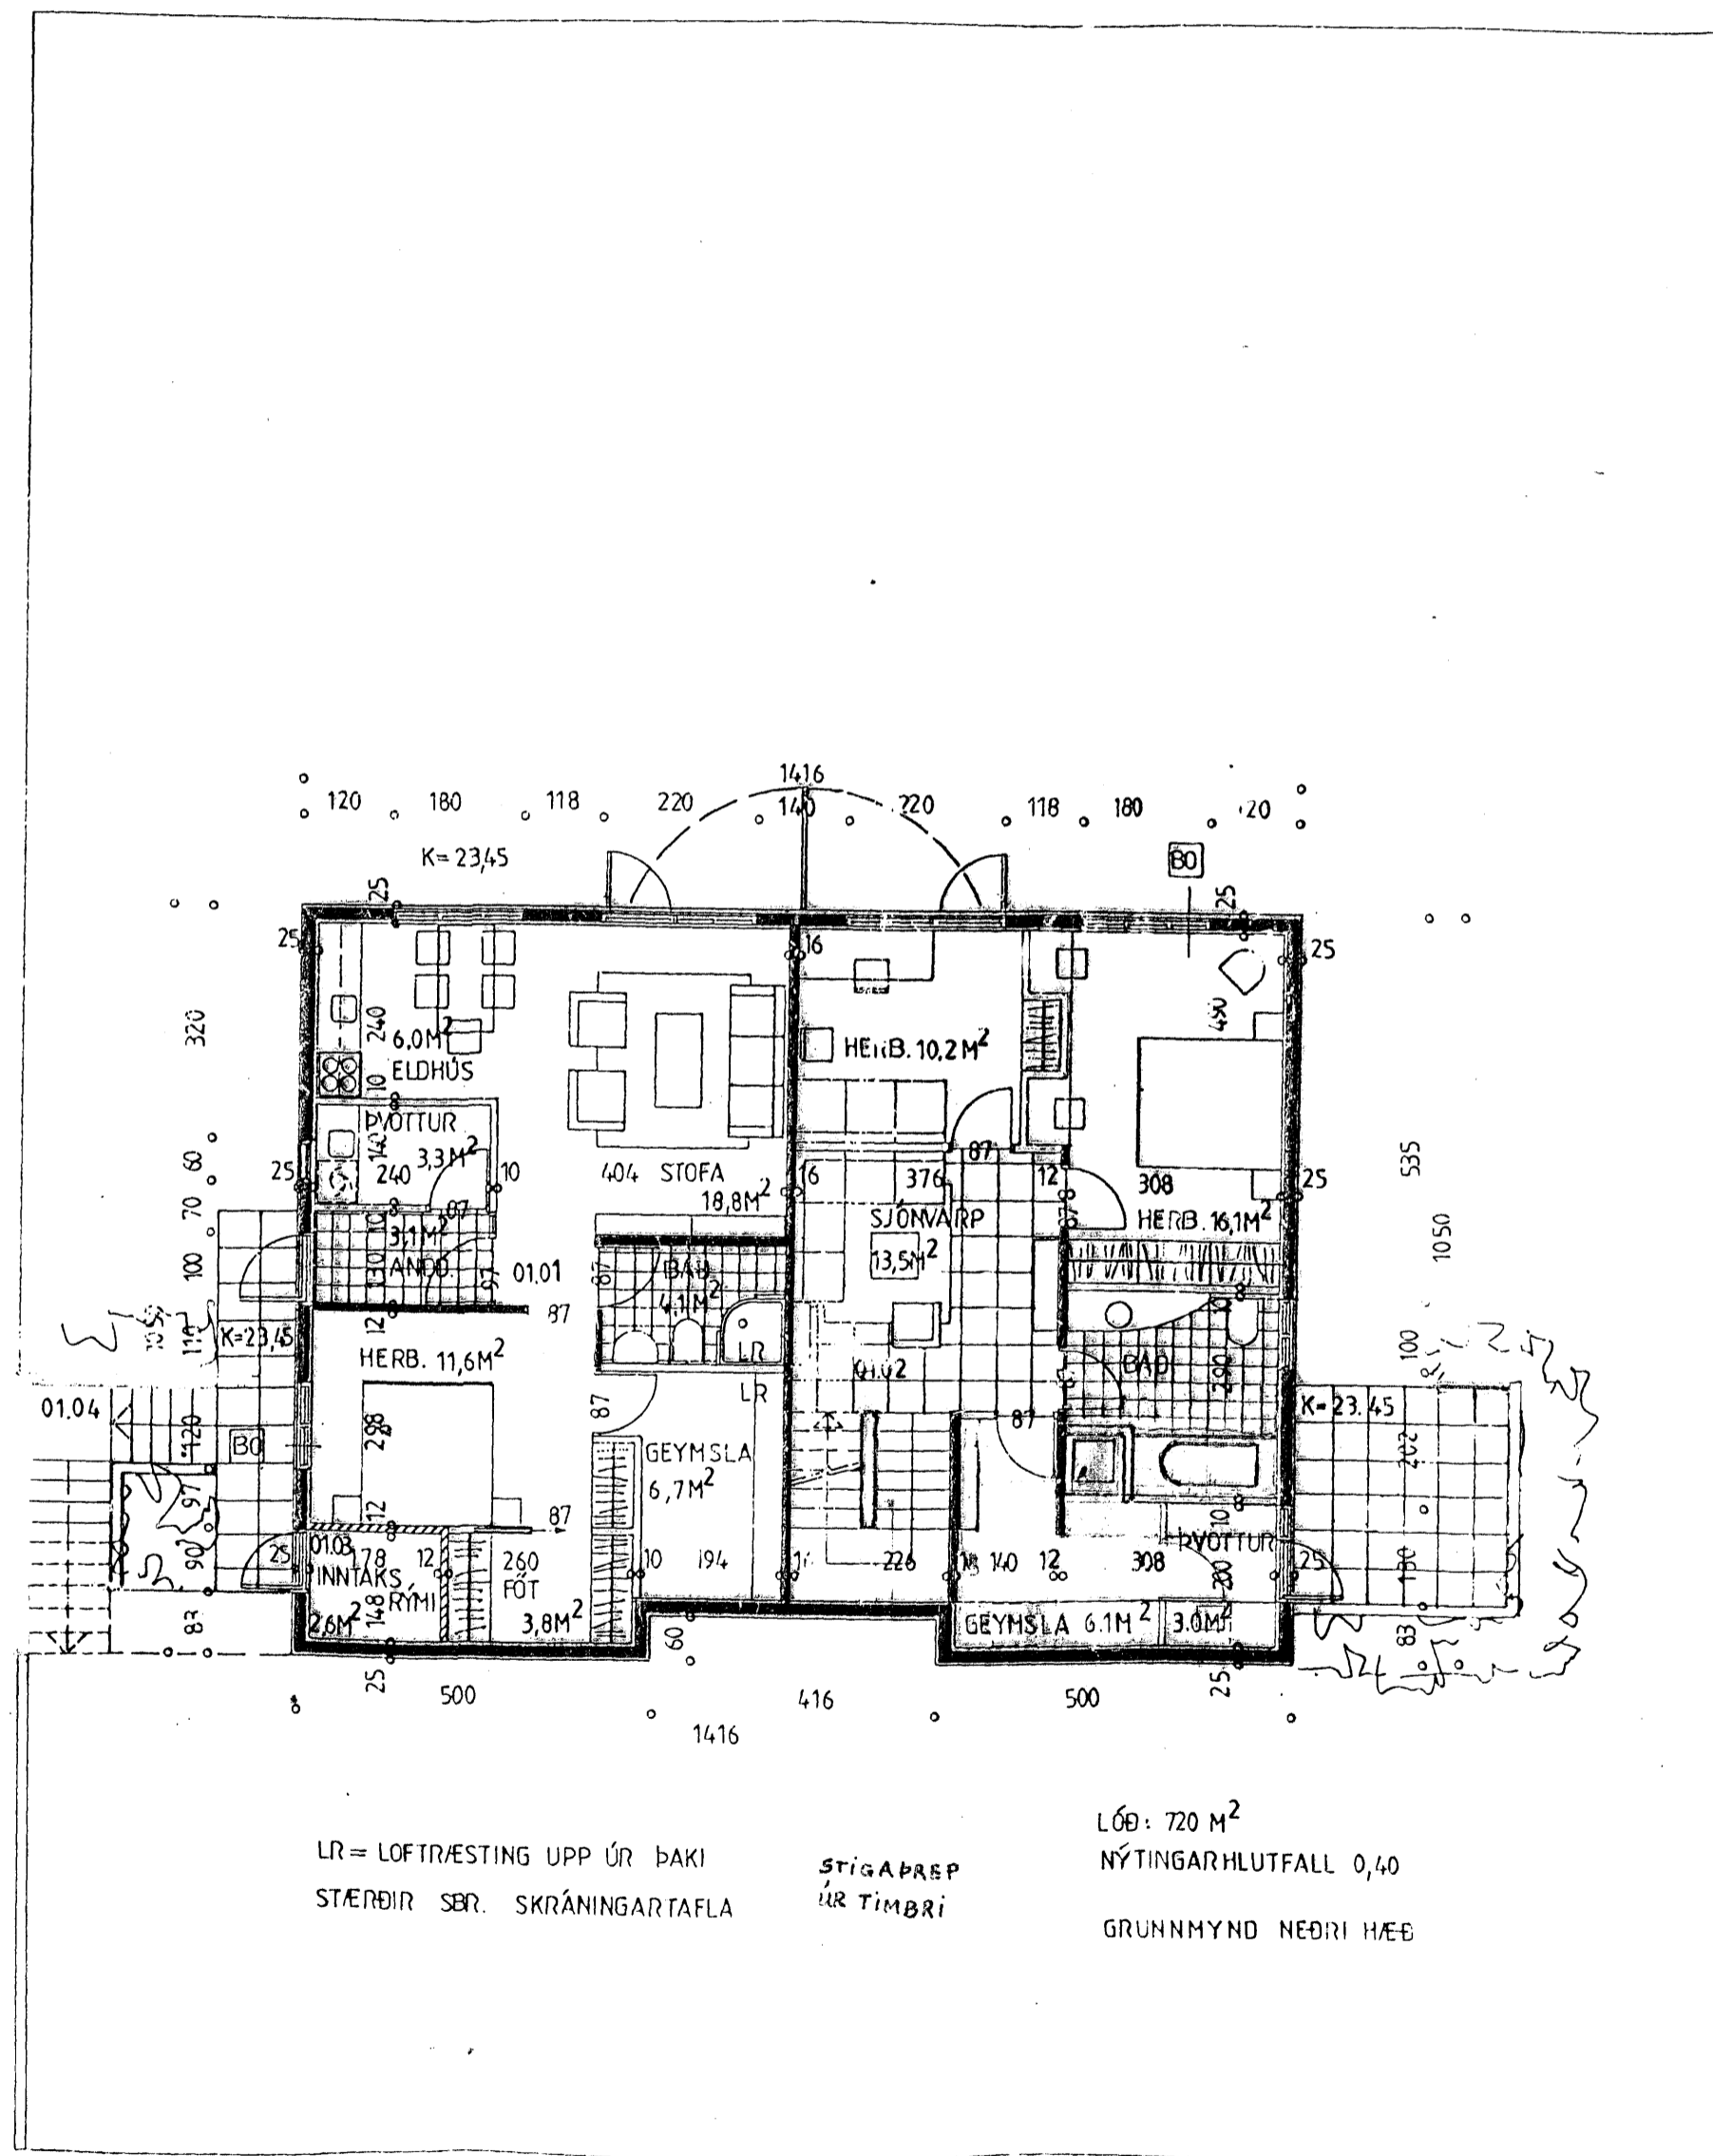

SUÐURHOLT 7, HAFNARFIRÐI
GRUNNMYND NEDRI HÆÐ OG AFSTÖÐUMYND
20.03.2000 MKV. 1:100, 1:500
BR. 20.03.2008 BAE JP/SS
Jóhannes Pétursson 010448-3959 S-567-5107
Sigurður Sigurðsson 021146-2349 S-566-6617

ABS teiknistofa S-566-6613, 567-5107 Nr. 1