
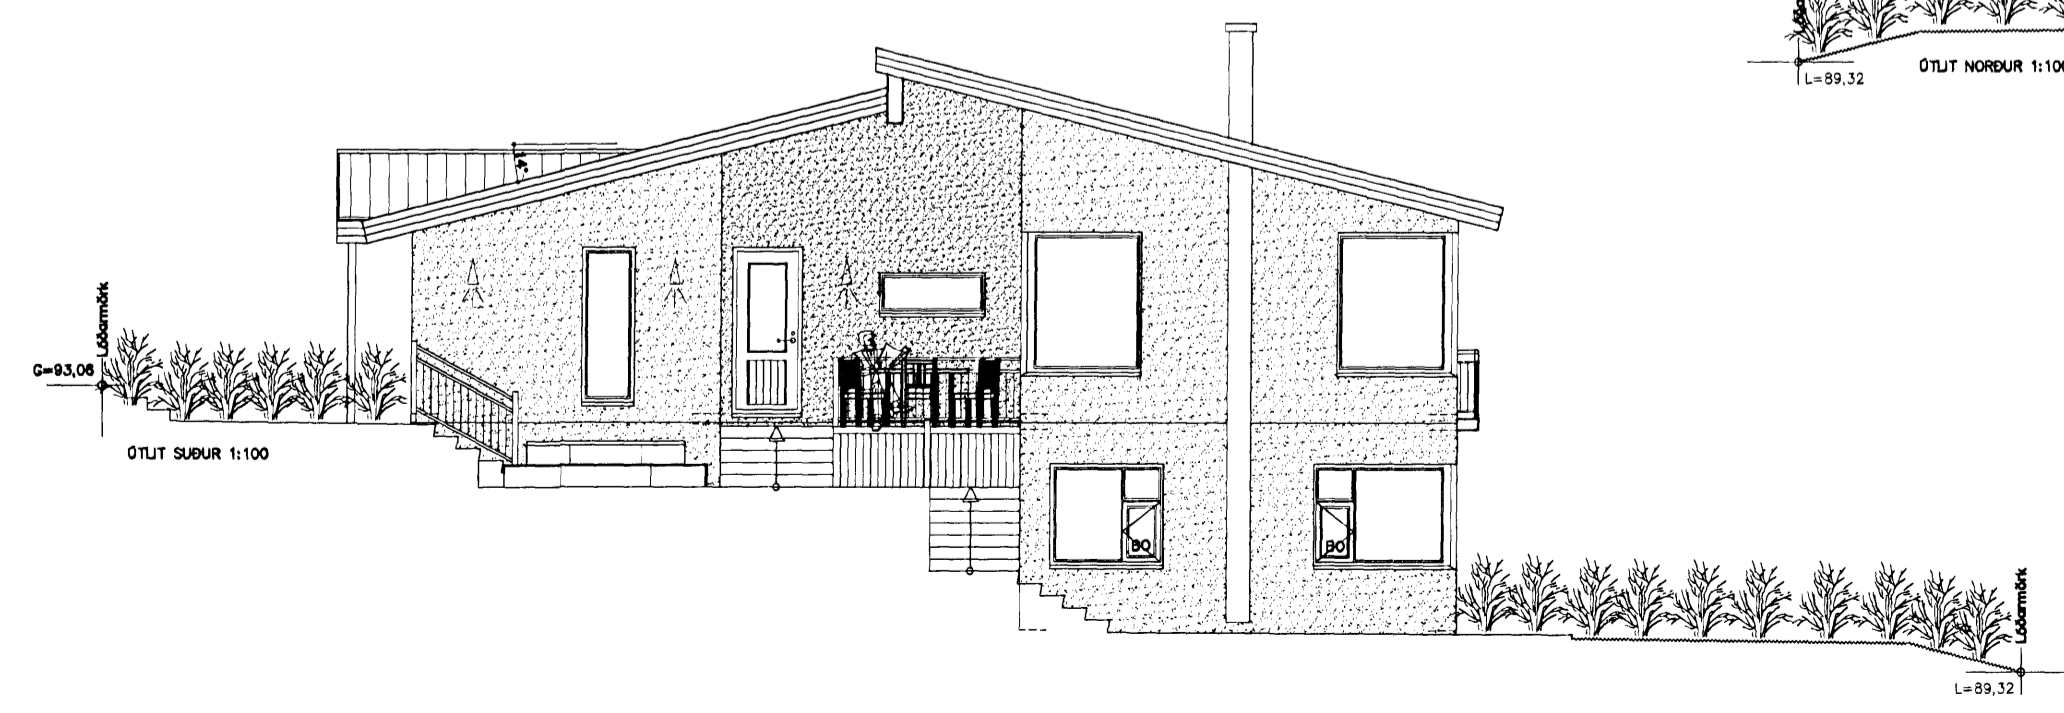
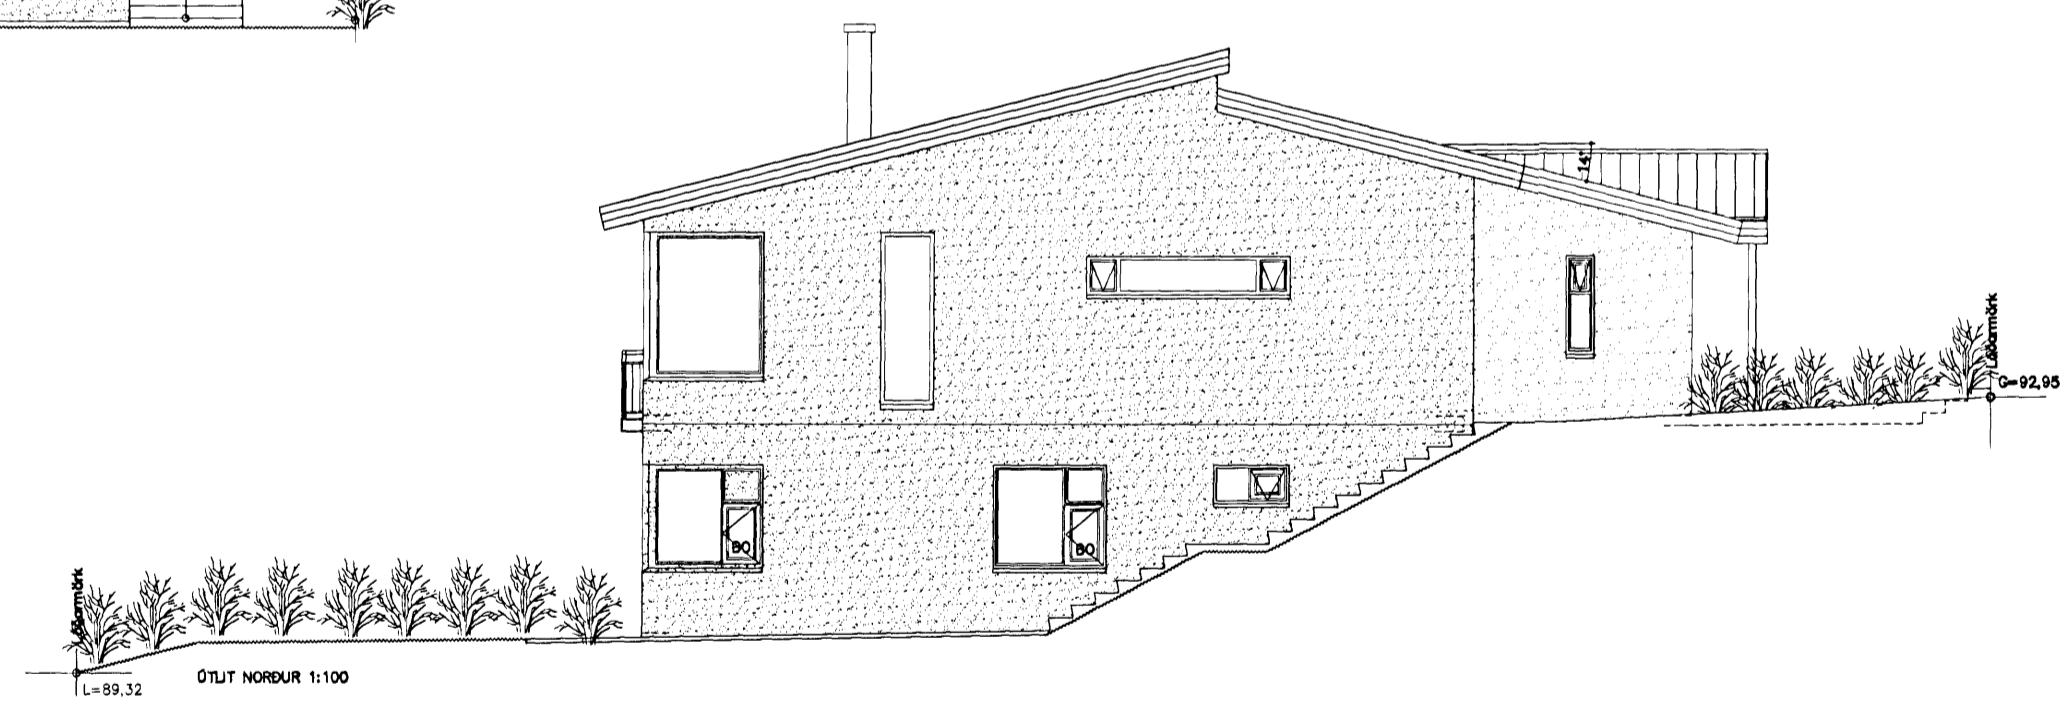


Samþykkt þann

12 MAR 2008

Byggingafr. & Hafnarfr. F.h. Jón Sigurðsson

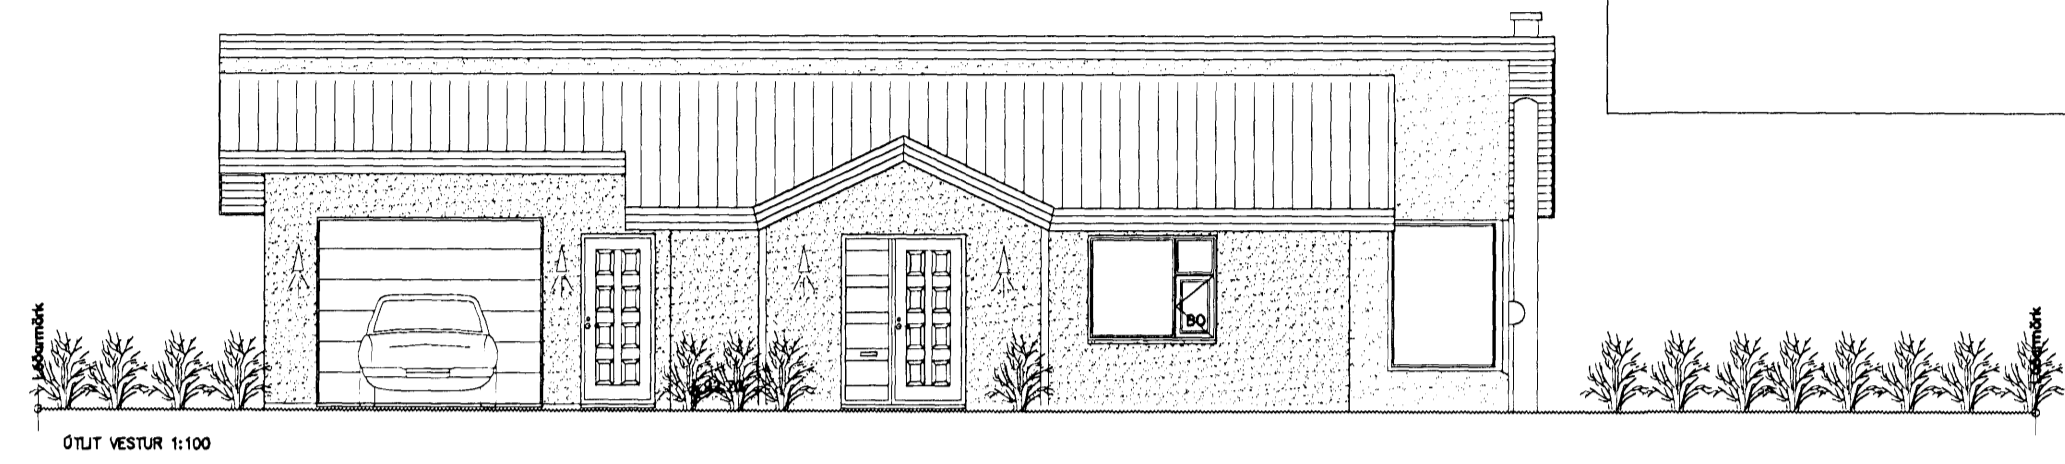

1\* = gluggum í stofu, eldhúsi og sjonvarphöll á 1.h. eru hækkaðir frá gólf.

<b>Ónyx ehf</b>		Brynjar Danielsson Byggingafr. Skjólslum 9 201 Kópavogi Sími. 861 5655 Fax. 587 2610 Netfang. onyx@simnet.is	
nr.	Breyting.	af dags	VERKEFNI
1	1*	BD 23.02.07	<b>BREKKUÁS 27 HF</b>
2			DAGS. Nóv 06
3			TEIKNAD AF. BRYNJAR
4			TEIKN nr.
5			<b>A102</b>
6			YFIRFARIN OG SAMÞYKKT. <i>Brynjar</i> Kt. 09.04.67-5229
7			MÆLIKVARÐI. 1:100
8			Óli mál & teikningunni eru í mm.

