


Byggingafultrúð Hefnafrjæðar
 06. SEPTEMBER 2005

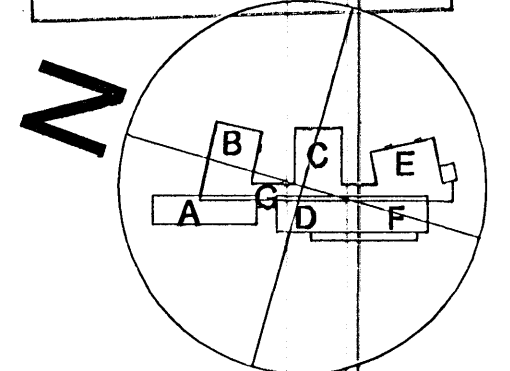

A 13.12.2005 - Tíðing 25.05.05, Mál og ummál
 SR GK2 05/12/05 REKX TEKX

á stofunni arkitektar
 Bergslausástræð 10. Rvk. Sími 551 1400. Stofna@stofnun.is

Finnur Björgvinsson, arkitekt FAI	KT: 190949-3069
Hilmar Þór Björnsson, arkitekt FAI	KT: 290845-3109
Sigríður Ólafsdóttir, arkitekt FAI	KT: 071070-5069
DREKAVELLIR 9 HRAUNVALLASKÓLI 1. KFANGI SNID GG	HNNA/TEKH: 08-950 ARK: 5484-1007 ST: 660509-1299
SKAÐAÐ 1:50	REYLA/TEK: 31.05.2004
05-01	A-VS-004