


GRUNNMÝND 1. HÆÐAR 1:50

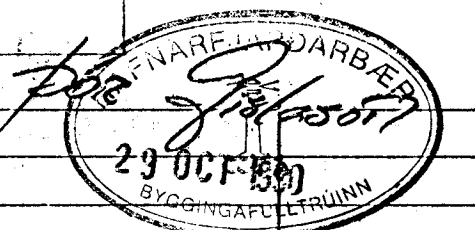

BR. NR.	DAGS	EDLI BREVTINGAR	SIGN.
			DAGS OCT 90
BRATTHOLT 3 HAFNARFIRDI			HANNA
HITA - VATNS OG FRÁRENNISLAGNIR			TEIKNAR 3/4
GRUNNMÝND 1. HÆÐAR.			VERK NR. 9036
MELIKV. 1:50			BLAD NR. 2-05
SIGURÐUR ÞORLEIFSSON TEKNIFRÆÐINGUR F. 1071.			
STRANDGÖTU 11 HAFNARFIRDI SÍMI 54751/54255			