


Grunnmynd 2. hæð, mkv.1:100.

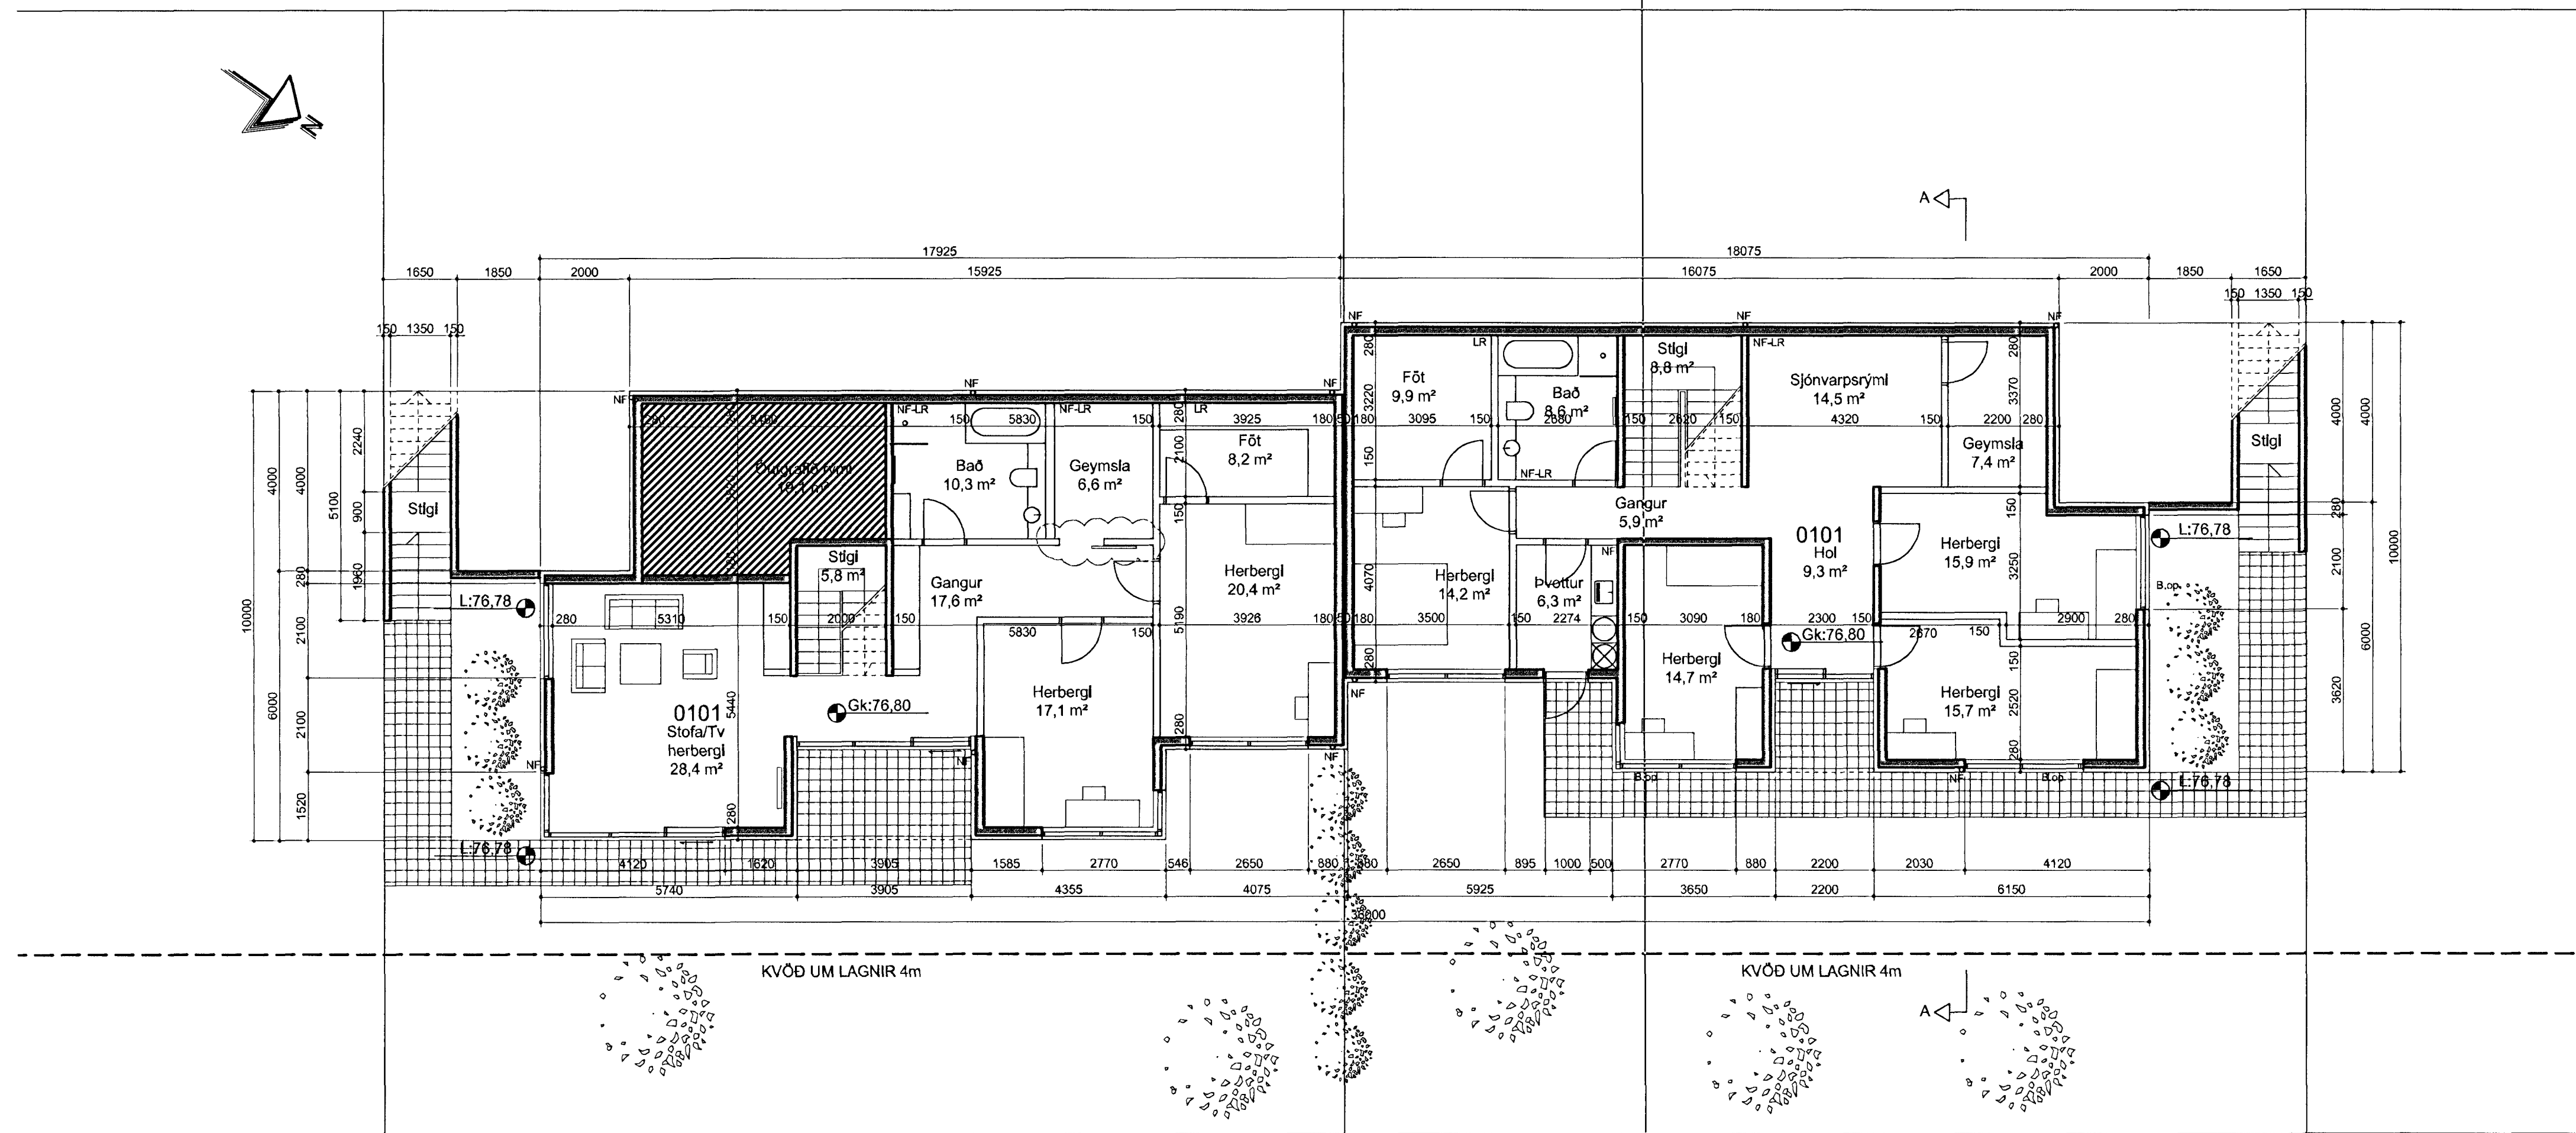

Grunnmynd 1. hæð, mkv.1:100.


BREYTINGAR.

VERKHEITI  
Furuás 12 og 14  
Parhús  
Hafnarfirði

VERK  
Grunnmyndir hæða

MÁL:  
1:100 / A1  
HANNAD:  
HE  
YRISFARND:  
ISC

DAGS.:  
11.07.2012  
TEIKNAD:  
HE  
VERKNGMÉR SVÆÐI FL TEIKNINGAMÉR ÖTG  
751-492 04 1.02

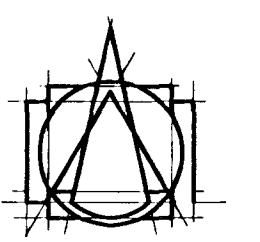

T.ark

TEIKNISTOFAN ARKITEKTAR ehf  
BRAUTARHOLTÍ 6 - 105 REYKJAVÍK - ÍSLAND  
Sími: 540 5700 - FAX: 540 5701  
teiknistofan@tark.is - www.tark.is