





Samþykkt þann

16 APR 2008

Byggingaféltriúinn / Hafnarfirði
F.h. Jón Sigurðsson

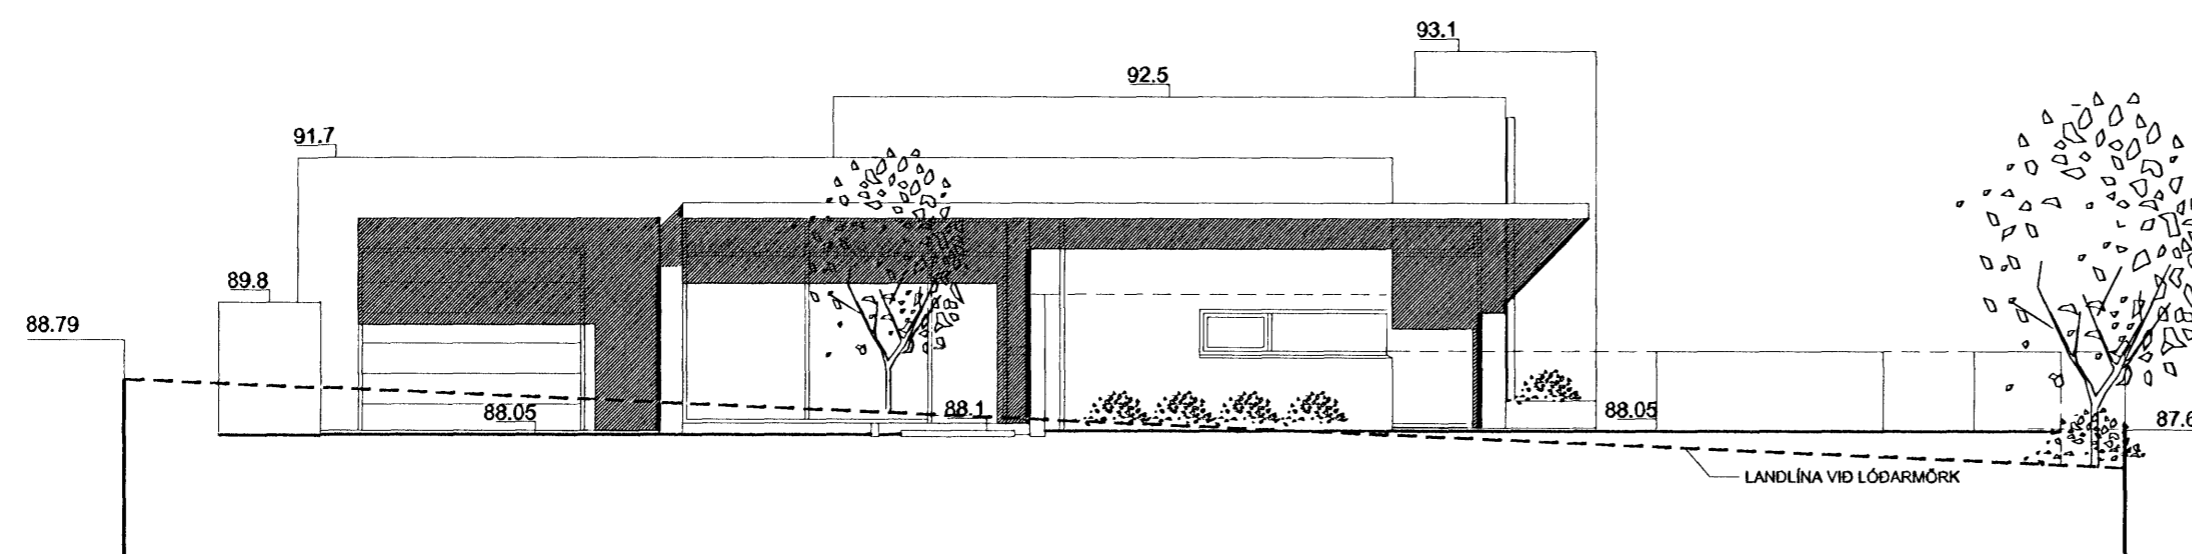

ÚTLIT TIL SUBVESTURS

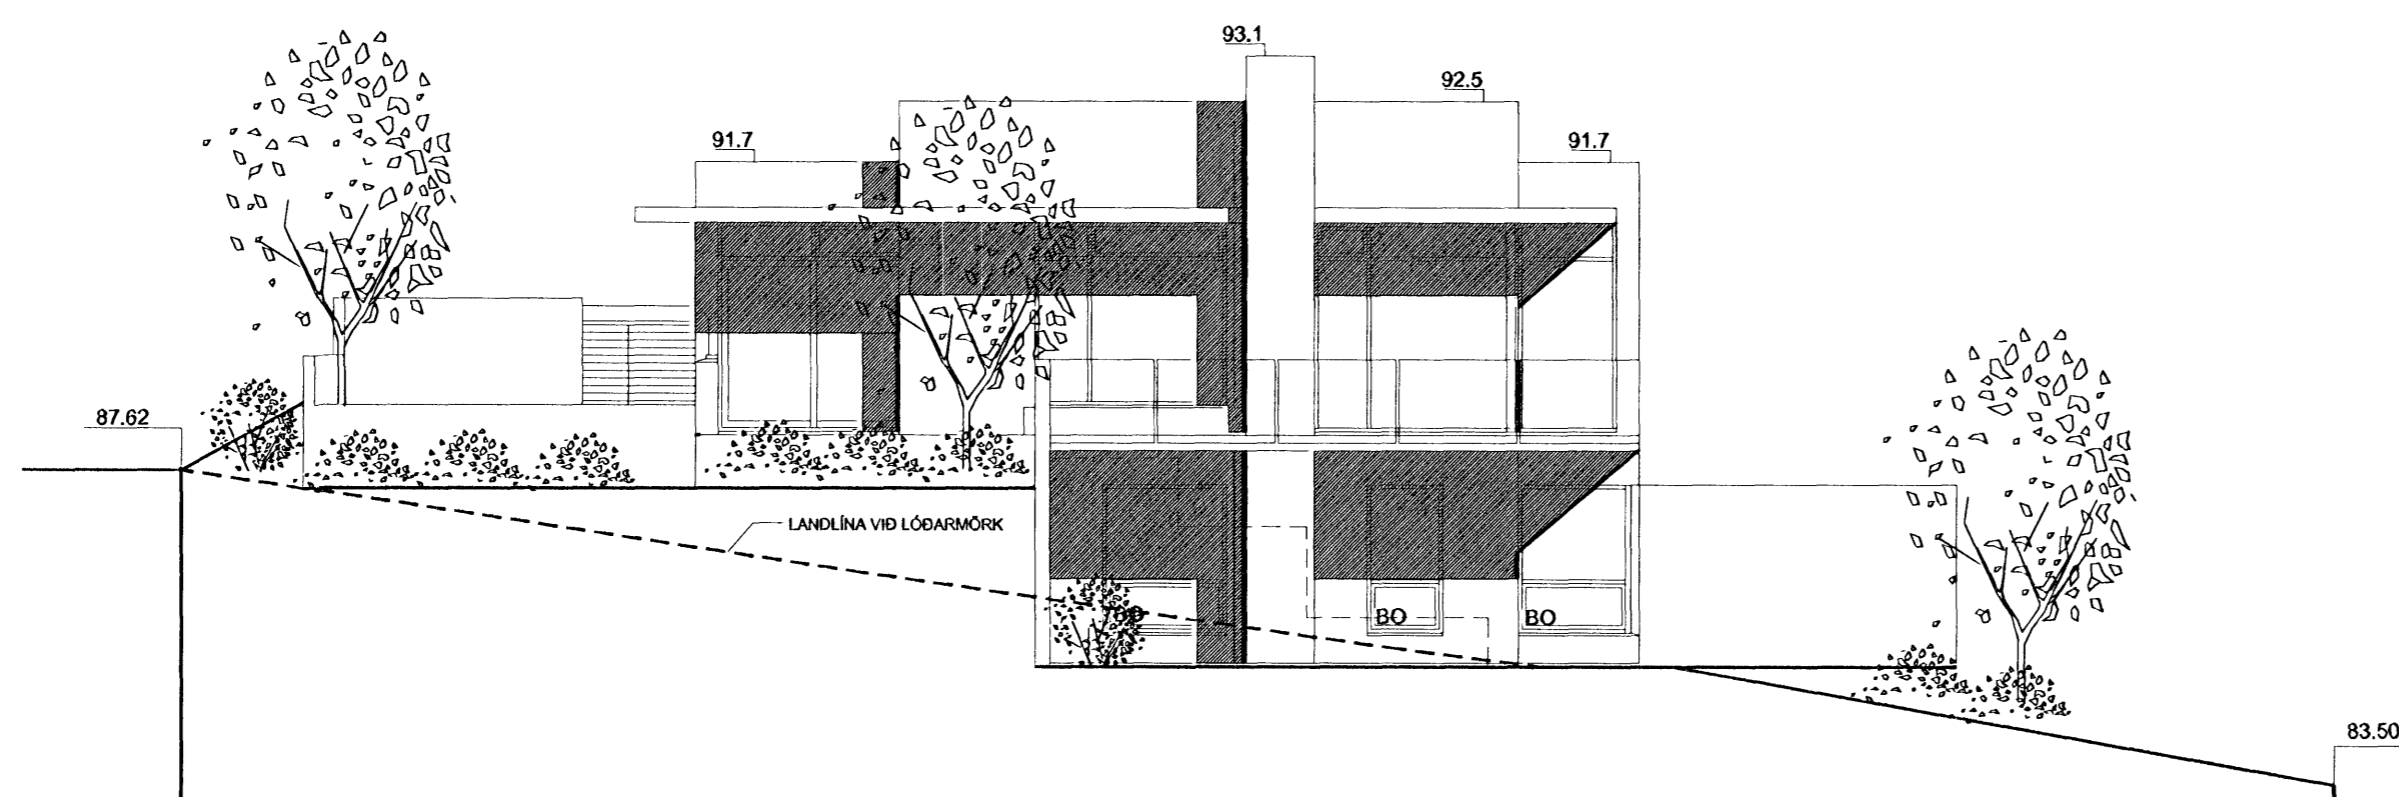

ÚTLIT TIL SUDAUSTURS

BREYTA	DAGSETNING	DAGSETNING
<p>Hlíðarás 4 Einbýlishús útlit REYNDARTEIKNING</p> <p><i>Sigríður Ólafsdóttir</i></p> <p>Sigríður Ólafsdóttir - arkitekt FAI K: 071070 5069 Hukla Adalsteinsd. - innanhússarkitekti K: 141074 4909</p> <p>STUDIO STRIK ARKITEKTAR Laugavegi 3 101 Reykjavík S: 511 6777 studio@strik.is K: 590907 1030</p>		
DAGSETNING: 10.4.2008	TEKNIKAUF: SÓ	KVAÐI: 1:100
VERK NÚMÉR: 2007-10-12	TEKNIKA NÚMÉR: A-0.004	BREYTA: