

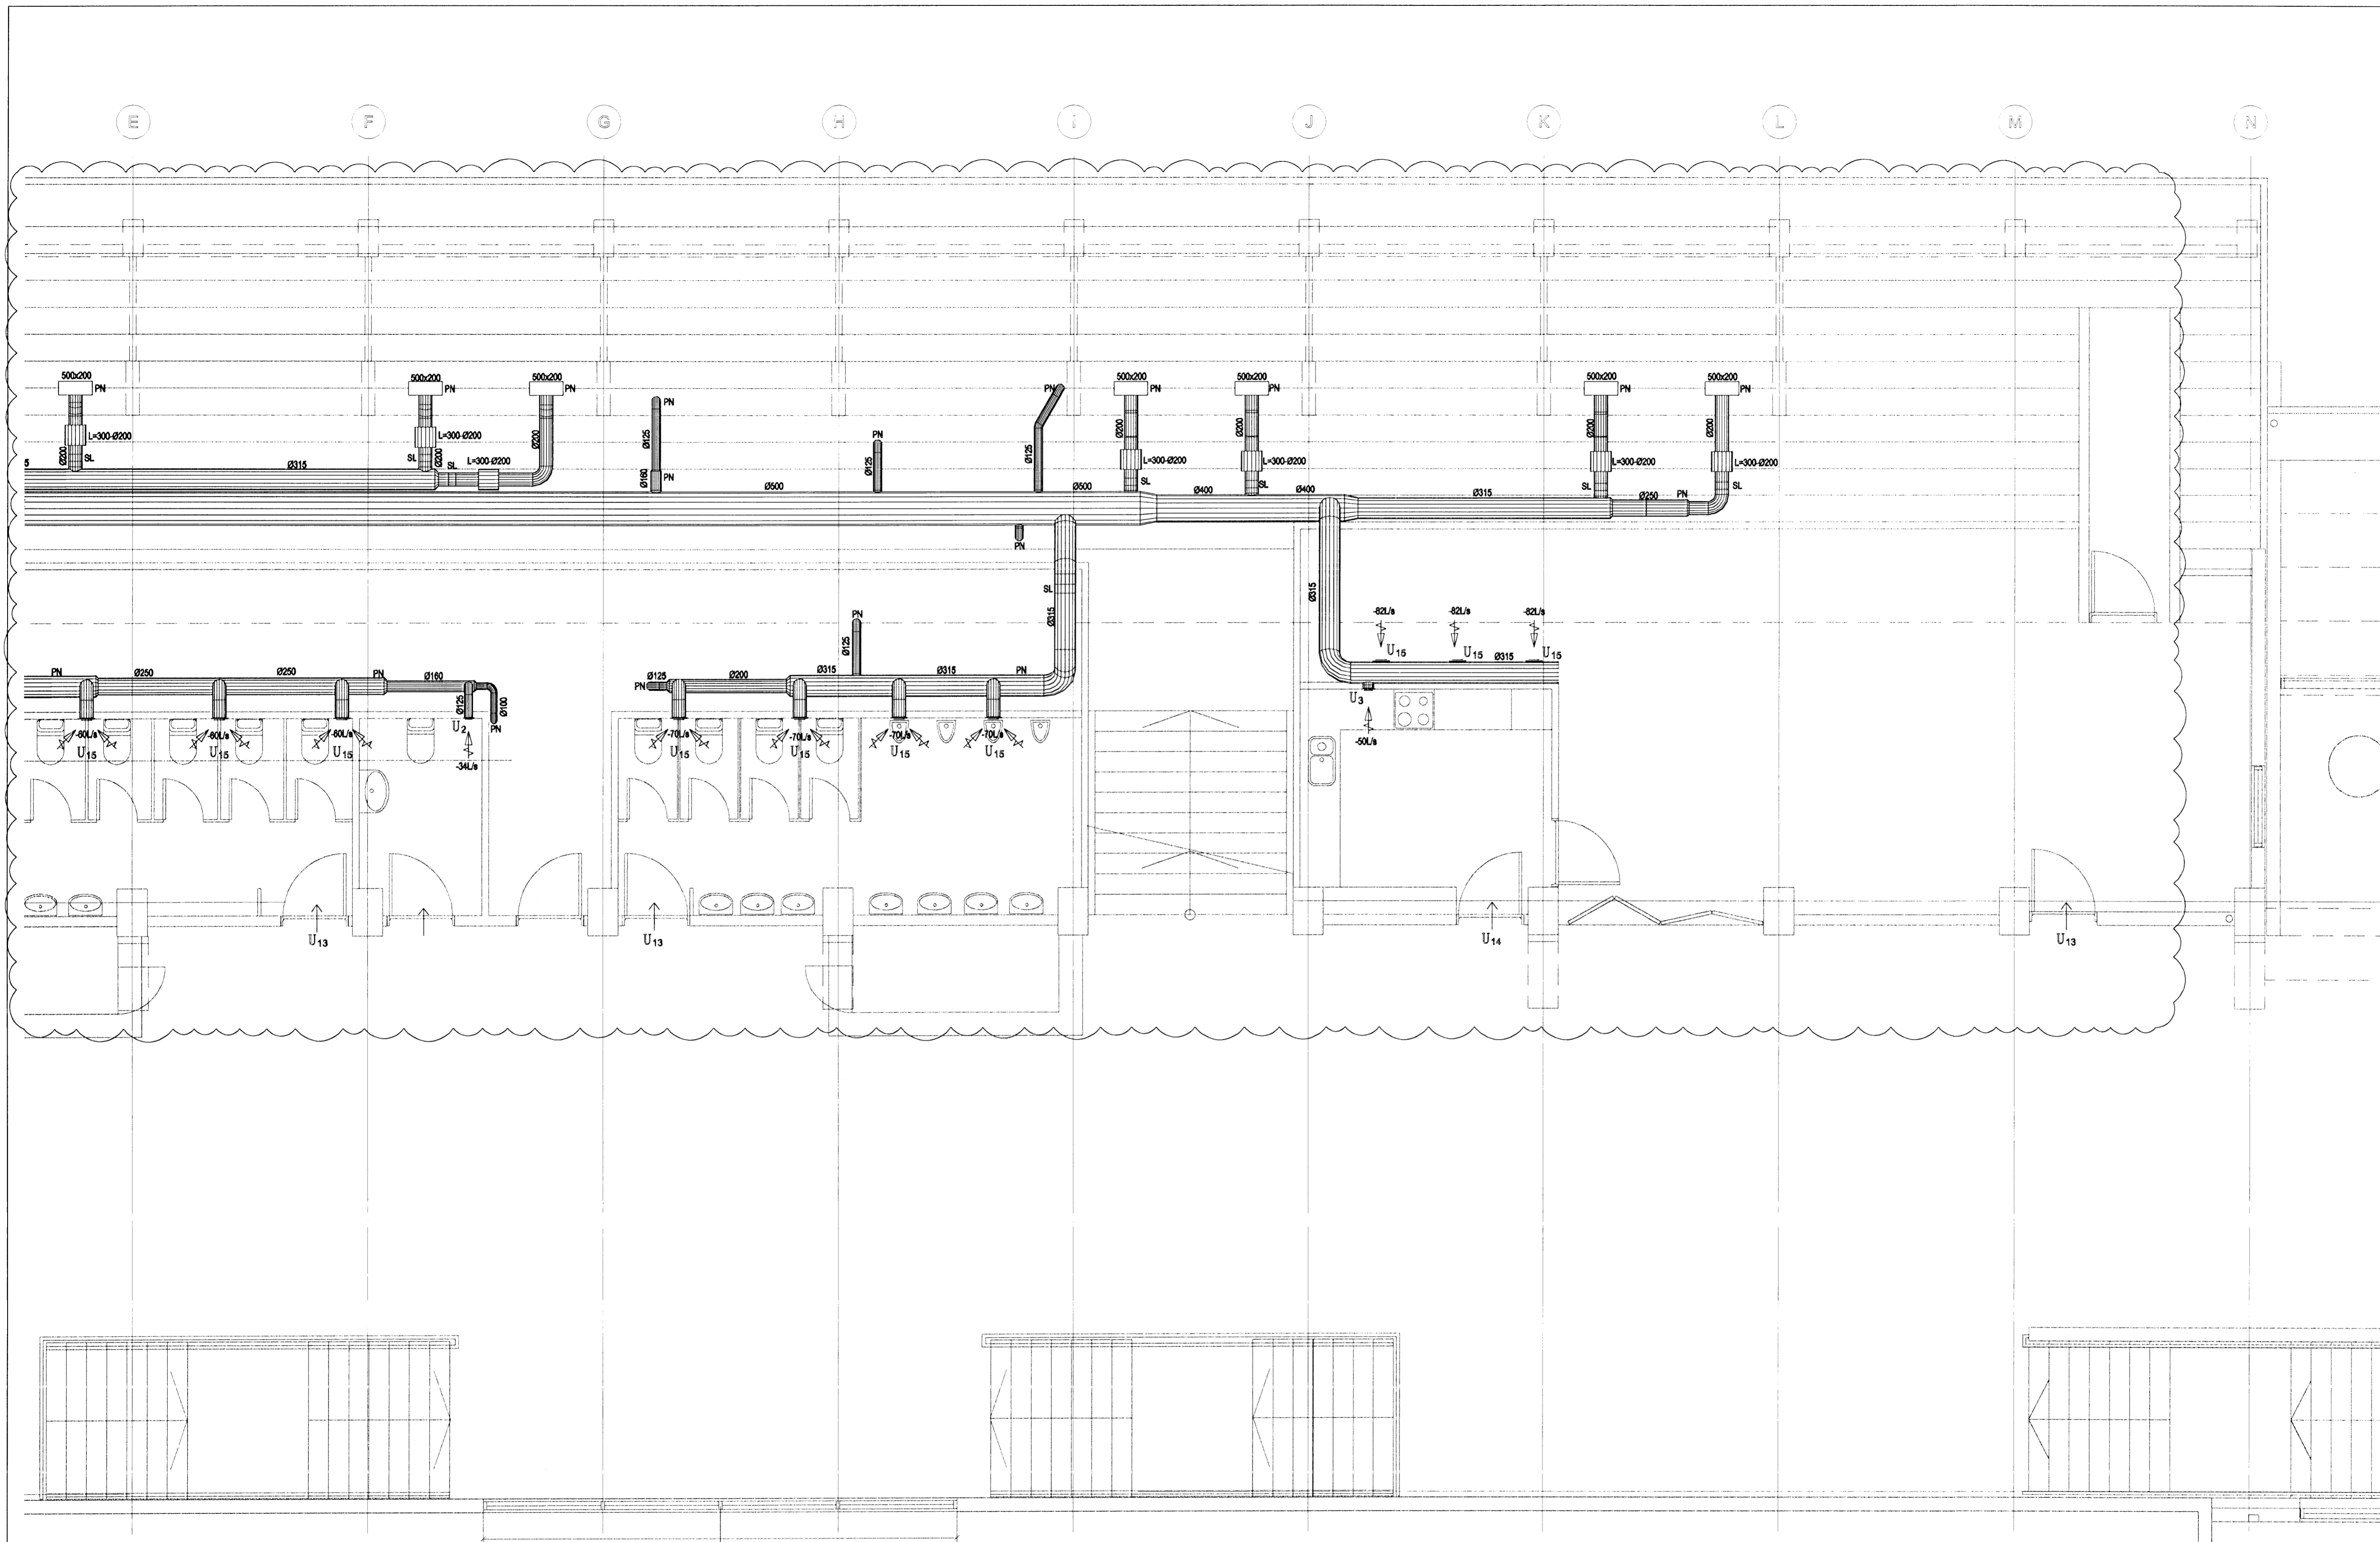


Samþykkt þann
 24 JUNI 2008
 Byggingarfulltrúinn í Hafnarfirði
 P.h. Hrólfur S. Gunnlaugsson

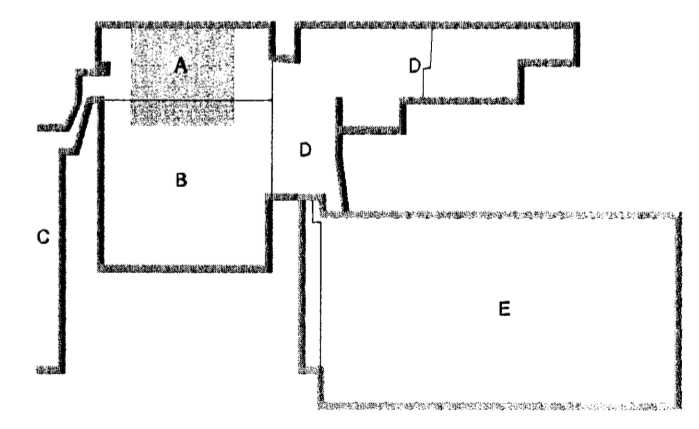

H. Gunnlaugsson
 Kr. 110457-2789

KAPLAKRIKI

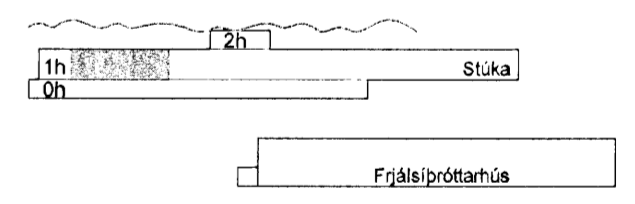

B 03.08.08 Loftræsing endurnýjuð JGR/SÁS
 A 23.11.07 Verkefning BS/SÁS
 Útg. Dags. Skýring Hannadýrfrífarð



VERKFRÆÐISTOFA

DEJARIHRAUN 20 · 220 HAFNARFJÖRÐUR · KENNIT. 710796-2899
 vsb@vab.is Sími 585 8600 · Fax 585 8610 www.vsb.is

Aritun sérhönnuðar Sveinn Áki Sverrisson Kt. 230855 5809

KAPLAKRIKI
 HAFNARFIRÐI

Verkhúsi
 Loftræsing
 Grunnmynd 1. hæðar

Hannad	Teiknað	Yfirfarð	Kvarði	Síða
BS	BS	SÁS	1:50	/ A1
Dags.	Verkefni	Teikning	Útgáfa	

00000881106811-Kaplakriki-FAS/Sheval.L008811-A.L1-1_hæð.dwg