
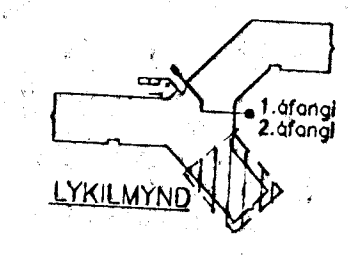


ÁSKILIÐ, ELÐRI
TEIKNING OGILD
24 MARS 1994

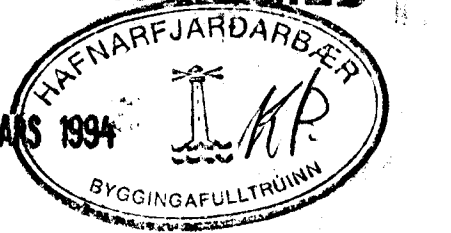

| | | |
|-------|----------|--------------|
| I | | |
| H | | |
| G | | |
| F | | |
| E | | |
| D | | |
| C | | |
| B | | |
| A | 8.3.94 | sk. skilríki |
| DAGS. | BREYTING | SAMP. |

HVALEYRARSKÓLI
HAFNARFIRÐI, 2. áfangi.
ALVERKTAKI:
FRIDJÓN OG VIDAR H.F.

EINAR EINARSSON TÆKNIFRÆÐINGUR, BREIDVANGUR 6
kennitala 1510504789, sími 650788
TEIKN.NR. 102 A
UNDIRSTÖÐUR OG KJALLARI
SUDAUSTURHLUTI
TEIKN.NR. EE
HANNAD EE
TEIKNAD EE
YFIRP.
SAMP. Einar Einarsson
SKV. 1:50 DAGS. JAN.1994