
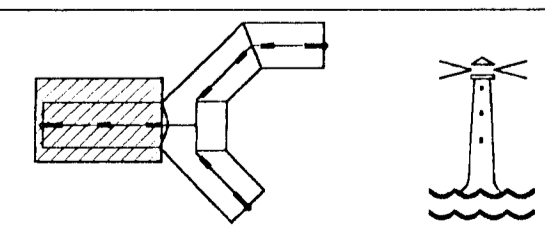


ÁSKILIÐ, ELDRI
TEIKNING ÓGILD

01 NOV. 1994

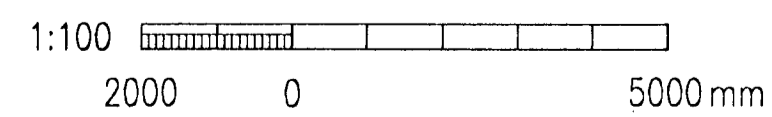

Teikn. nr.	Tilvisun á teikningu	Br.	Dags.	Eðli breytingar	Yf. Sp.
		B1	25.04.94	Tenging ofna.	AJM

AJM-Lagnahönnun
 Arnar J. Magnússon,
 Langumýri 26, 210 Garðabæ,
 s. 65 73 12 - fax. 65 73 12.

HVALEYRARSKÓLI, 2. ÁFANGI
 LAGNIR
 HITA- OG NEYSLUVATNSLAGNIR
 GRUNNMYND VESTURÁLMI

Handab.	Teiknab.	Dagsetning	Vera nr.	Teikn. nr.	Merkurab.
AJM	AJM	21.03.1994	94.01	2.15-B1	1:100